


This print is certified to be an exact copy of the original map of Dearth Mine and to the best of my knowledge and belief shows the location of the mine in said mine. *J. P. ...* Chie Date

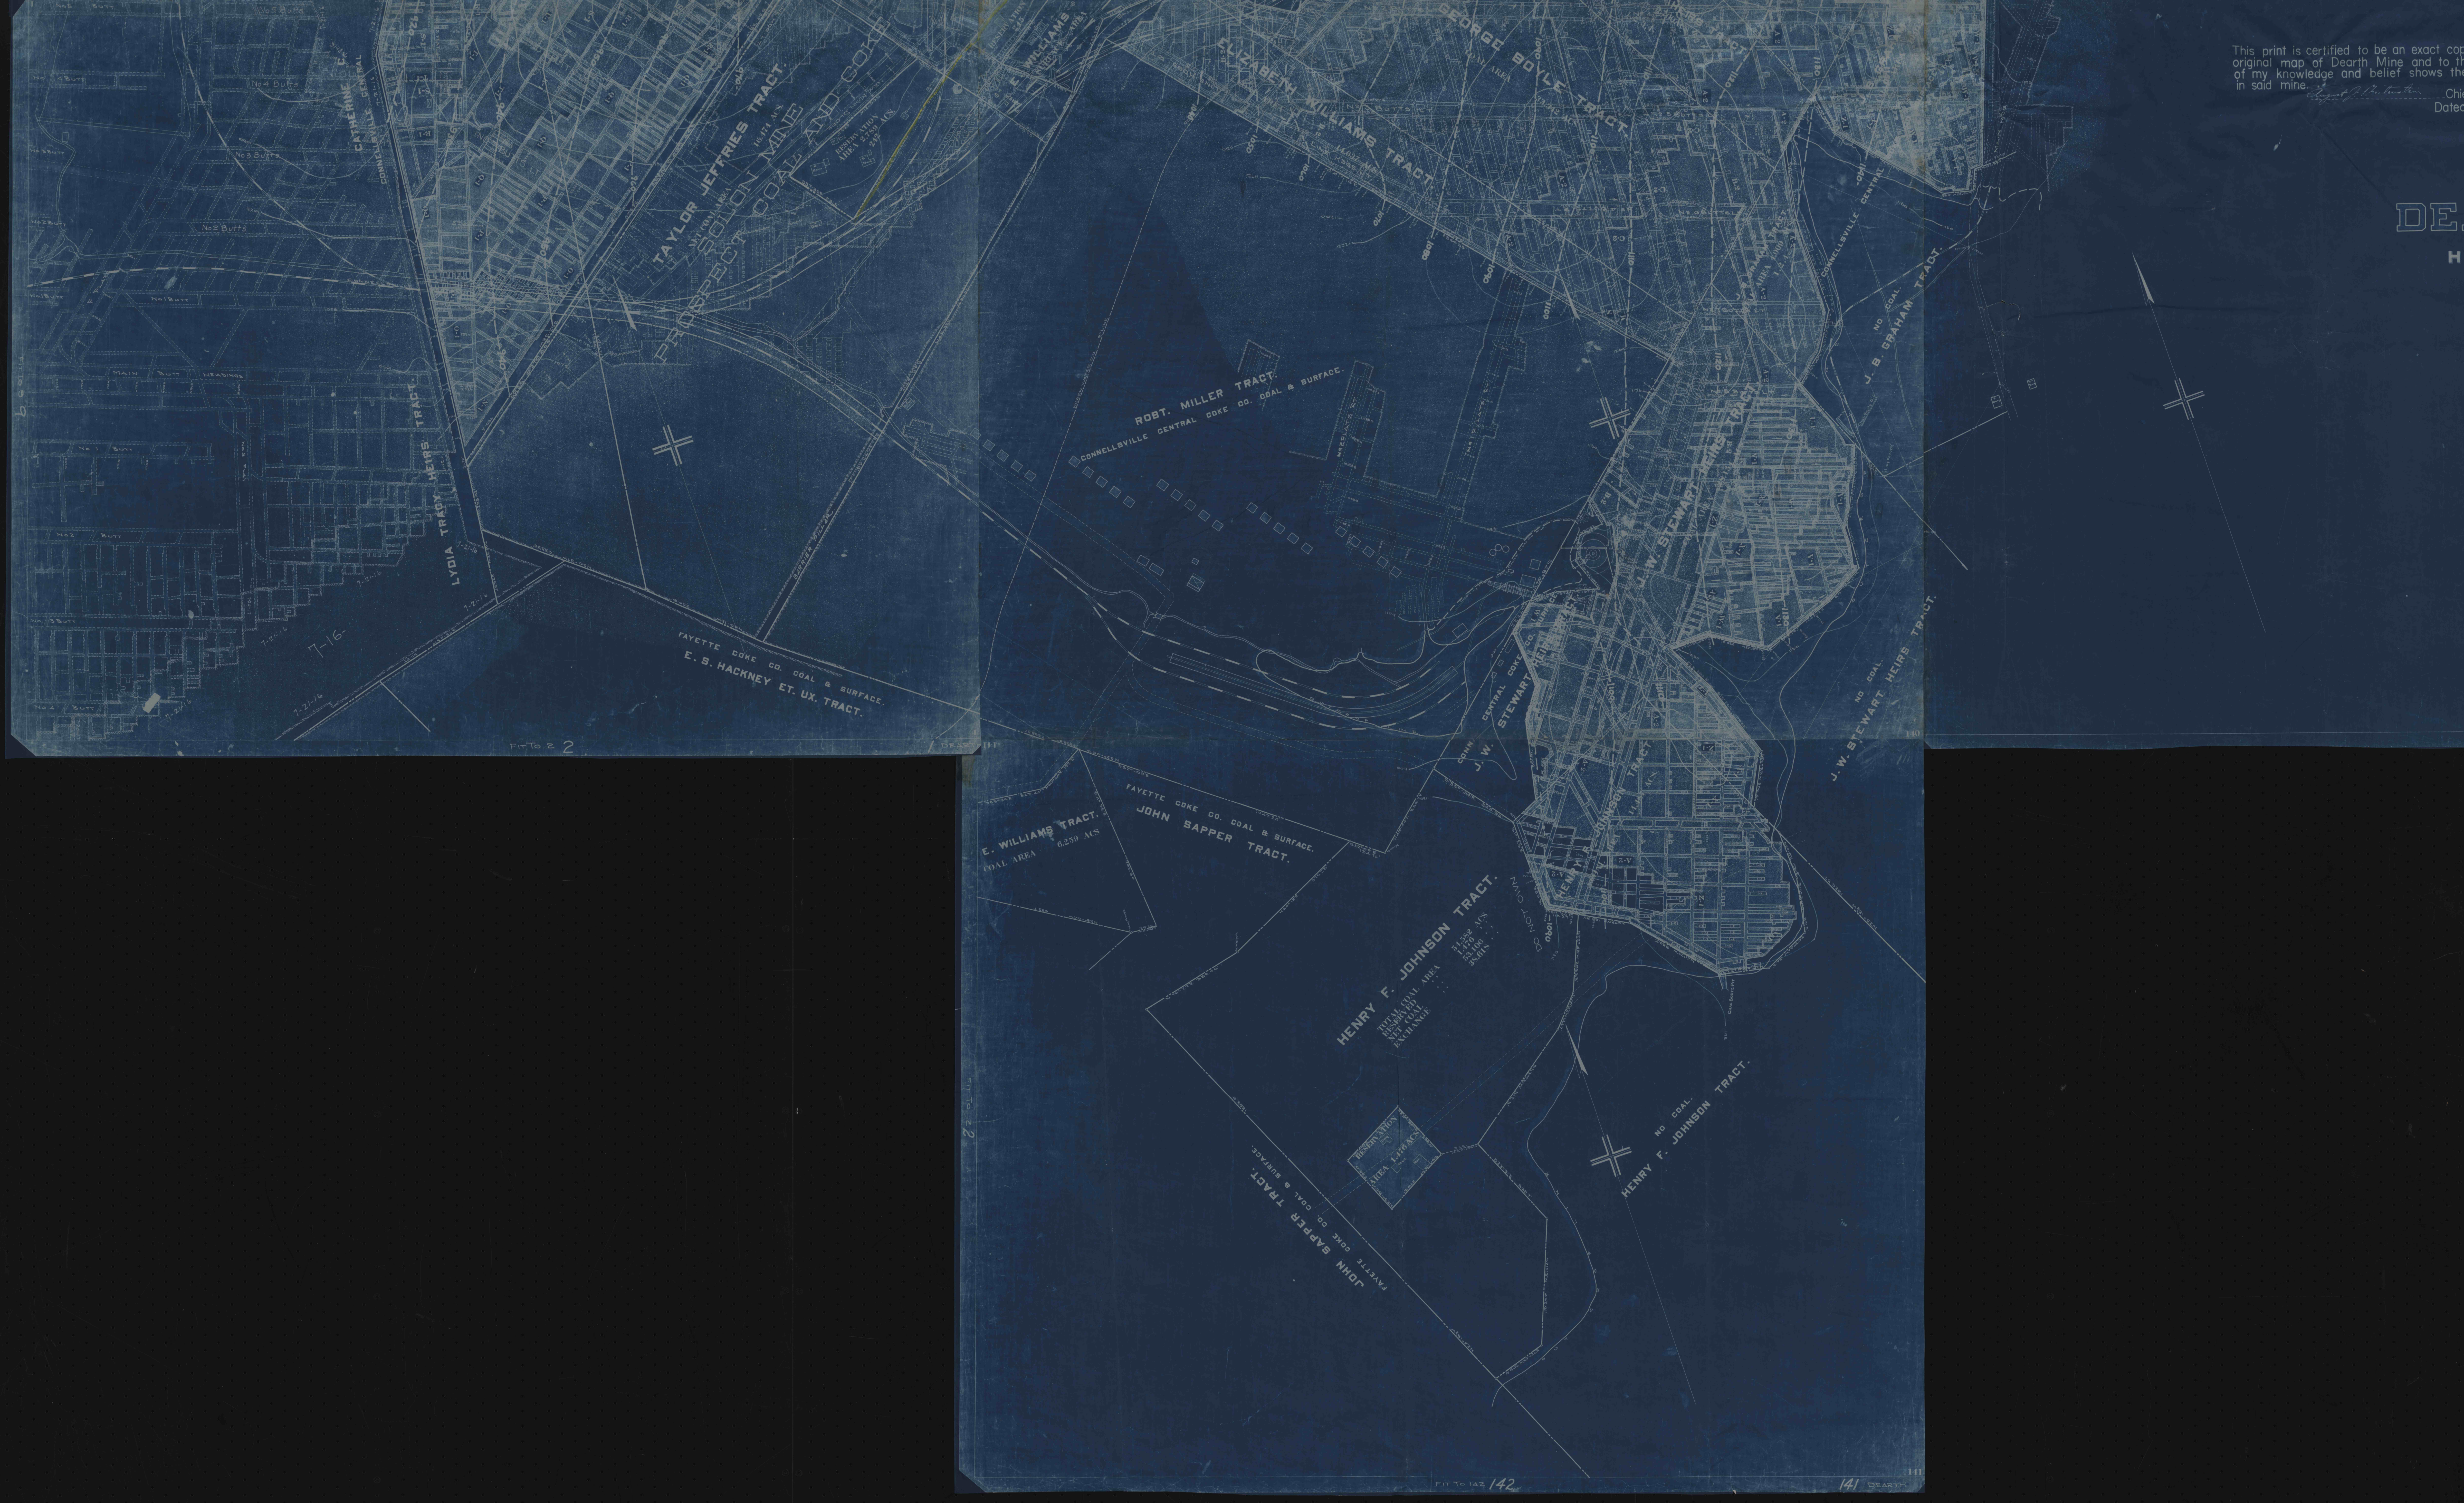

DE

