MAP OF
DECATUR No. 15 MINE
OPERATED BY
HUGHES & BARNES
NEAR
MUNSON CLEARFIELD CO, PA.
OCTOBER 5th 1903

SCALE-1"=100'
SURVEYED TO MAY-8th 1907.
DEC-23rd 1906.
Geo. H. Ayres - Eng.r
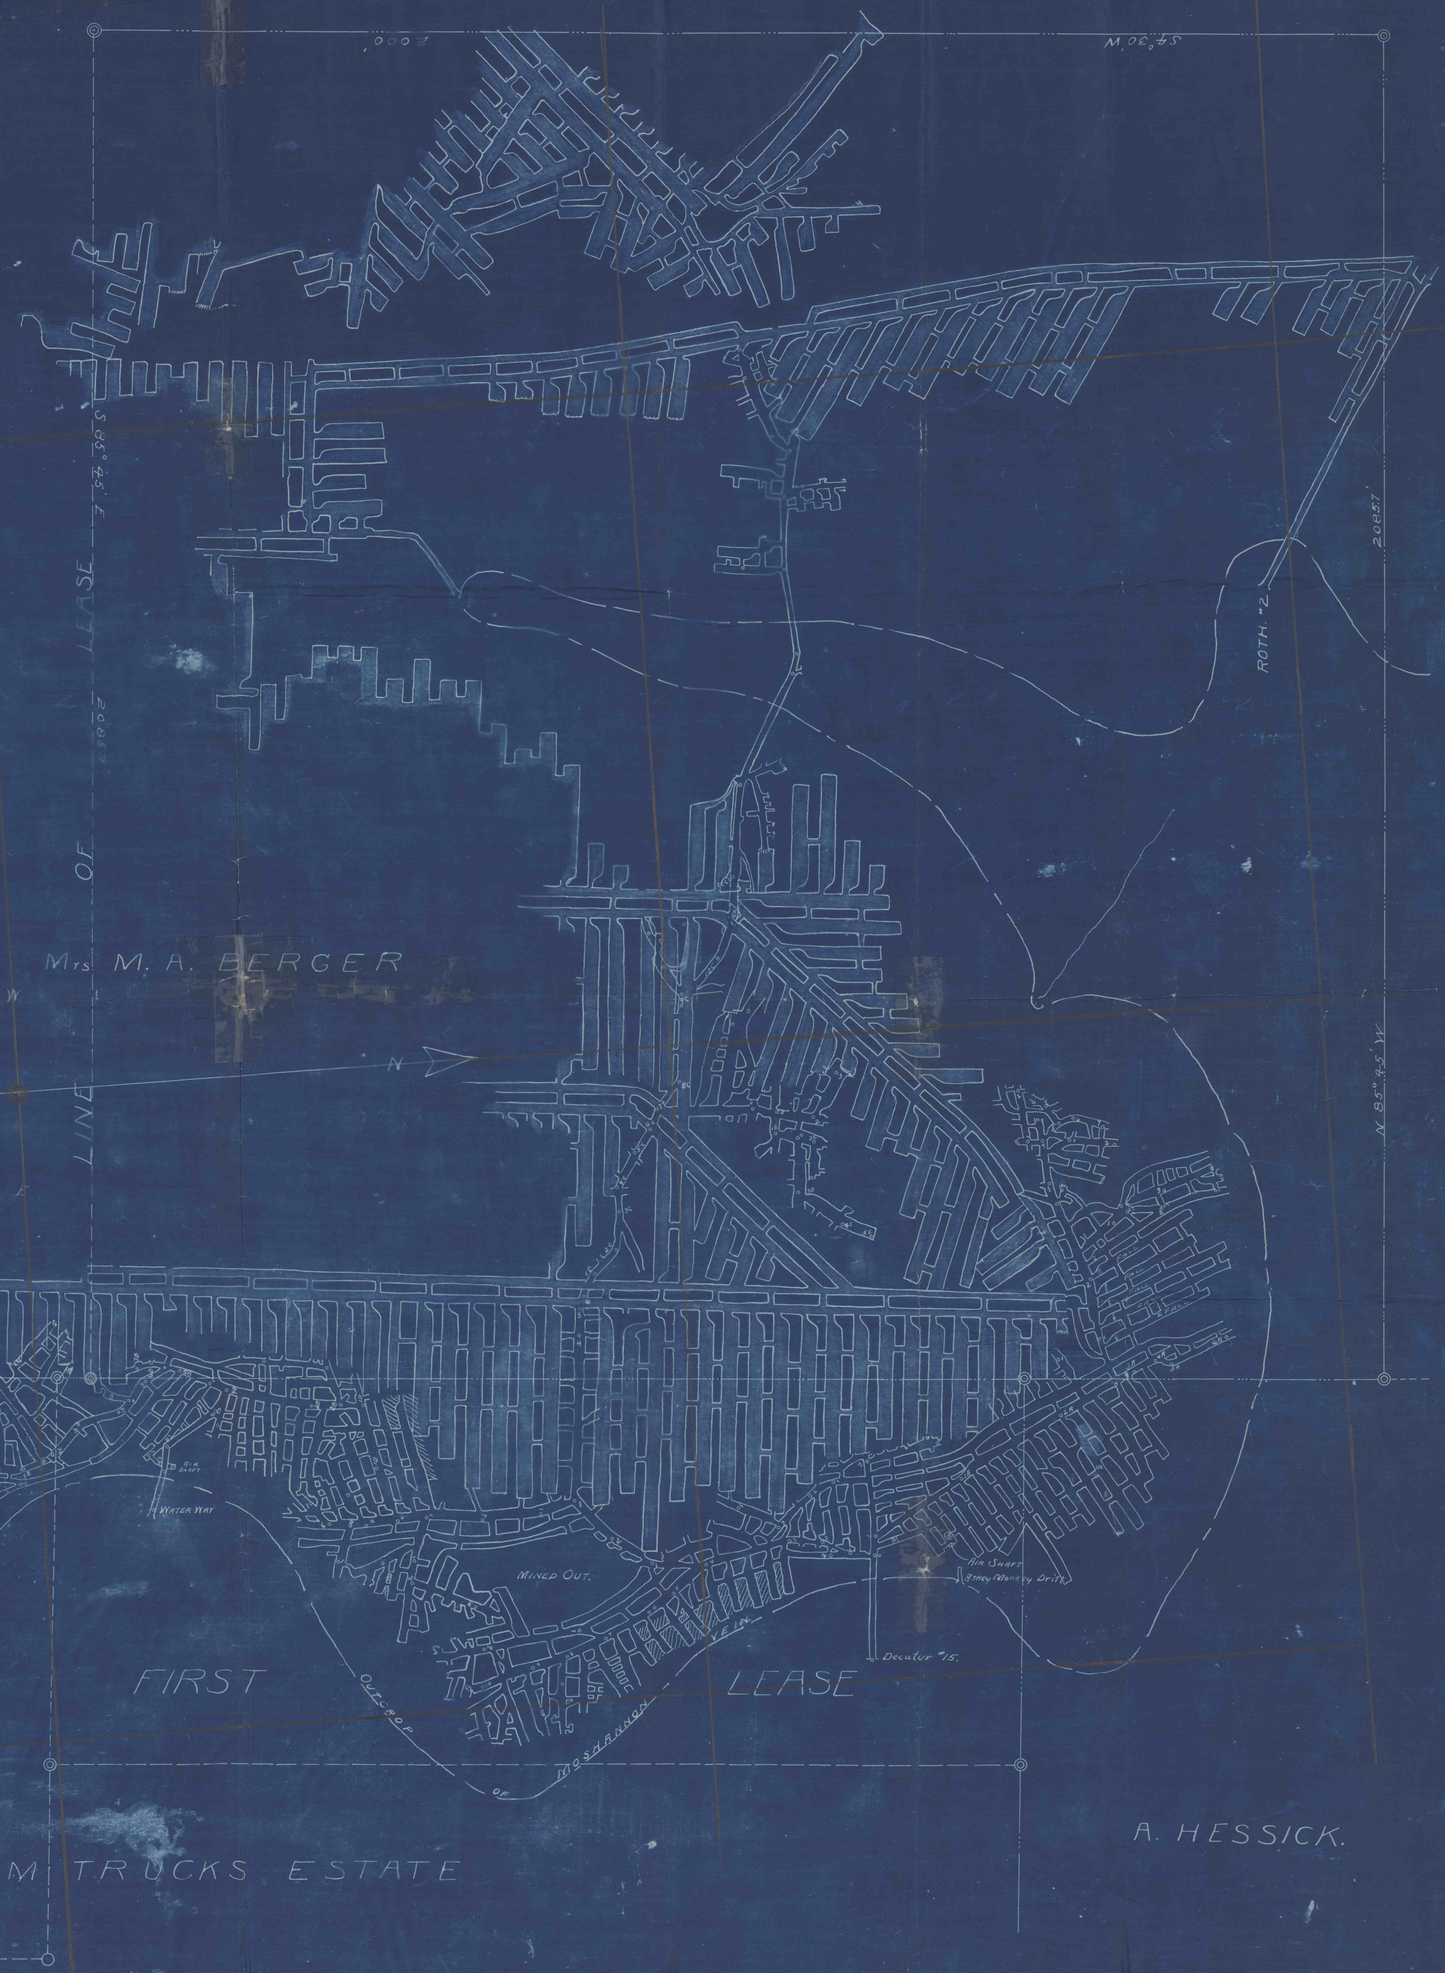
NOTE: RED INDICATES OLD WORKINGS