


POWELL COAL CO. DECKER MINE NO 2

SITUATED IN
RAYBURN TWP ARM. CO. PA.

SCALE 1 INCH = 100 FT.

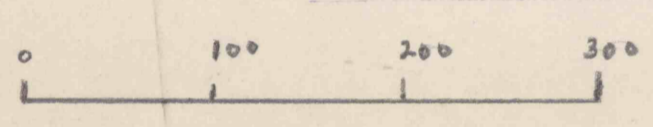

J. J. Downs
REG. ENGR. NO 8055
E. J. Weibel
R.S. 6572 9-62

WORKING EXTENDED TO

SEPT.	12	1945
MAY	1	1946
OCT.	3	1946
APR.	1	1947
FEB.	8	1948
AUG.	8	1948
MAY	15	1949
JAN.	15	1950
OCT.	15	1950
APRIL	5	1952
NOV.	2	1952
JUNE	1	1953
SEPT.	26	1953
DEC.	1	1960
SEPT.		1962

I CERTIFY THAT THIS IS A TRUE
AND CORRECT PRINT OF POWELL
COAL CO. DECKER NO-2 MINE AS
ABANDONED - SEALED - SEPT. 1962
E. J. Weibel R.S. 6572



LANDS OF ARM. CO. INSTITUTION

#158
7-6-99
CC