



REVISED	FEB. 9 1960
REV.	FEB. 10 1959
REV.	MAR. 14 1958
REV.	JUN. 16 1958
REV.	AUG. 15 1956
REV.	MAR. 8 1957
REV.	JUL. 30 1957

LEGEND

CONTEMPLATED MINING 8-15-57-2-16-58 NONE

SUPPORT AREA NONE


PROTECTED STRUCTURES NONE

MINING COMPLETED AREA NONE

PERMIT NO 69-1

FINAL  
PROJECTION MAP  
**POWELL COAL CO.**  
KITTANNING PA.  
DECKER NO. 4-MINE

RAYBURN TWP. ARMSTRONG COUNTY PA.  
SCALE 1"=100' JULY 6 1959

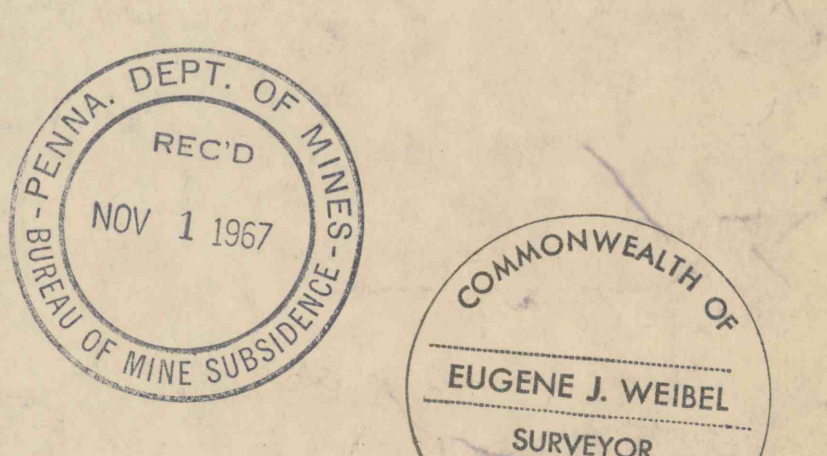

E. J. Weibel R.S.  
E. J. WEIBEL R.S. 6572