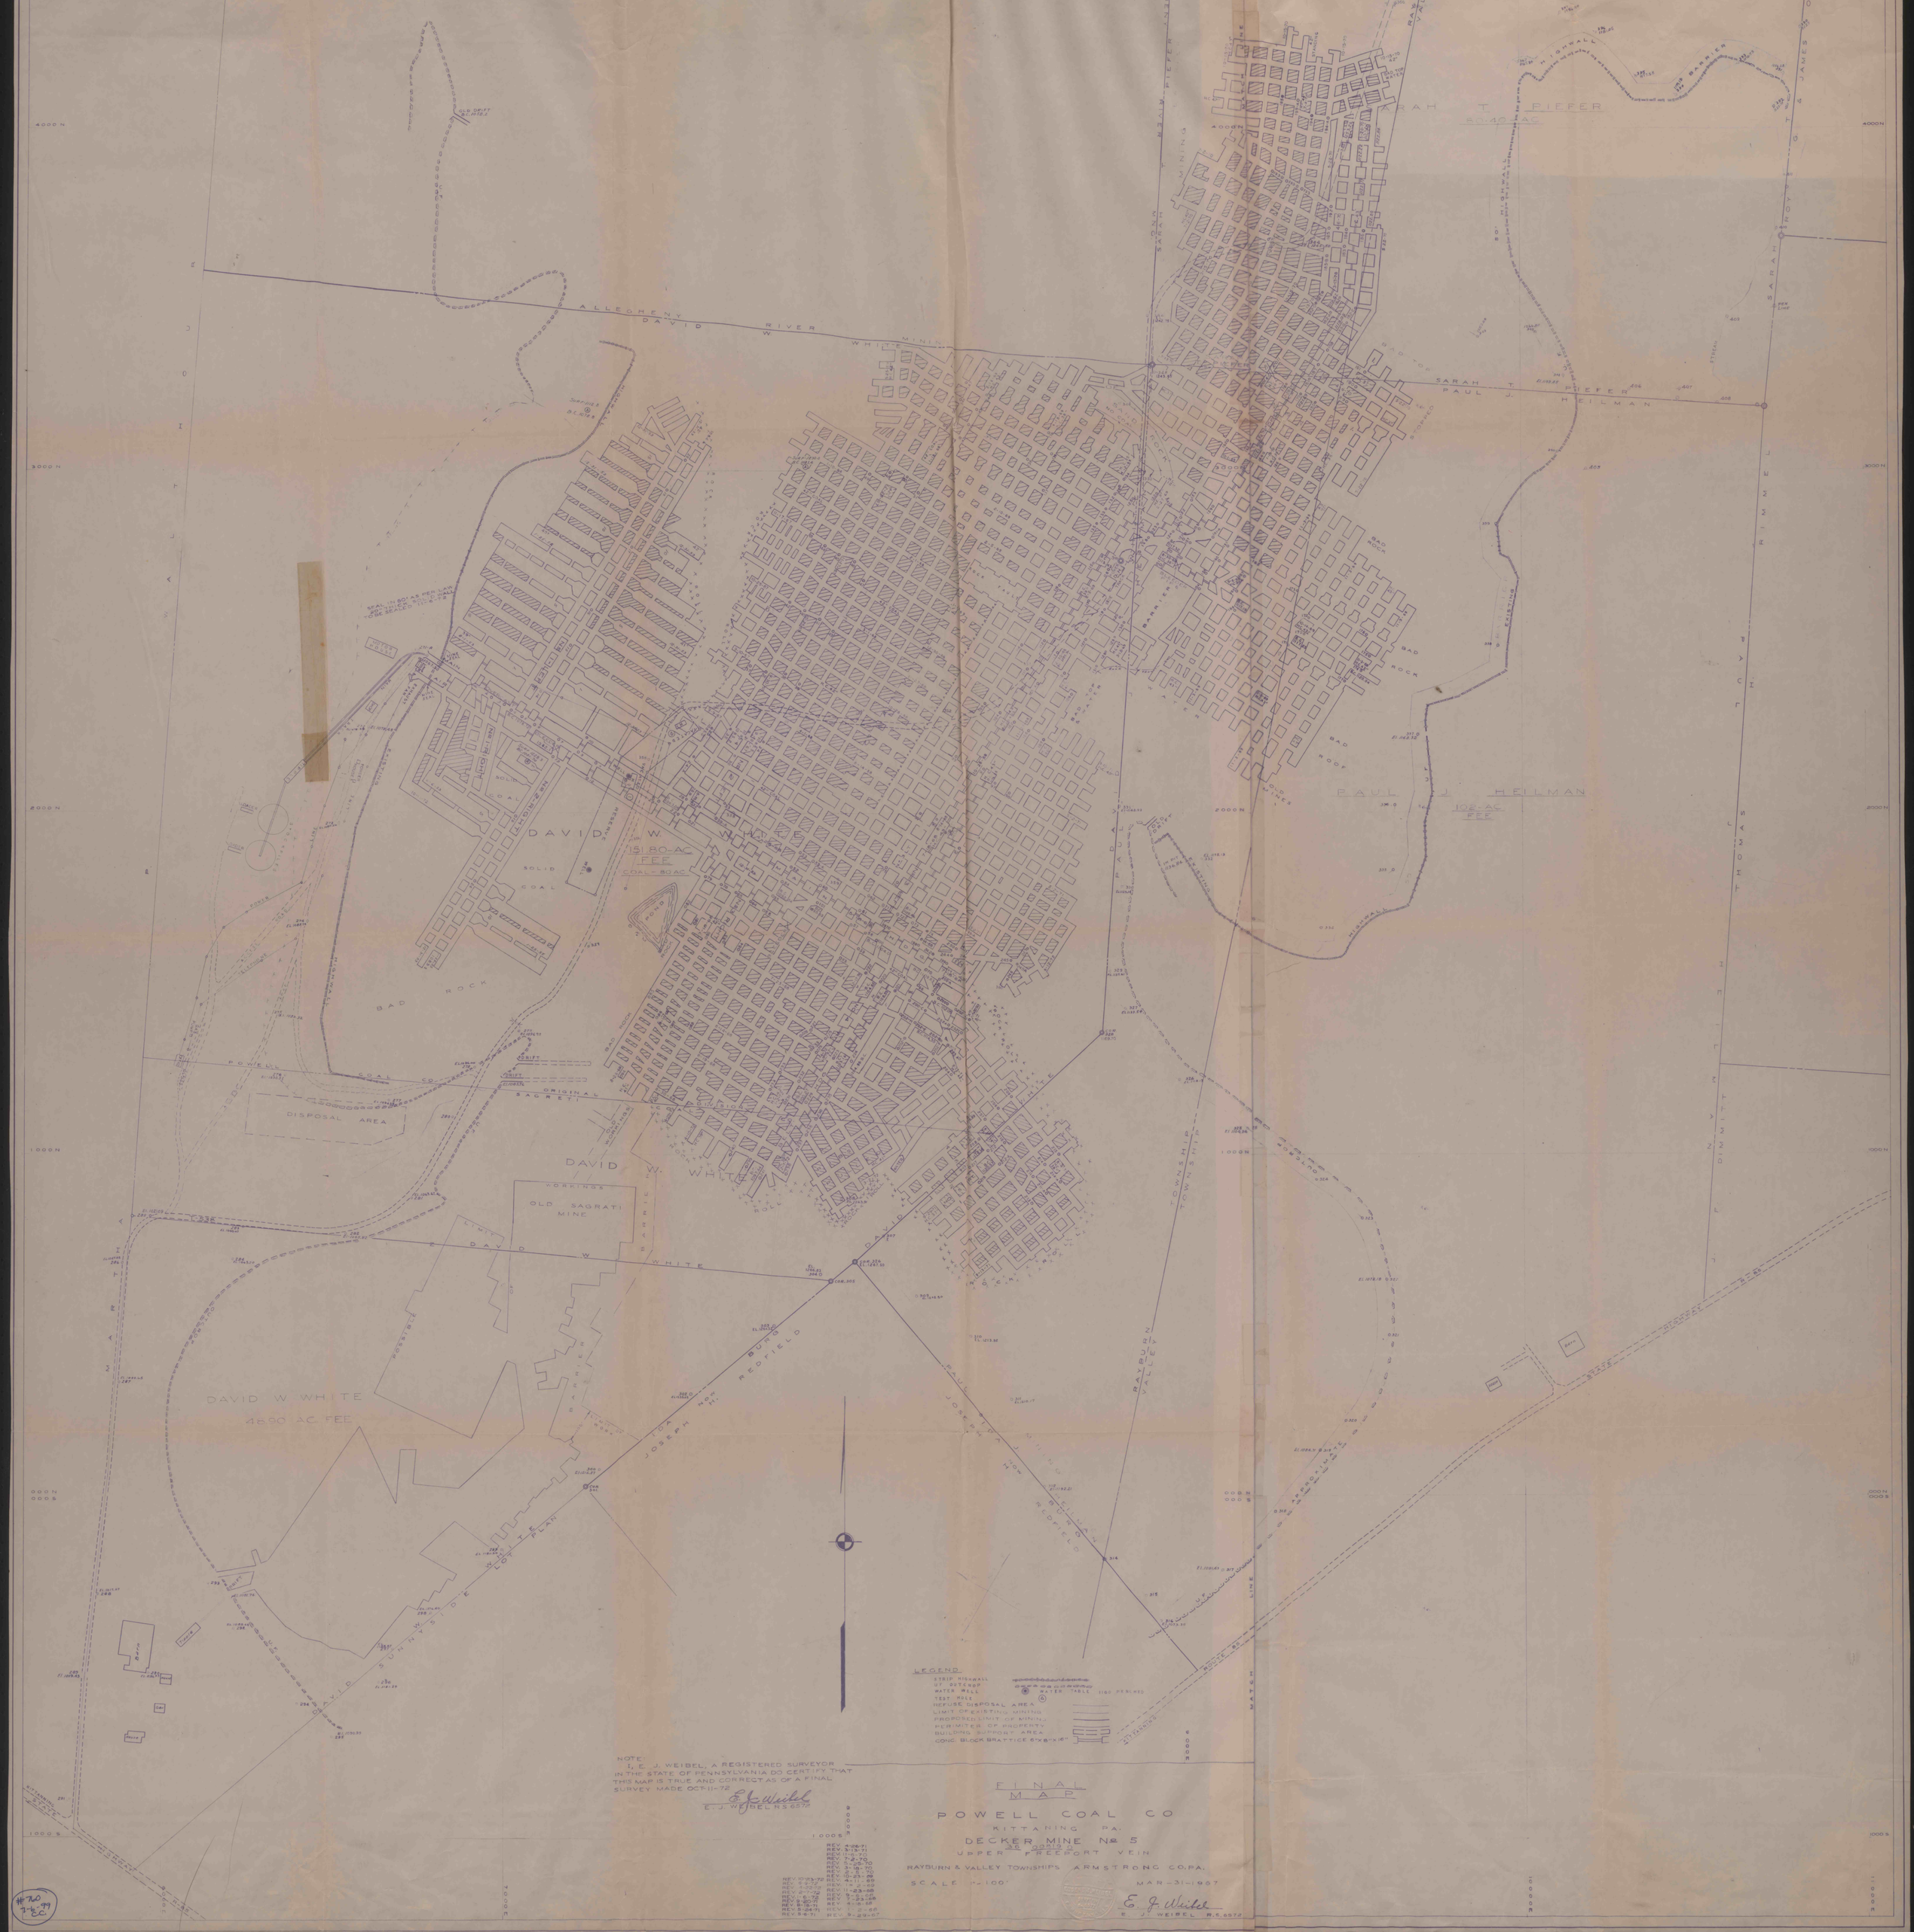
ALLEGHENY RIVER
DAVID W WHITE MINING
SARAH T PIEFER
ROAD TO SARAH T PIEFER
PAUL J HEILMAN
THOMAS J RIMMEL
DAVID W WHITE
151.80 AC
FEE
COAL - 80 AC
DAVID W WHITE
4890 AC FEE
PAUL J HEILMAN
102 AC
FEE
OLD SAGRATI MINE
WORKINGS
DISPOSAL AREA
POWELL COAL CO
BAD ROCK
BAD ROOF
HIGHWALL
BARRIER
SOLID COAL
DRIFT
SLOPE
PROPOSED
EXISTING
POSSIBLE
SUNNYSIDE
BURNED REDFIELD
RAYBURN VALLEY TOWNSHIP
DIMMITT
ROUTE 85
APPROXIMATE
MATCH LINE
KITTANING
LEGEND
STRIP HIGHWALL
U/G OUTCROP
WATER WELL
TEST HOLE
INFUSE DISPOSAL AREA
LIMIT OF EXISTING MINING
PROPOSED LIMIT OF MINING
PERIMETER OF PROPERTY
BUILDING SUPPORT AREA
CONC BLOCK BRATTICE 6'x8'x16"
WATER TABLE 1180 PERCHED
NOTE:
I, E. J. WEIBEL, A REGISTERED SURVEYOR IN THE STATE OF PENNSYLVANIA DO CERTIFY THAT THIS MAP IS TRUE AND CORRECT AS OF A FINAL SURVEY MADE OCT 11-72
E. J. WEIBEL R.S. 6572
REV. 4-26-71
REV. 5-13-71
REV. 6-1-70
REV. 7-2-70
REV. 2-25-70
REV. 3-18-70
REV. 2-1-70
REV. 10-23-69
REV. 9-15-69
REV. 5-1-69
REV. 11-23-68
REV. 9-5-68
REV. 7-23-68
REV. 4-15-68
REV. 1-2-68
REV. 9-29-67
FINAL
MAP
POWELL COAL CO
KITTANING PA.
DECKER MINE No. 5
UPPER FREEPORT VEIN
RAYBURN & VALLEY TOWNSHIPS ARMSTRONG CO. PA.
SCALE 1"=100'
MAR-31-1967
E. J. WEIBEL R.S. 6572
#760
7-8-99
EC