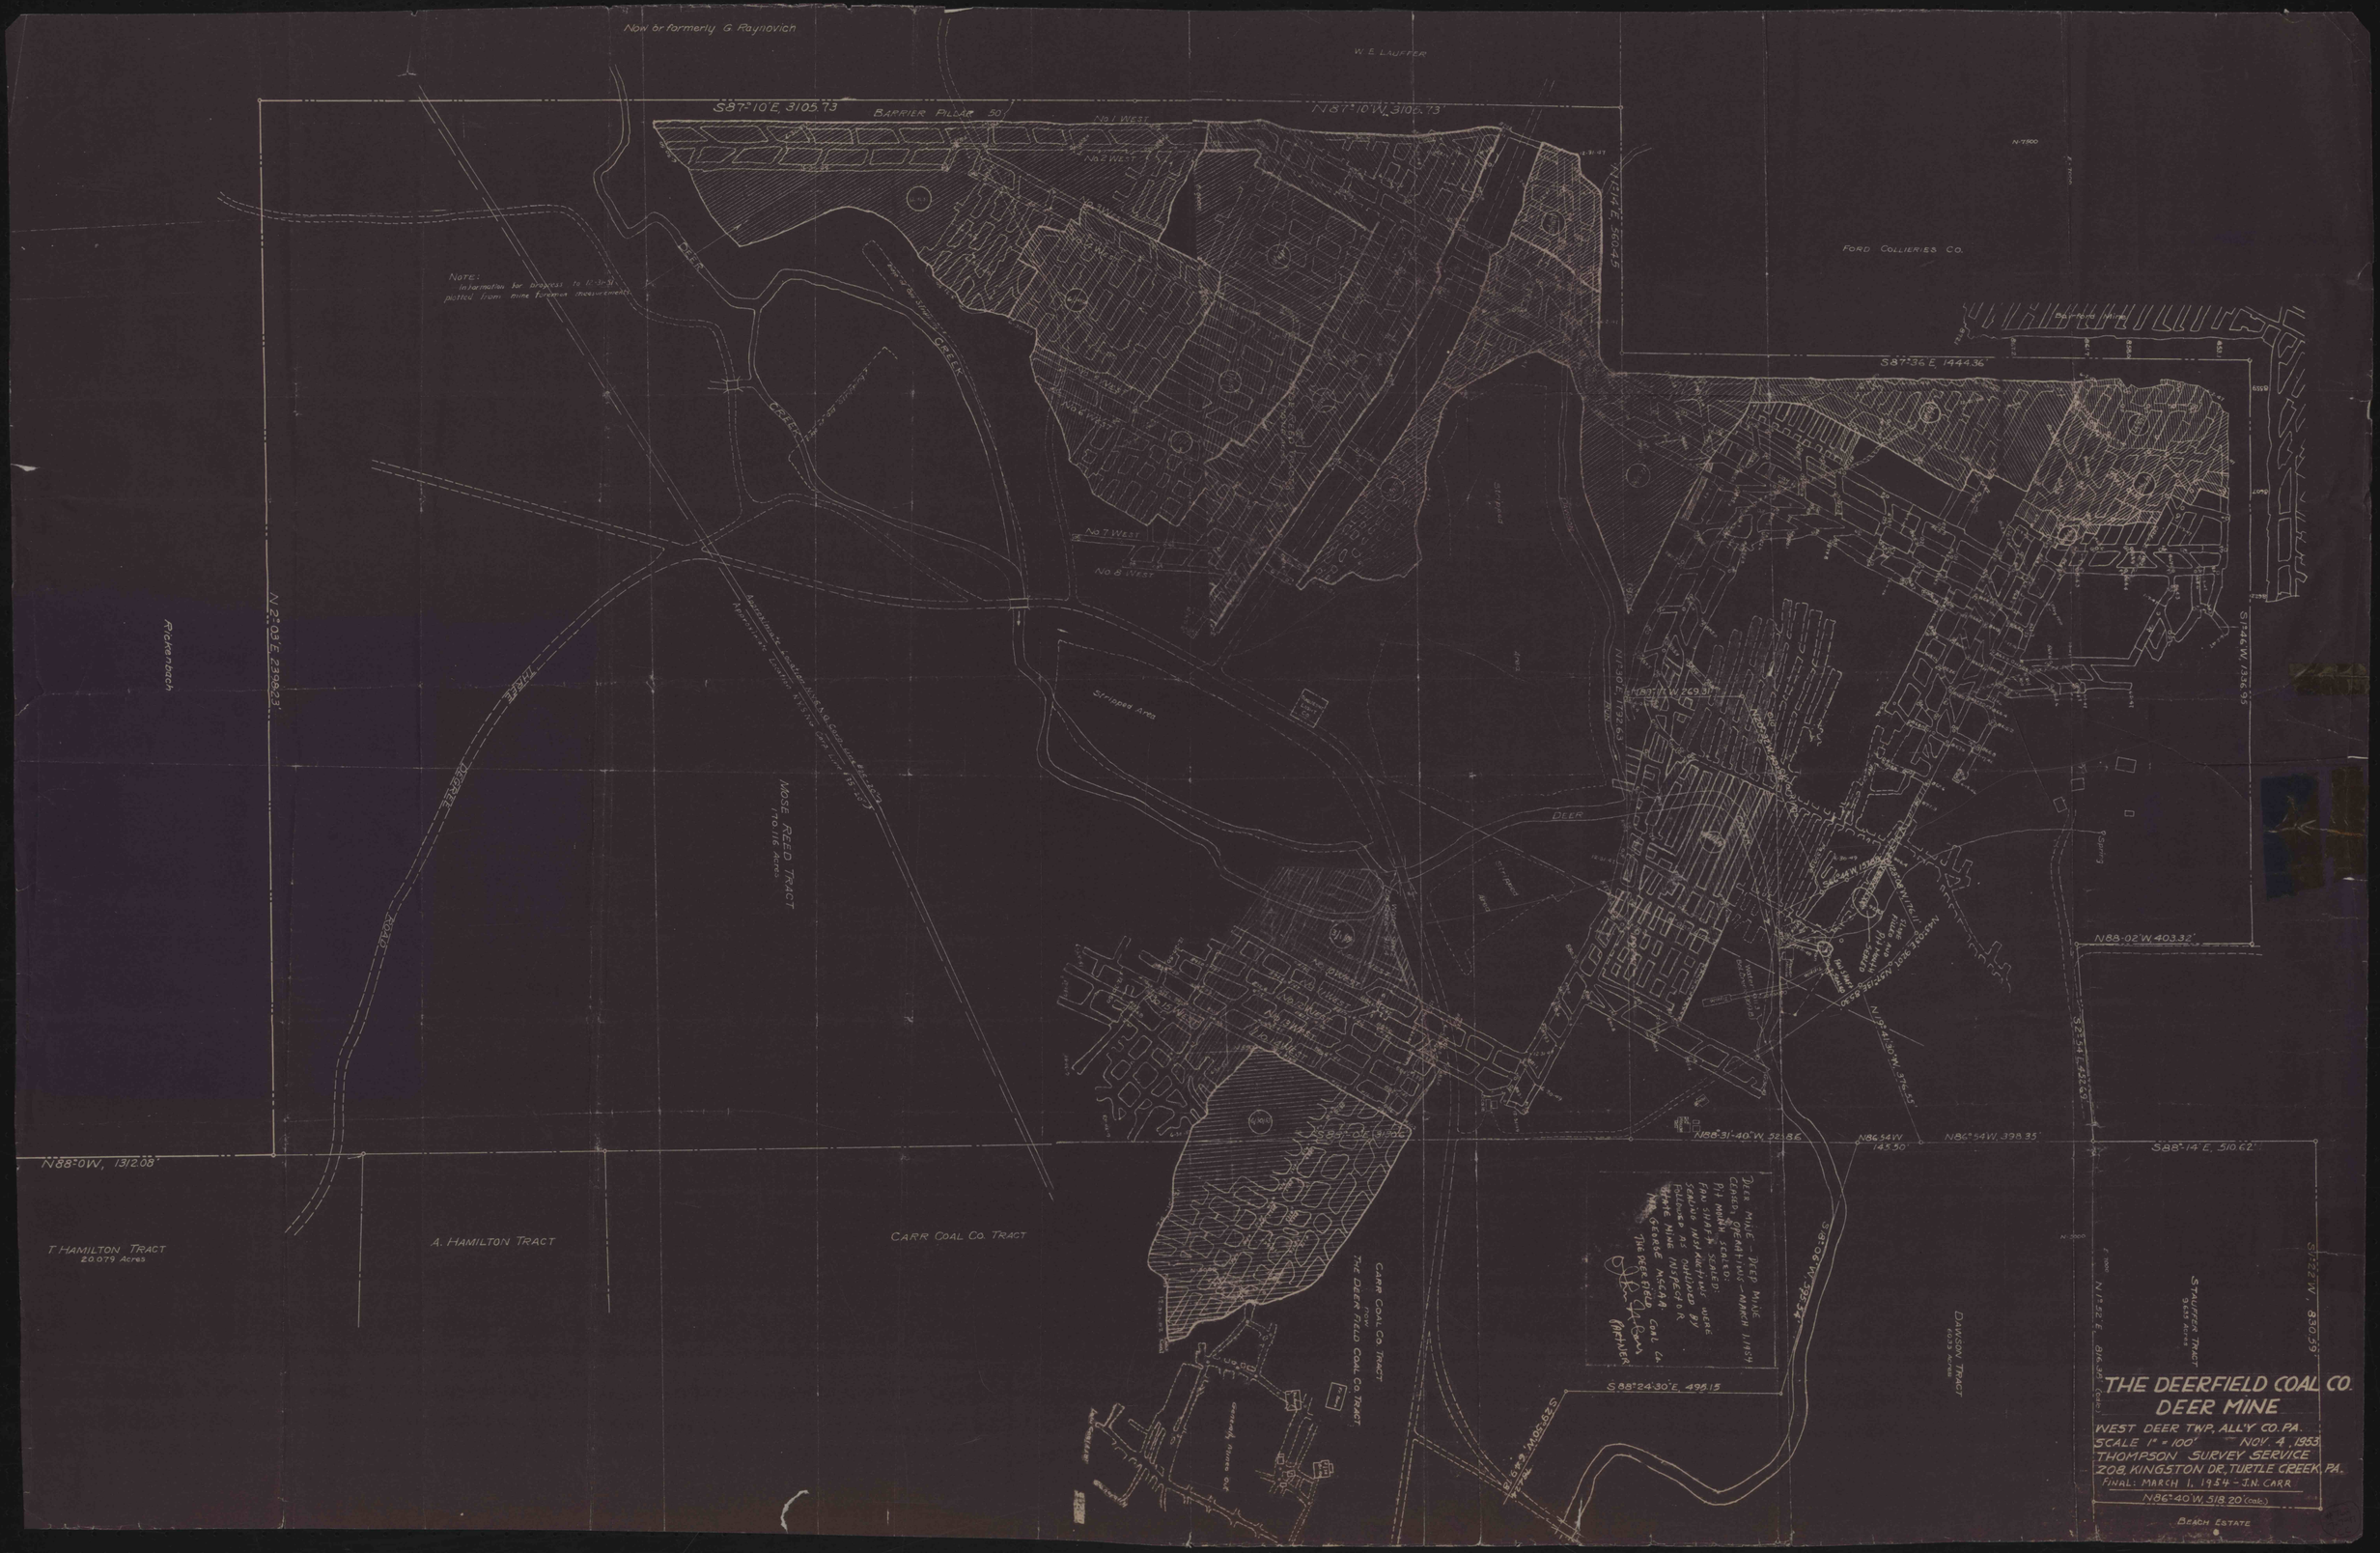

Now or formerly G. Raynovich
W. E. LAUFFER
S87°10'E, 3105.73'
BARRIER PILLAR 50'
N87°10'W, 3106.73'
No. 1 WEST
No. 2 WEST
No. 7 WEST
No. 8 WEST
FORD COLLIERIES CO.
S87°36'E, 1444.36'
Bar-Ford Mine
Note:
Information for progress to 12-31-51 plotted from mine foreman measurements.
DEER
CREEK
Stripped Area
Rickenbach
N2°03'E, 2398.23'
MOSE REED TRACT
170.116 Acres
N88°0'W, 1312.08'
T. HAMILTON TRACT
20.079 Acres
A. HAMILTON TRACT
CARR COAL CO. TRACT
CARR COAL CO. TRACT
THE DEER FIELD COAL CO. TRACT
N88°31'40"W, 52.86'
N86°54'W, 398.35'
S88°14'E, 510.62'
N88°02'W, 403.32'
S88°24'30"E, 495.15'
DAWSON TRACT
STAUFFER TRACT
THE DEERFIELD COAL CO.
DEER MINE
WEST DEER TWP., ALL'Y CO. PA.
SCALE 1" = 100'
NOV. 4, 1953
THOMPSON SURVEY SERVICE
208, KINGSTON DR., TURTLE CREEK, PA.
FINAL: MARCH 1, 1954 - J.N. CARR
N86°40'W, 518.20' (calc.)
BEACH ESTATE