


DEL MONT FUEL CO.
NO. 10
MINE

LEGEND
60% MINING AREA
80% MINING AREA
80% COAL BOUNDARY NO. 10 MINE
80% MINING AREA
DEVELOPMENT

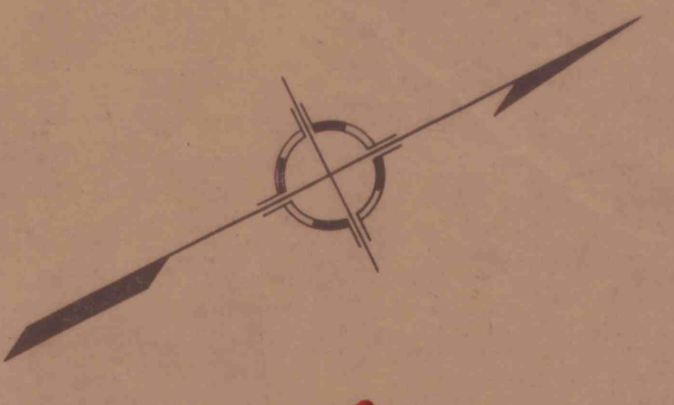

FINAL MAP
EASTERN ASSOCIATED COAL CORP.
DEL MONT MINE
SITUATE NEAR

RUFF SOALE
EAST & SOUTH HUNTINGDON TOWNSHIP
WEST MORELAND COUNTY
PENNSYLVANIA
SCALE: 1 IN. = 100 FT.

ENGINEER
SURVEY OF
2-3-77

10-31-69
1-31-70
2-28-70
9-17-70
10-31-69
1-31-70
12-16-69
7-31-70
6-28-70

TXPS - EASTERN

30 INCH

TRANSMISSION
LINE

EAST HUNTINGDON
SOUTH HUNTINGDON
TOWNSHIP

POTOKA COAL CO.

RUFFSOALE COAL CO.

-70
-70
-70
-70
-70
-70
-70