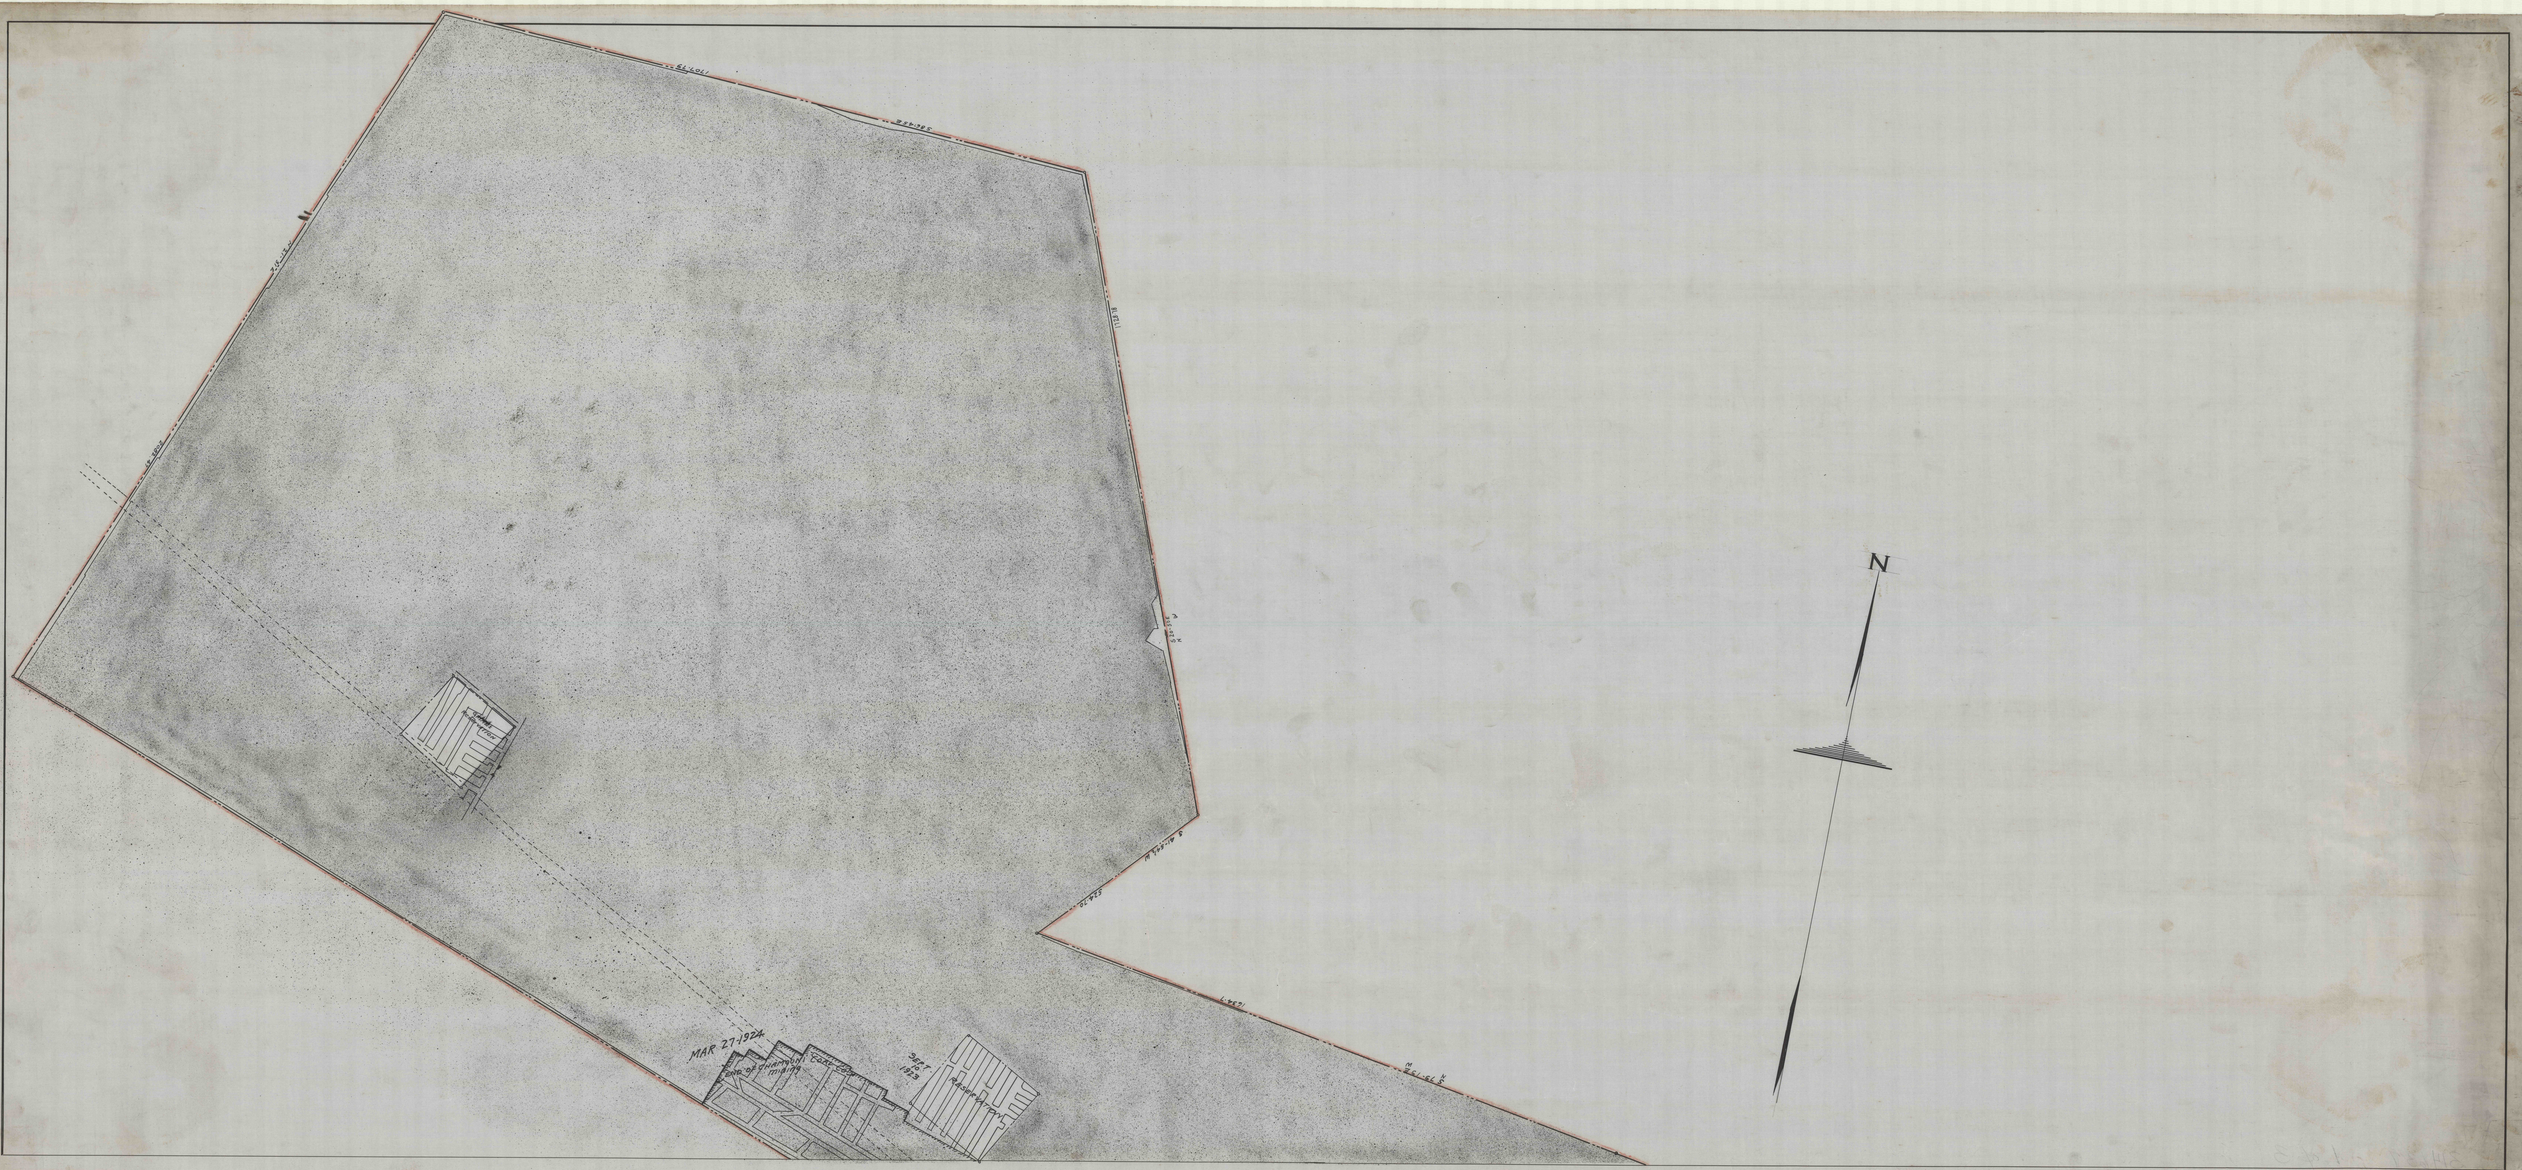
N
MAR 27 1924
END OF CHARMONI COAL
mining
SEPT
to
1923
RESERVATION