


BELCH MINE

FILLIAGGI MINE

MINED BY SOUTHERN CONNELLSVILLE COKE CO.

LEASE BOUNDARY

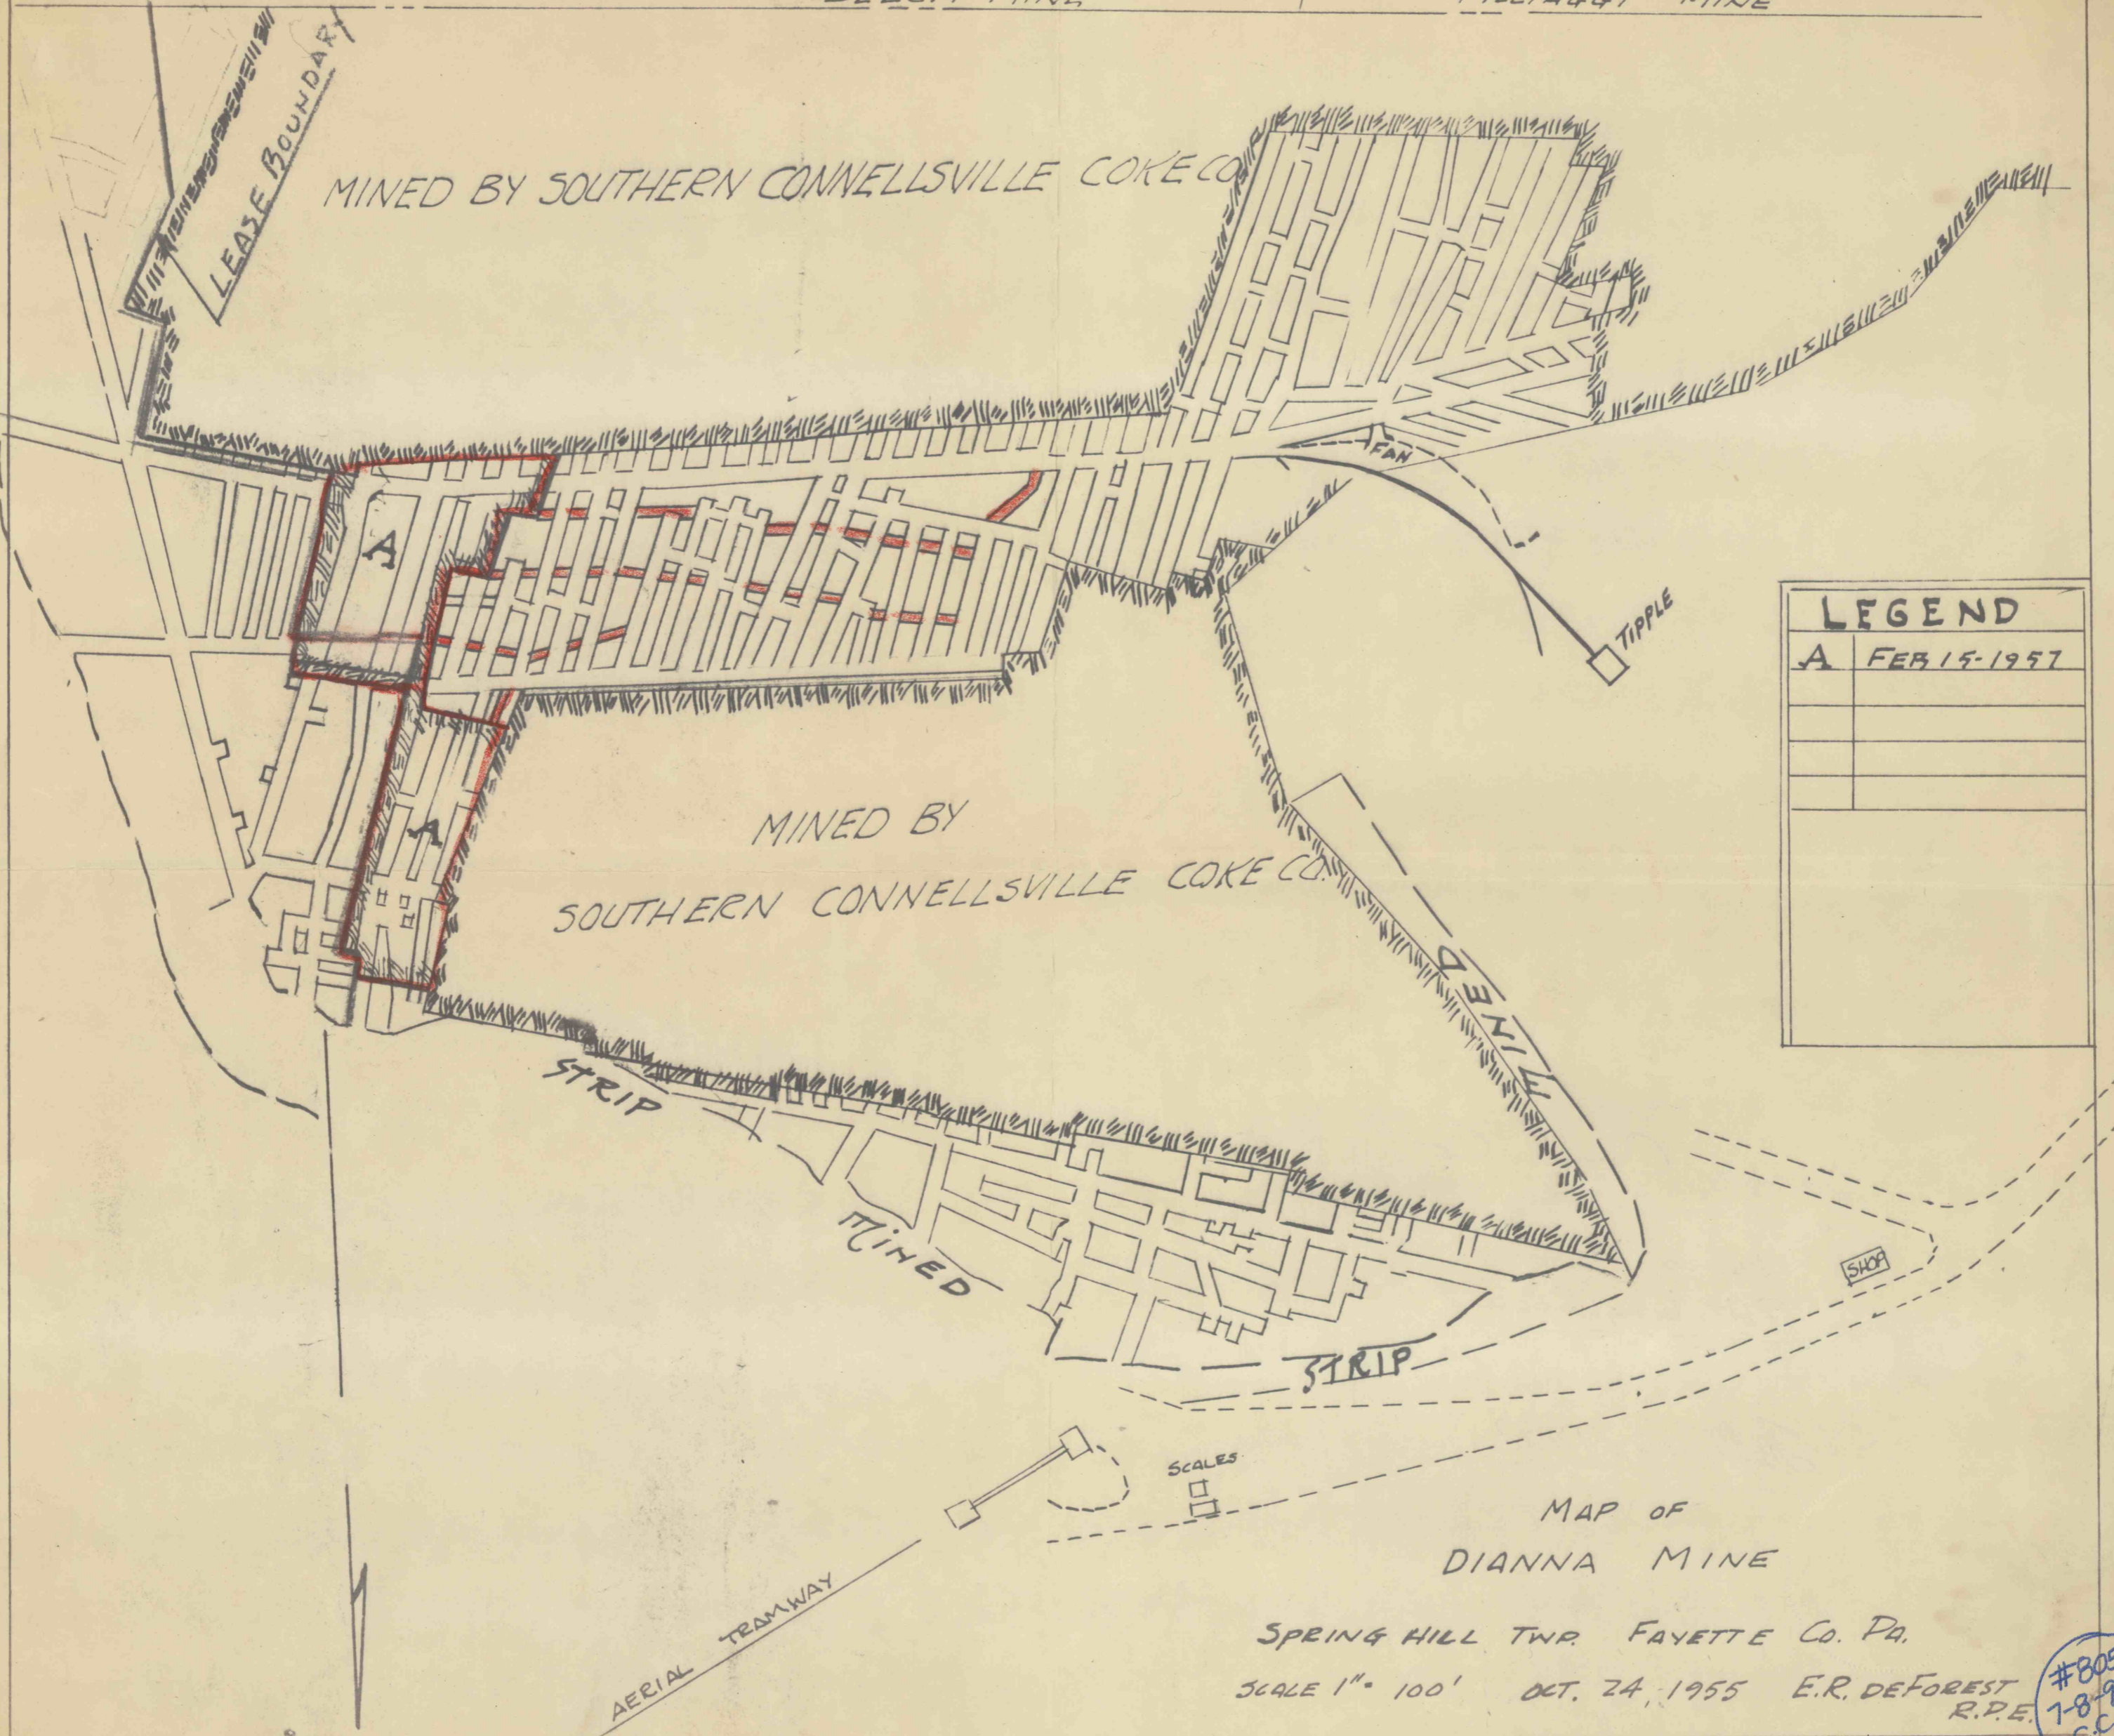

LEGEND	
A	FEB 15-1957

MINED BY SOUTHERN CONNELLSVILLE COKE CO.

STRIP

MINED

STRIP

MAP OF DIANNA MINE

SPRING HILL TWP. FAYETTE CO. PA.

SCALE 1" = 100' OCT. 24, 1955 E.R. DEFOREST R.P.E.

#805
1-8-99
E.C.