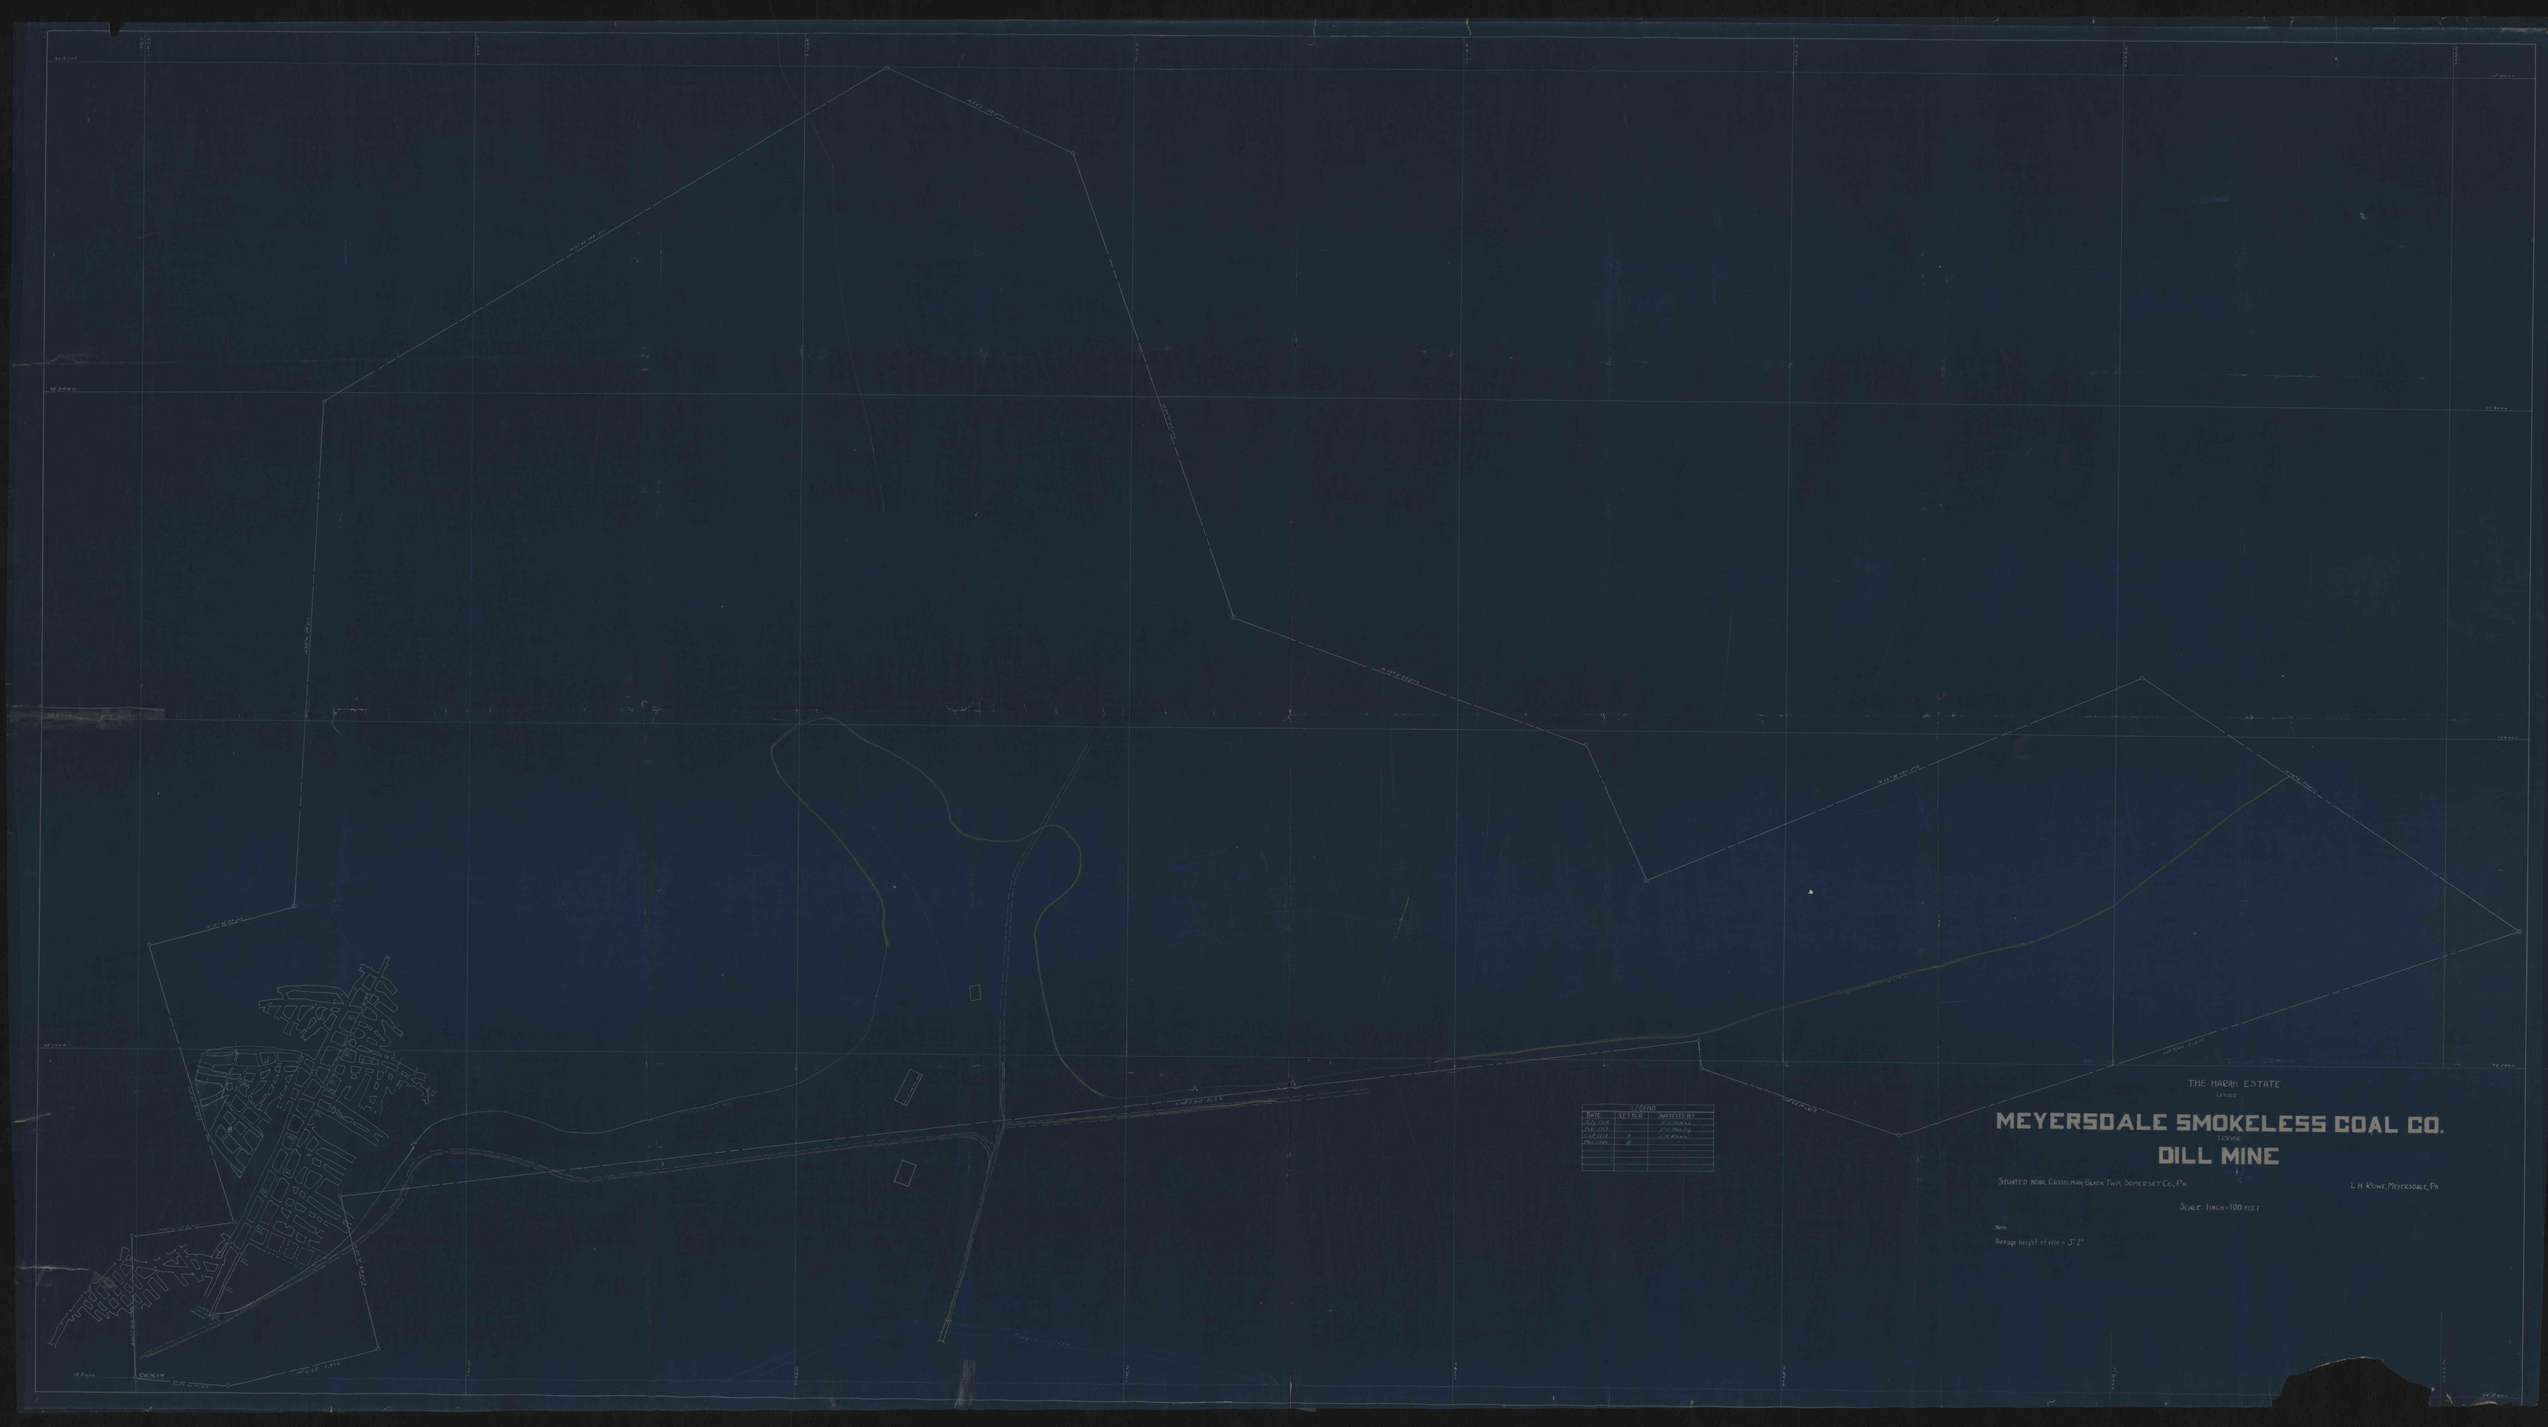
THE HARAH ESTATE
LESSOR
MEYERSDALE SMOKELESS COAL CO.
LESSEE
DILL MINE
Situated near Casselman, Black Twp, Somerset Co., Pa.
L.H. Rowe, Meyersdale, Pa.
Scale 1 inch = 100 feet
Note
Average height of vein = 3'-2"
RECORD
DATE
LETTER
SURVEYED BY
Coxes Run
Casselman River