

LULA CLAWSON Surf.

W.E. BOWLIN Surf.

H.E. CLARK INT. Surf.

C.B.C. CORP. Fee

C.B.C. CORP. Fee


200 FOOT BARRIER
OLD MINE

CUT INTO OLD WORKINGS

C.B.C. CORP. Fee

C.B.C. CORP. Fee

50% MINING
SOLID COAL
NO MINING

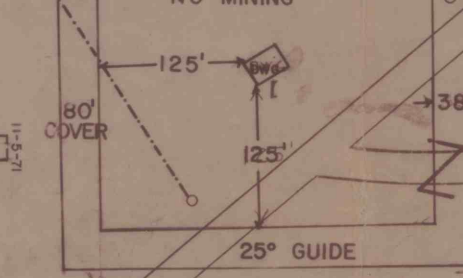

I certify that this map is a true & correct copy of original mine tracing and that the workings here are made from the correct survey made by John C. Passmore Company

H.E. CLARK INT.

H. PONTANI Surf.



4 MI. TO CLYMER

50 FT. BARRIER

50% MINING
SOLD COAL

50 COVER

CHERRY AND DIXONVILLE RAILROAD

PENNA. ROUTE 286

VILLAGE OF STARBUCK


NORTH BRANCH TWOLICK CREEK

DIXON RUN COAL CO.
RD 1 PENN RUN, PA. 15765
DIXON RUN NO. 4 MINE
 GREEN TWP. — INDIANA CO.-PENNA.
 SCALE - 1" = 100' SURVEY DATE 10-20-72

Contemplated Mining _____ to _____
 Mining Completed _____ to _____
 Supported Area _____

John C. Passmore - Registered Surveyor SEAL

John C. Passmore

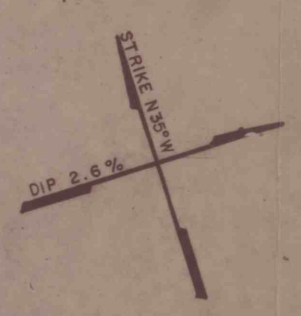

#018
7-9-72
C.C.