

REED SMITH

DOBSON


YEAGER

MAURER

MINE MAP  
DOBSON COAL CO.,  
MINE

OLIVER TOWNSHIP, JEFFERSON COUNTY, PA.,

SCALE 1 IN. = 100 FT. OCT., 1945  
WALTER J. ZIMMERMAN SURVEYOR,  
PUNXSUTAWNEY, PA.

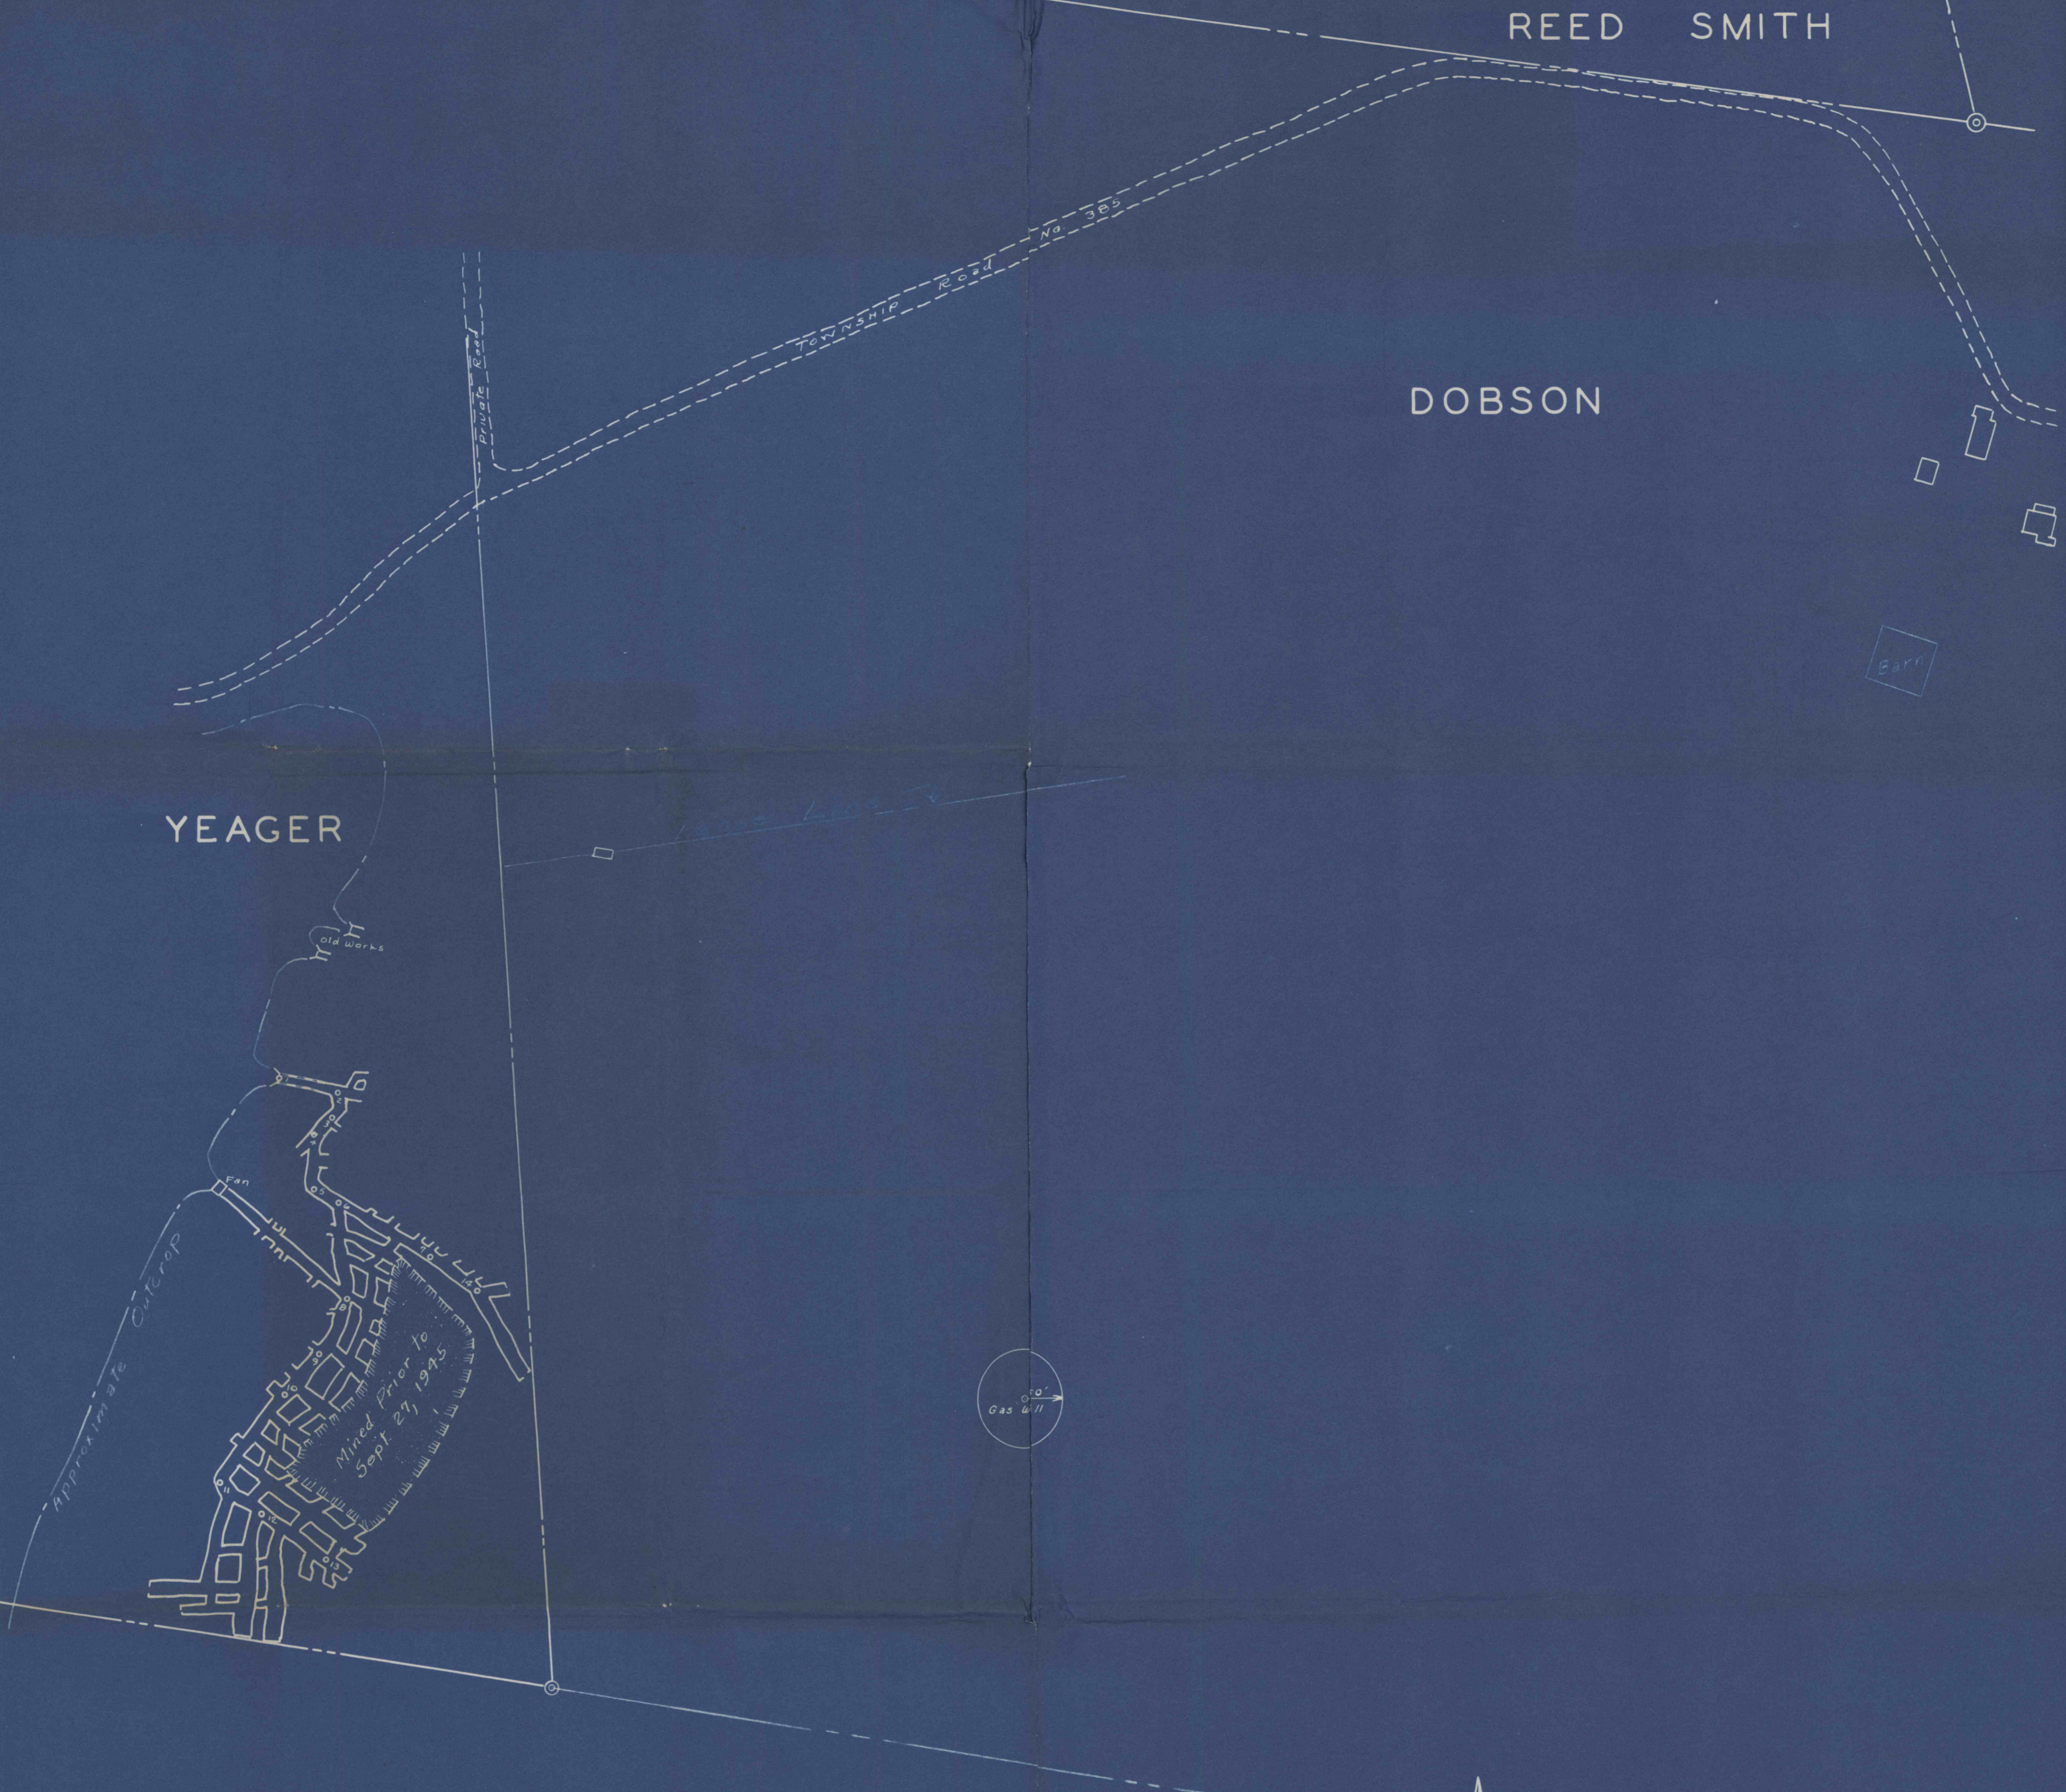

Handwritten initials and a date in the bottom right corner: WJZ 10/1/45