


REED SMITH

DOBSON

YEAGER

MAURER

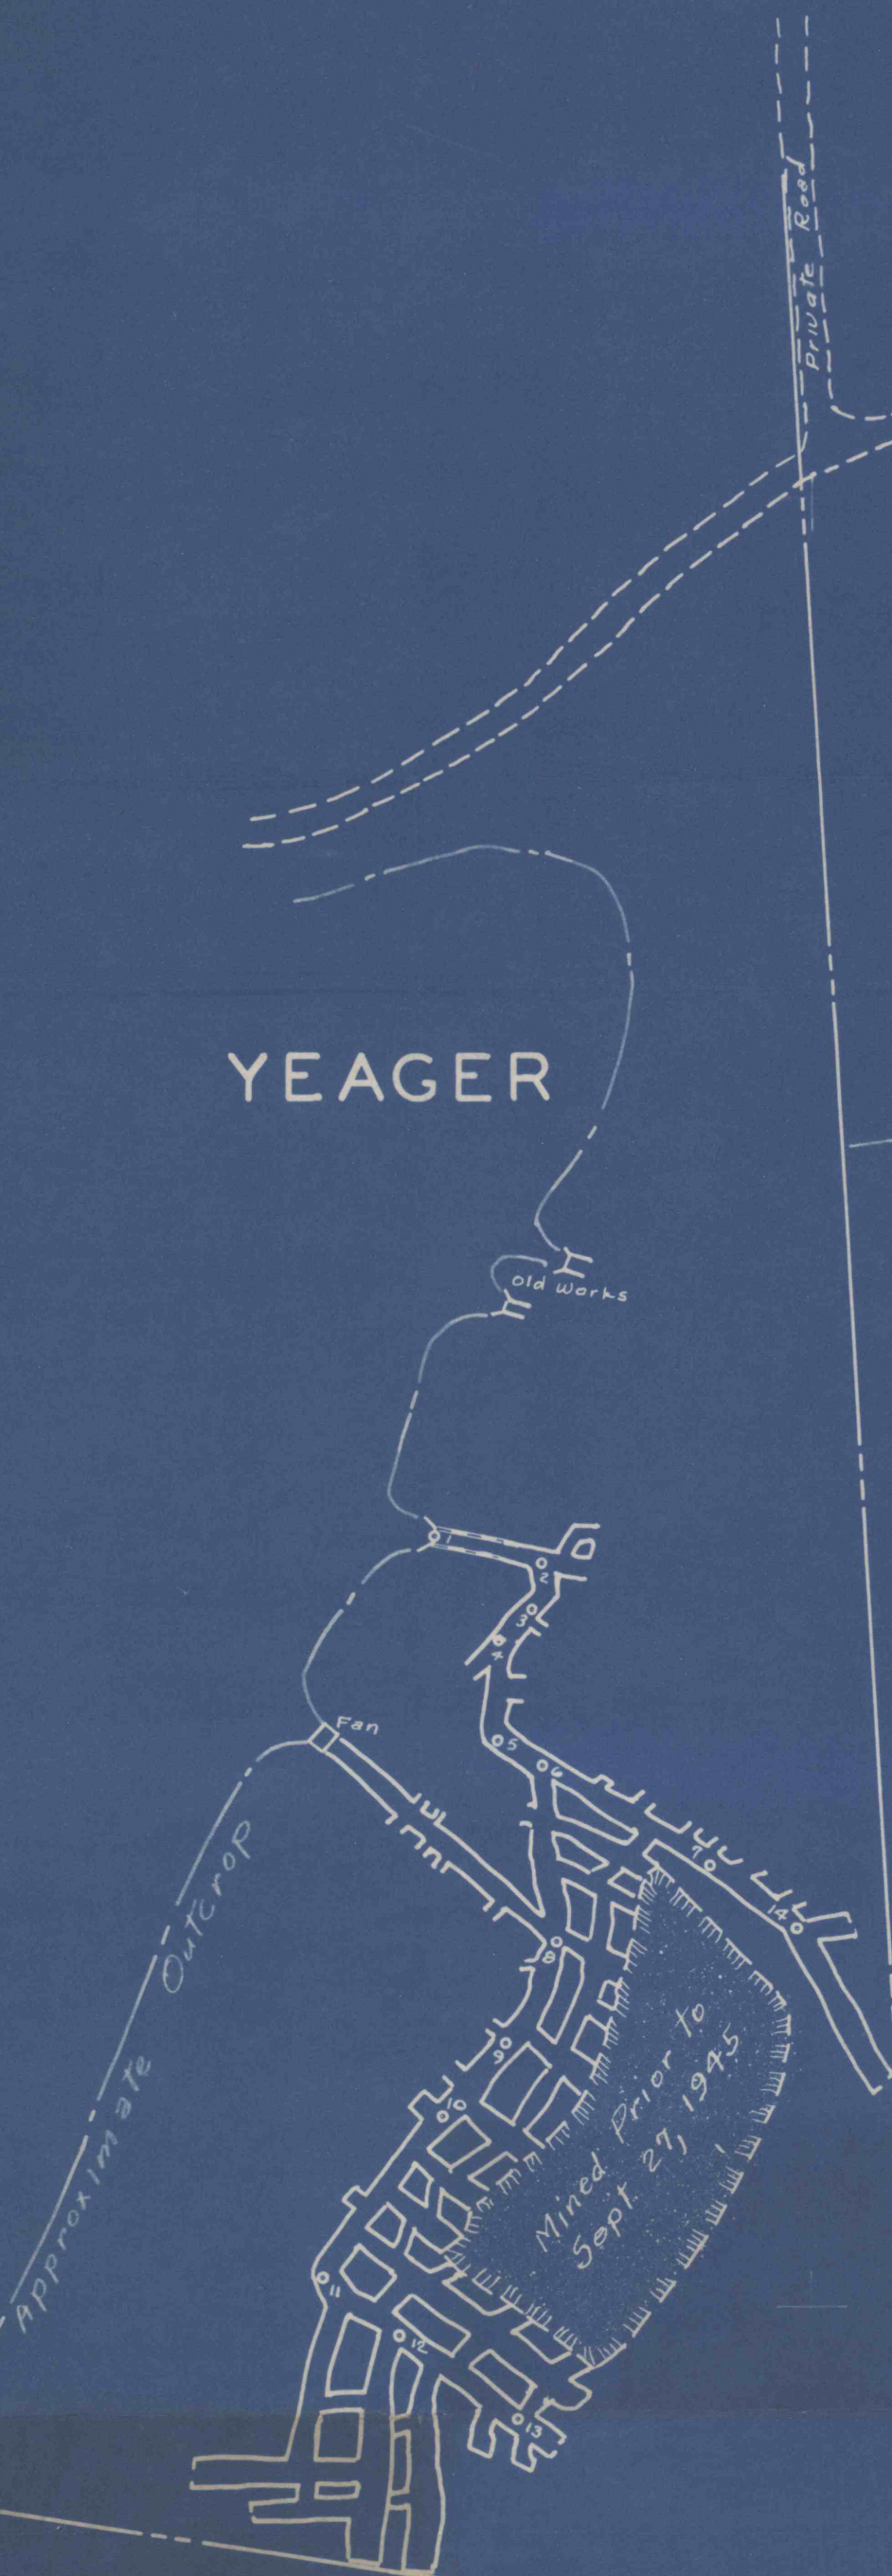

Lease Line

TOWNSHIP Road No. 365

Private Road

Barn



MINE MAP
DOBSON COAL CO.,
 MINE

OLIVER TOWNSHIP, JEFFERSON COUNTY, PA.,

SCALE 1 IN. = 100 FT. OCT., 1945
 WALTER J. ZIMMERMAN SURVEYOR,
 PUNXSUTAWNEY, PA.

