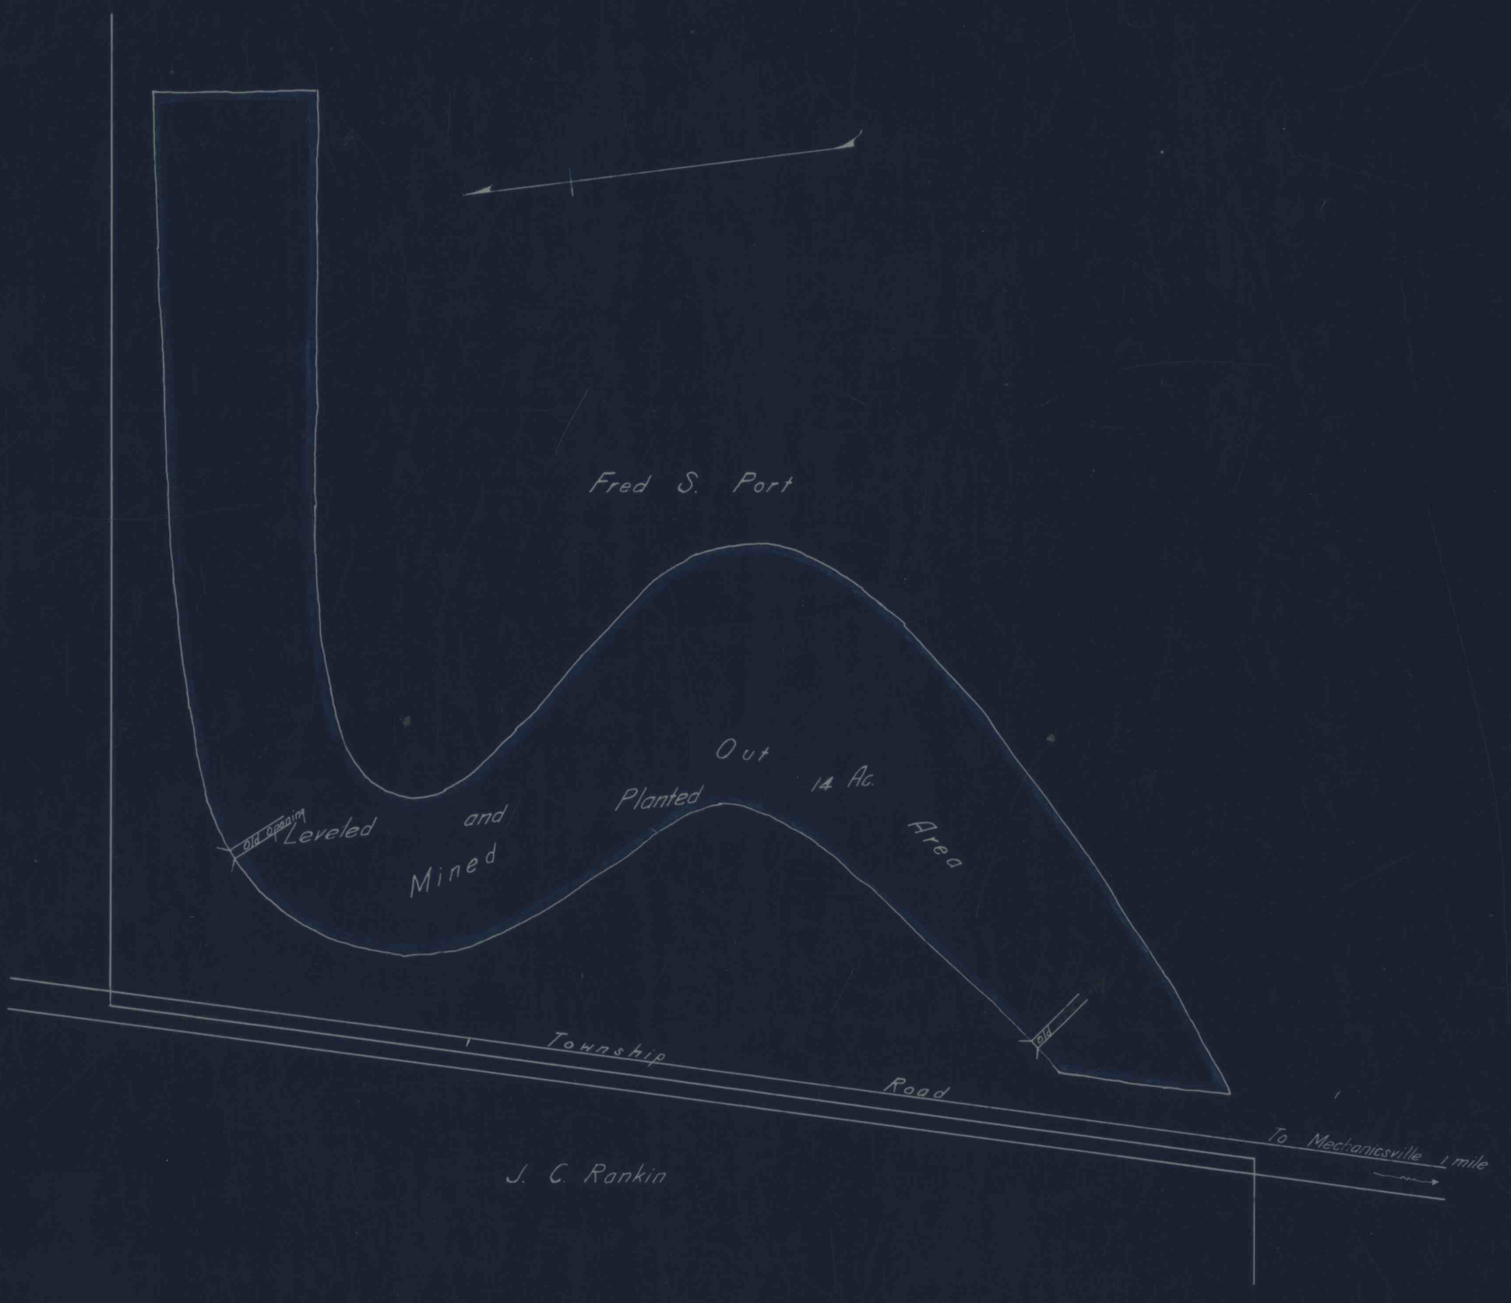

NOTE:

Name of Operation	-	Dell Mine
Average height High wall	-	40'
" " Coal Seam	-	34"
Operation Completed	-	Feb. 25. 1945
Area affected	-	14 Acres

CLARION COAL MINING CO.

Strip Mine Workings

Clarion Twp - Clarion Co. - Pennsylvania

Scale 1"=100' July 1945

Charles A. Imel Reg. Engr.
Clarion