


9

FILE 608

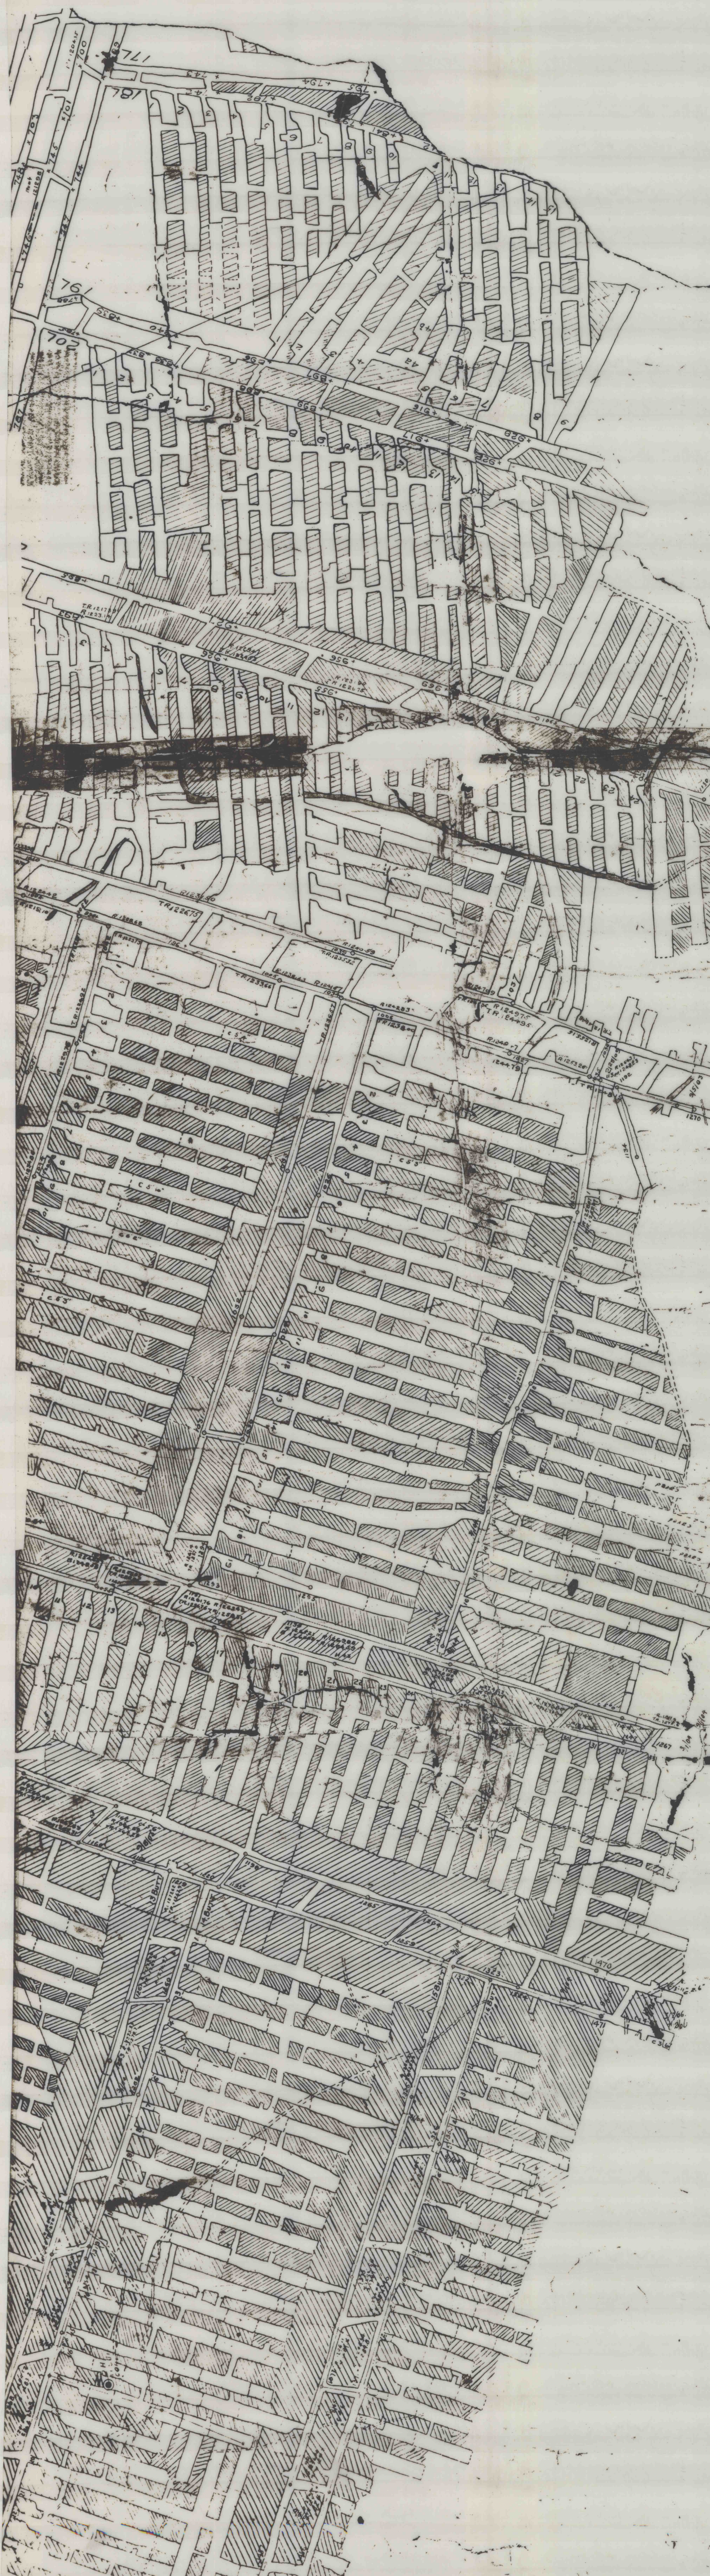

10/11/50  
J.P. Hall