


5

FILE 608

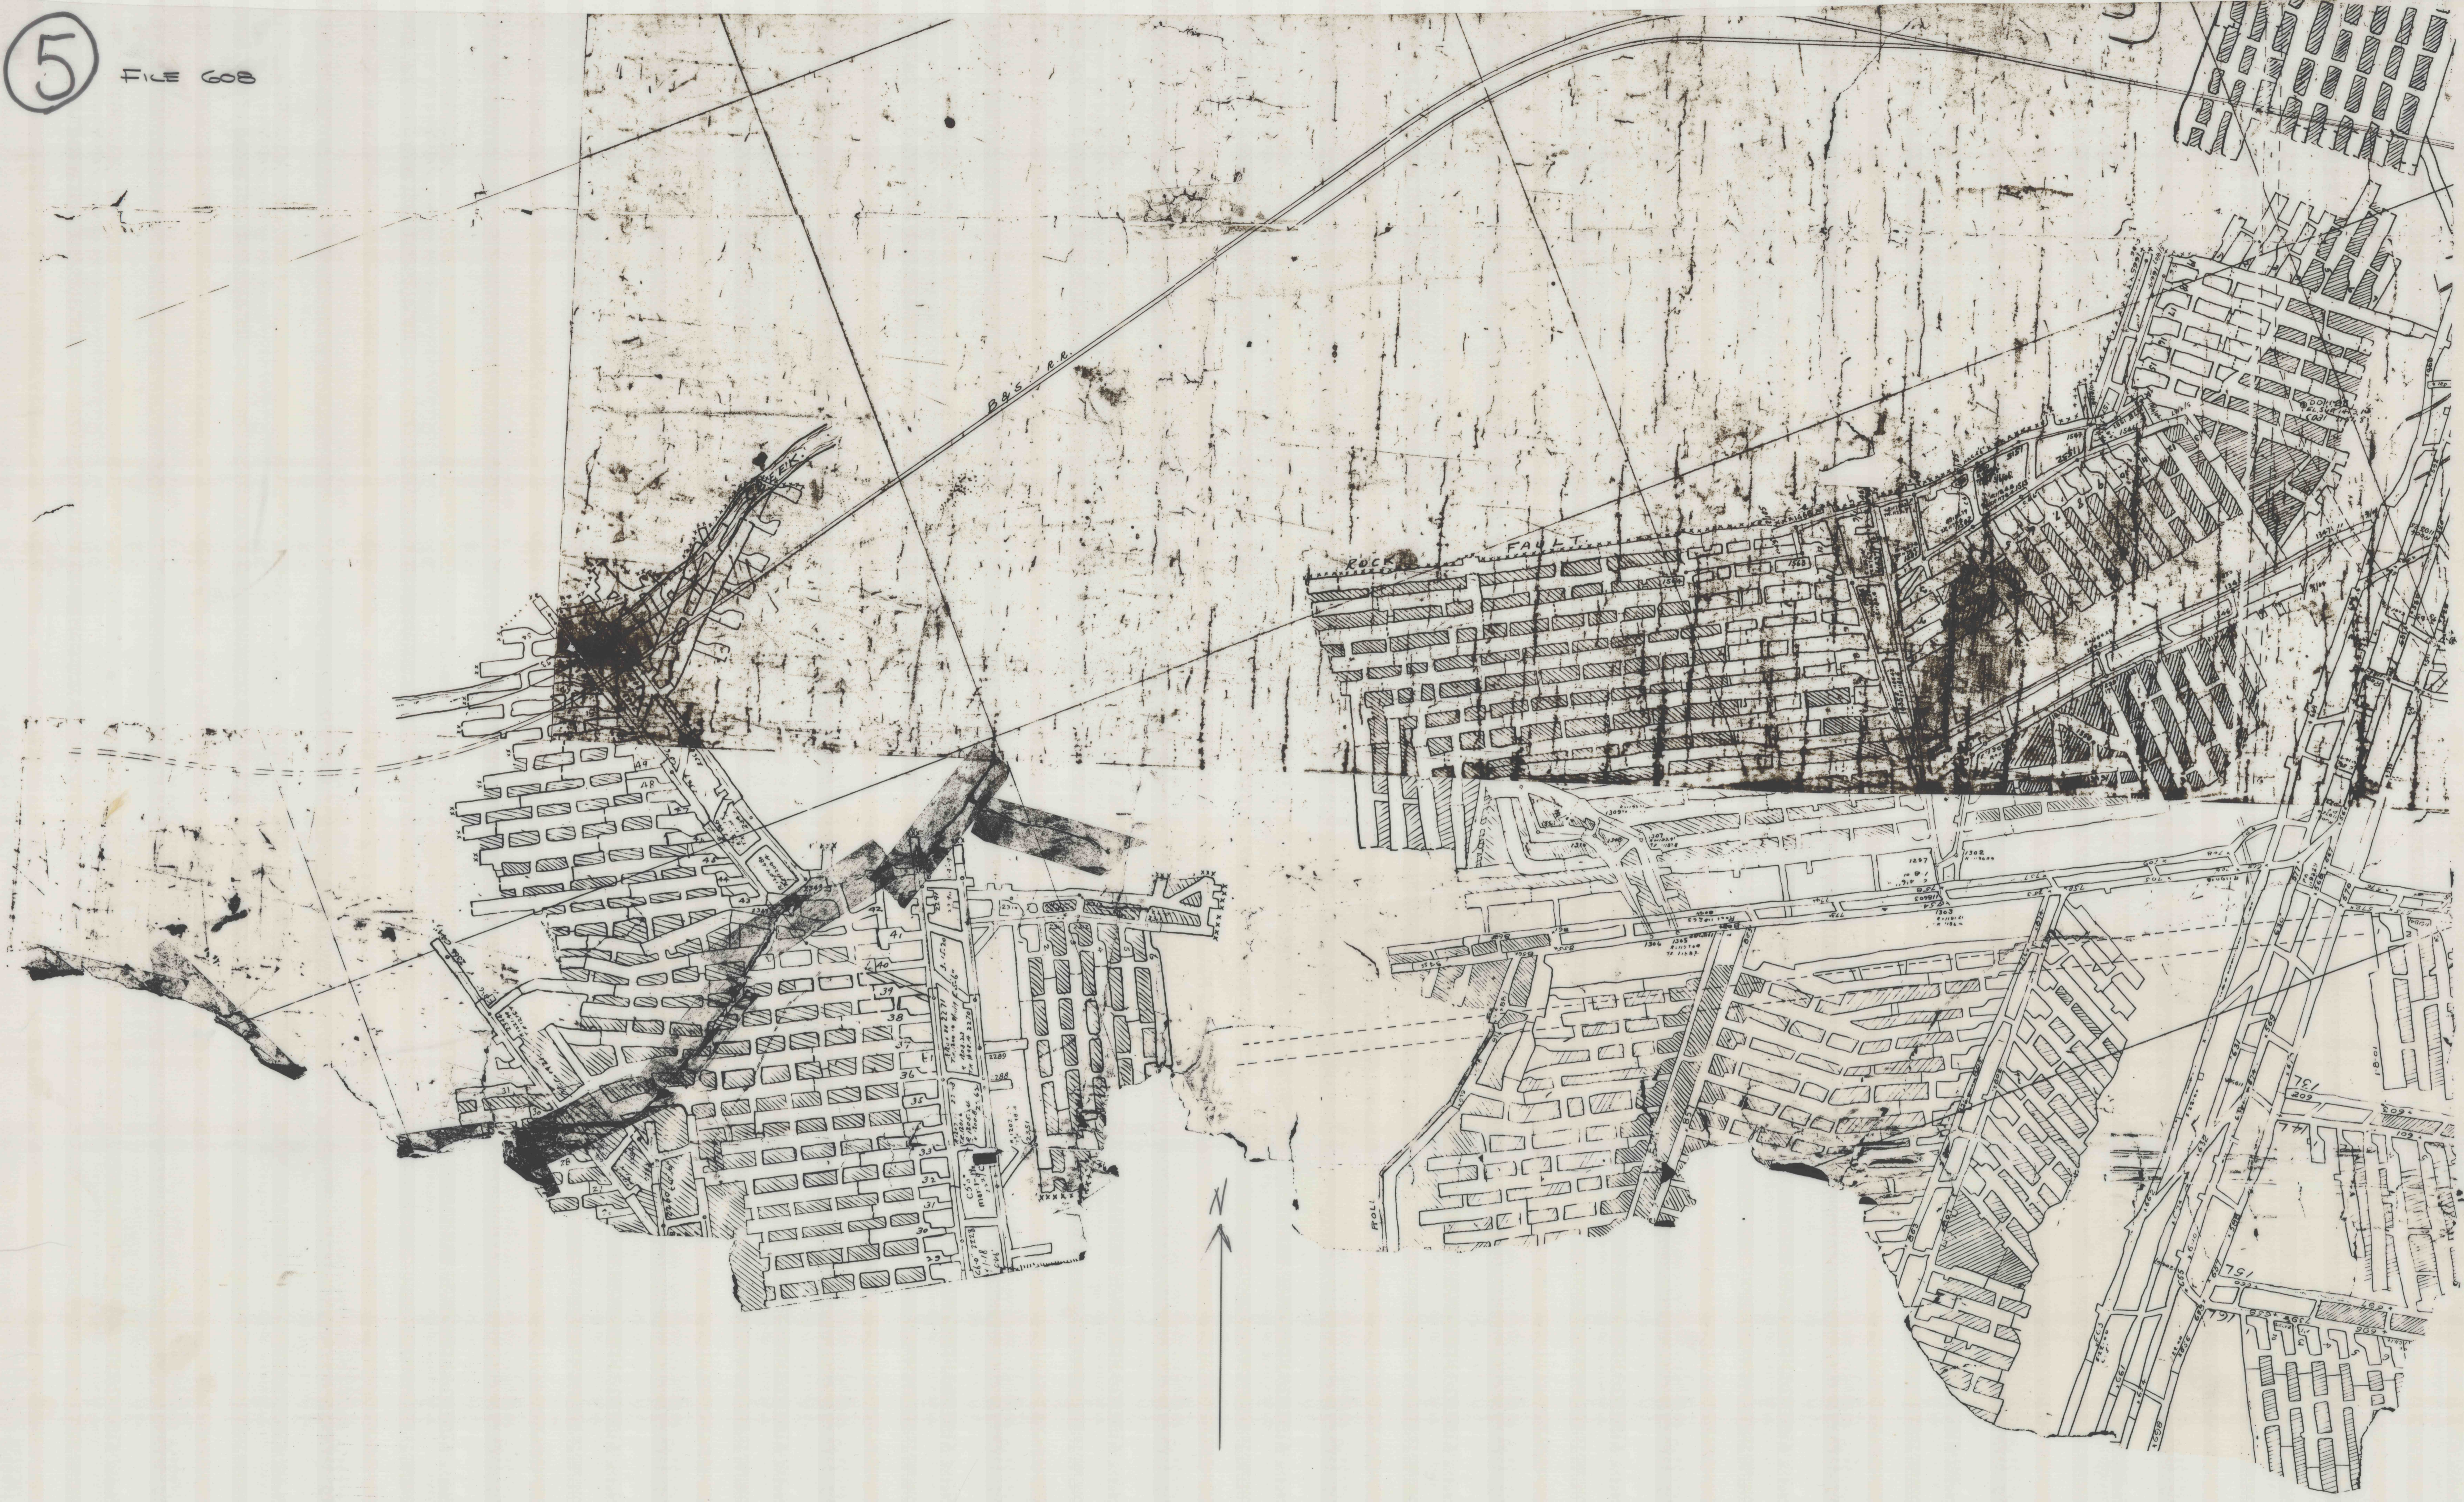

1345
