


15

FILE 609

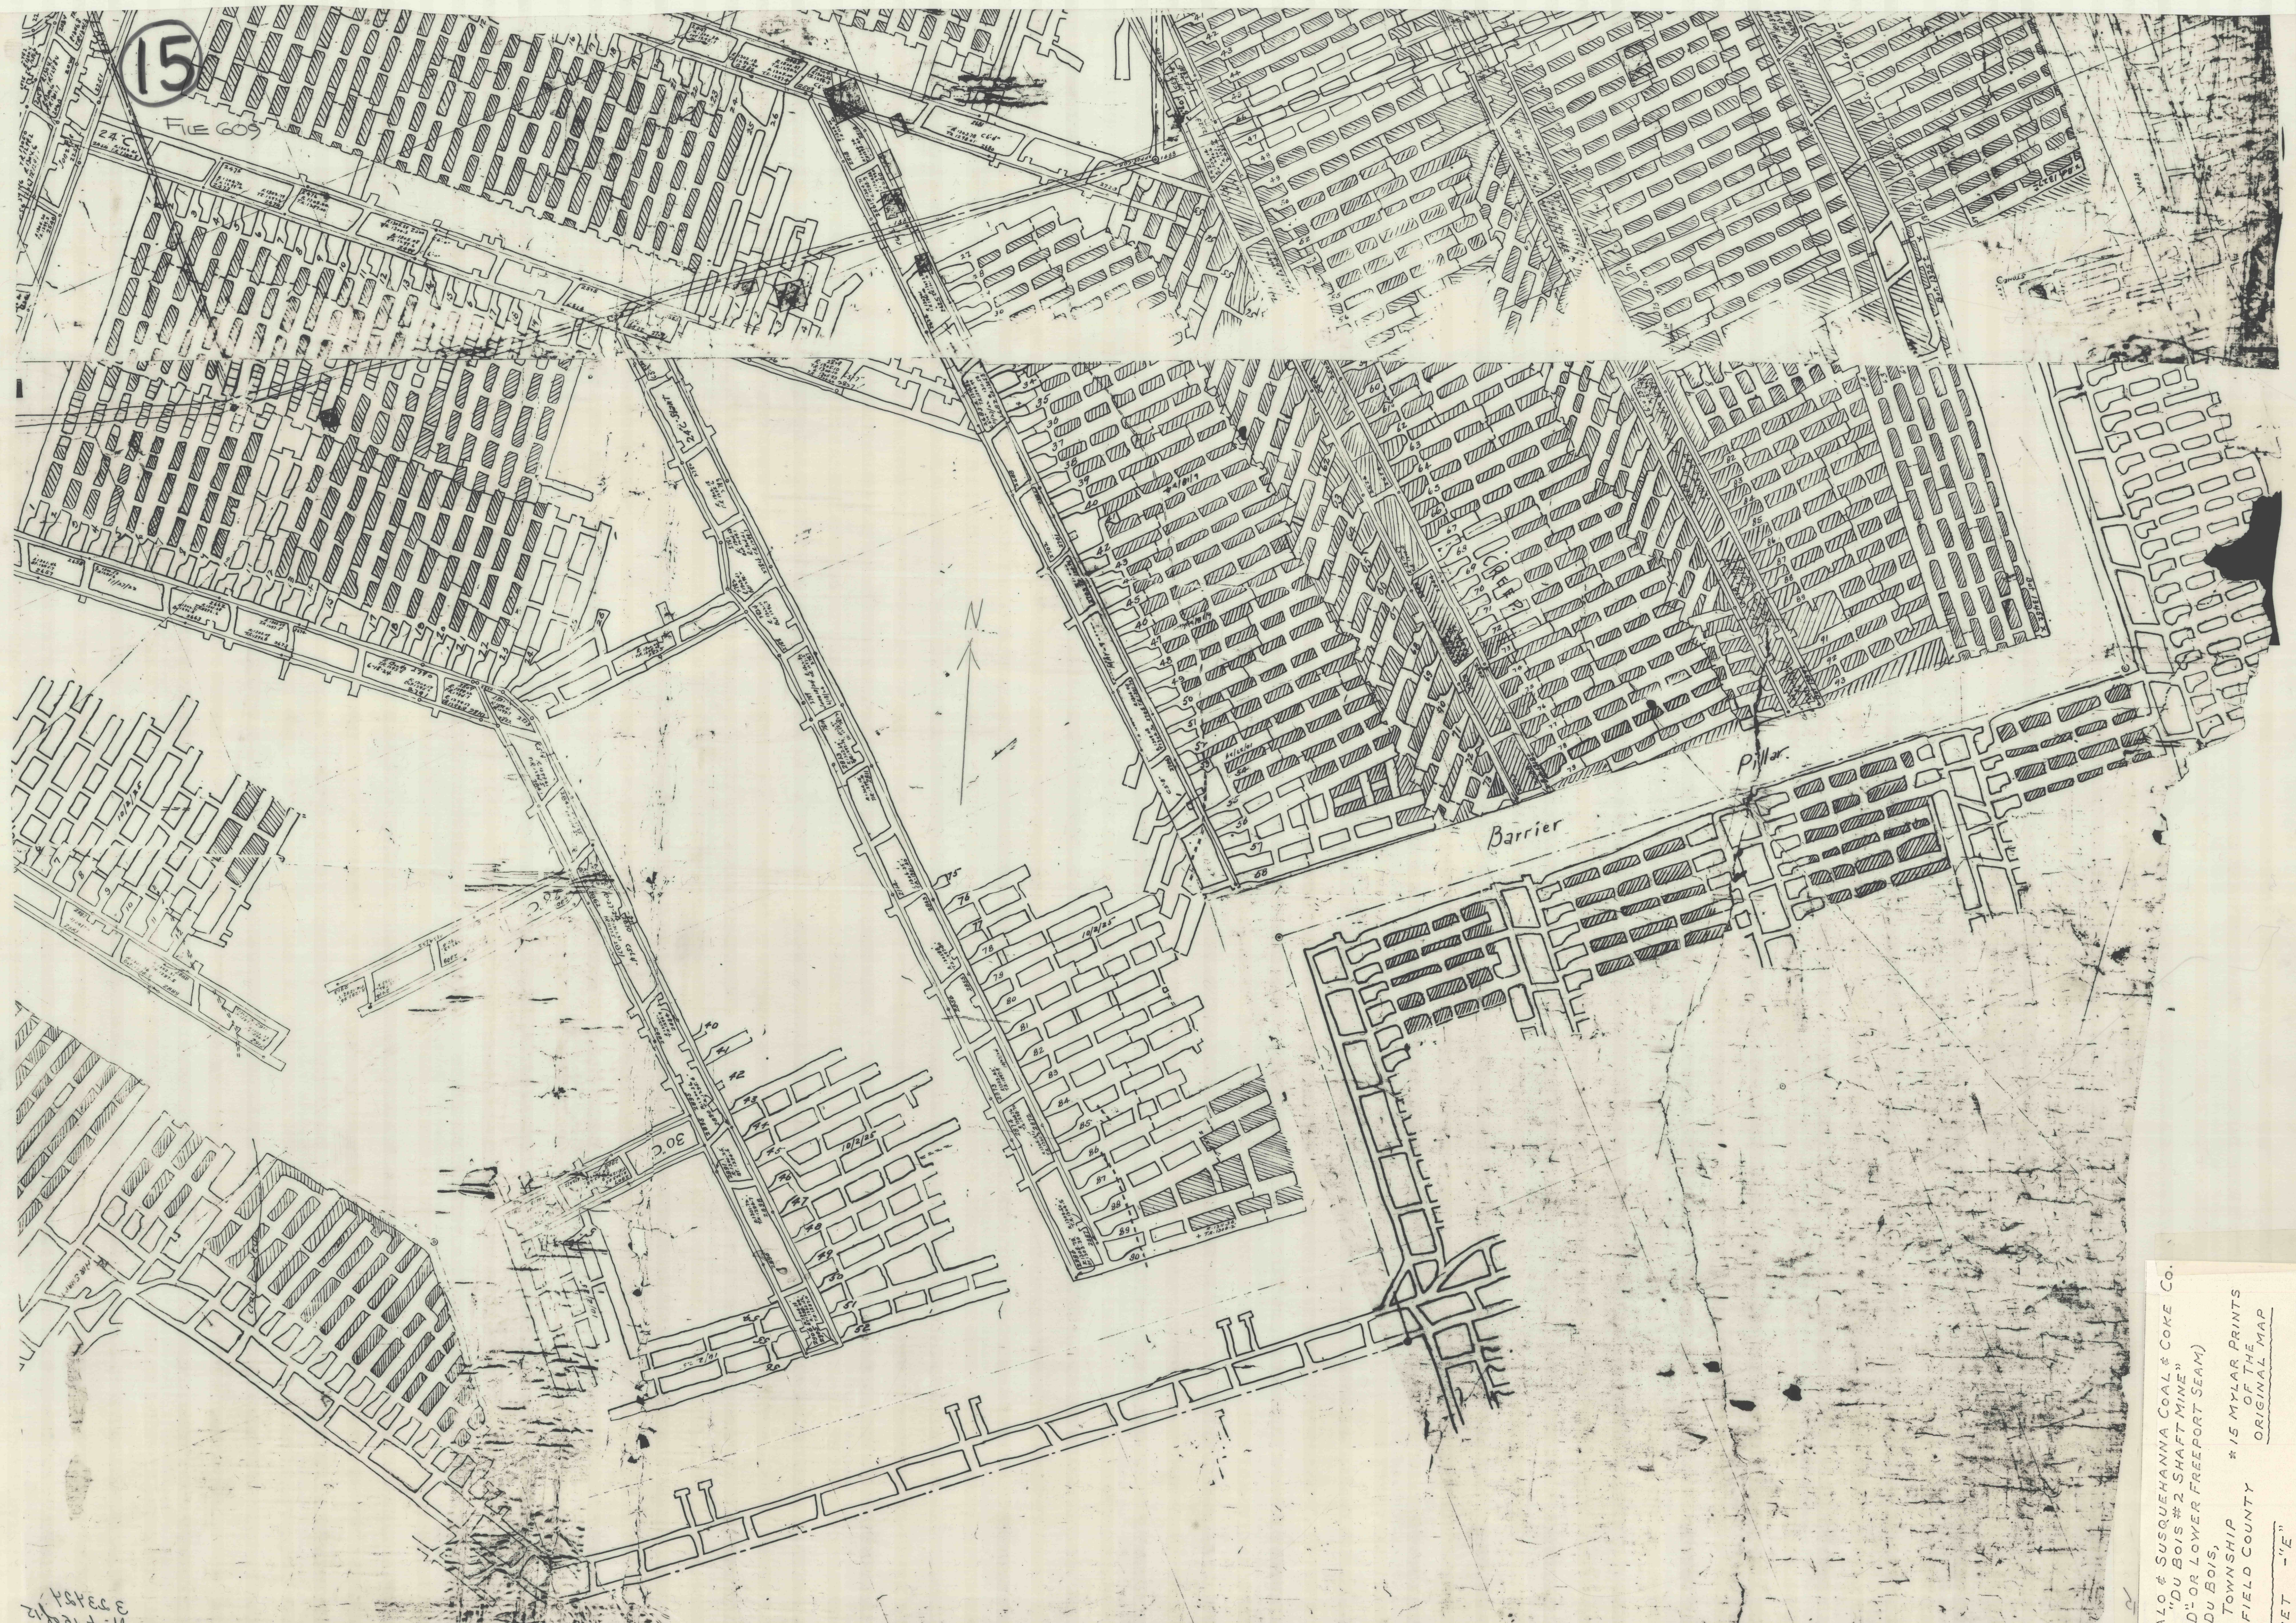

PSYCE
of 21 stall

NORTH-WESTERN MINING & MILLING CO.

BUFFALO & SUSQUEHANNA COAL & COKE CO.
 "DU BOIS #2 SHAFT MINE"
 ("D" OR LOWER FREEPORT SEAM)
 NEAR DU BOIS,
 SANDY TOWNSHIP
 CLEARFIELD COUNTY
 FILED
 CABINET "E"
 DRAWER No. - 1
 #894
 7-12-27
 C.C.
 ABANDONED - APRIL 30, 1928