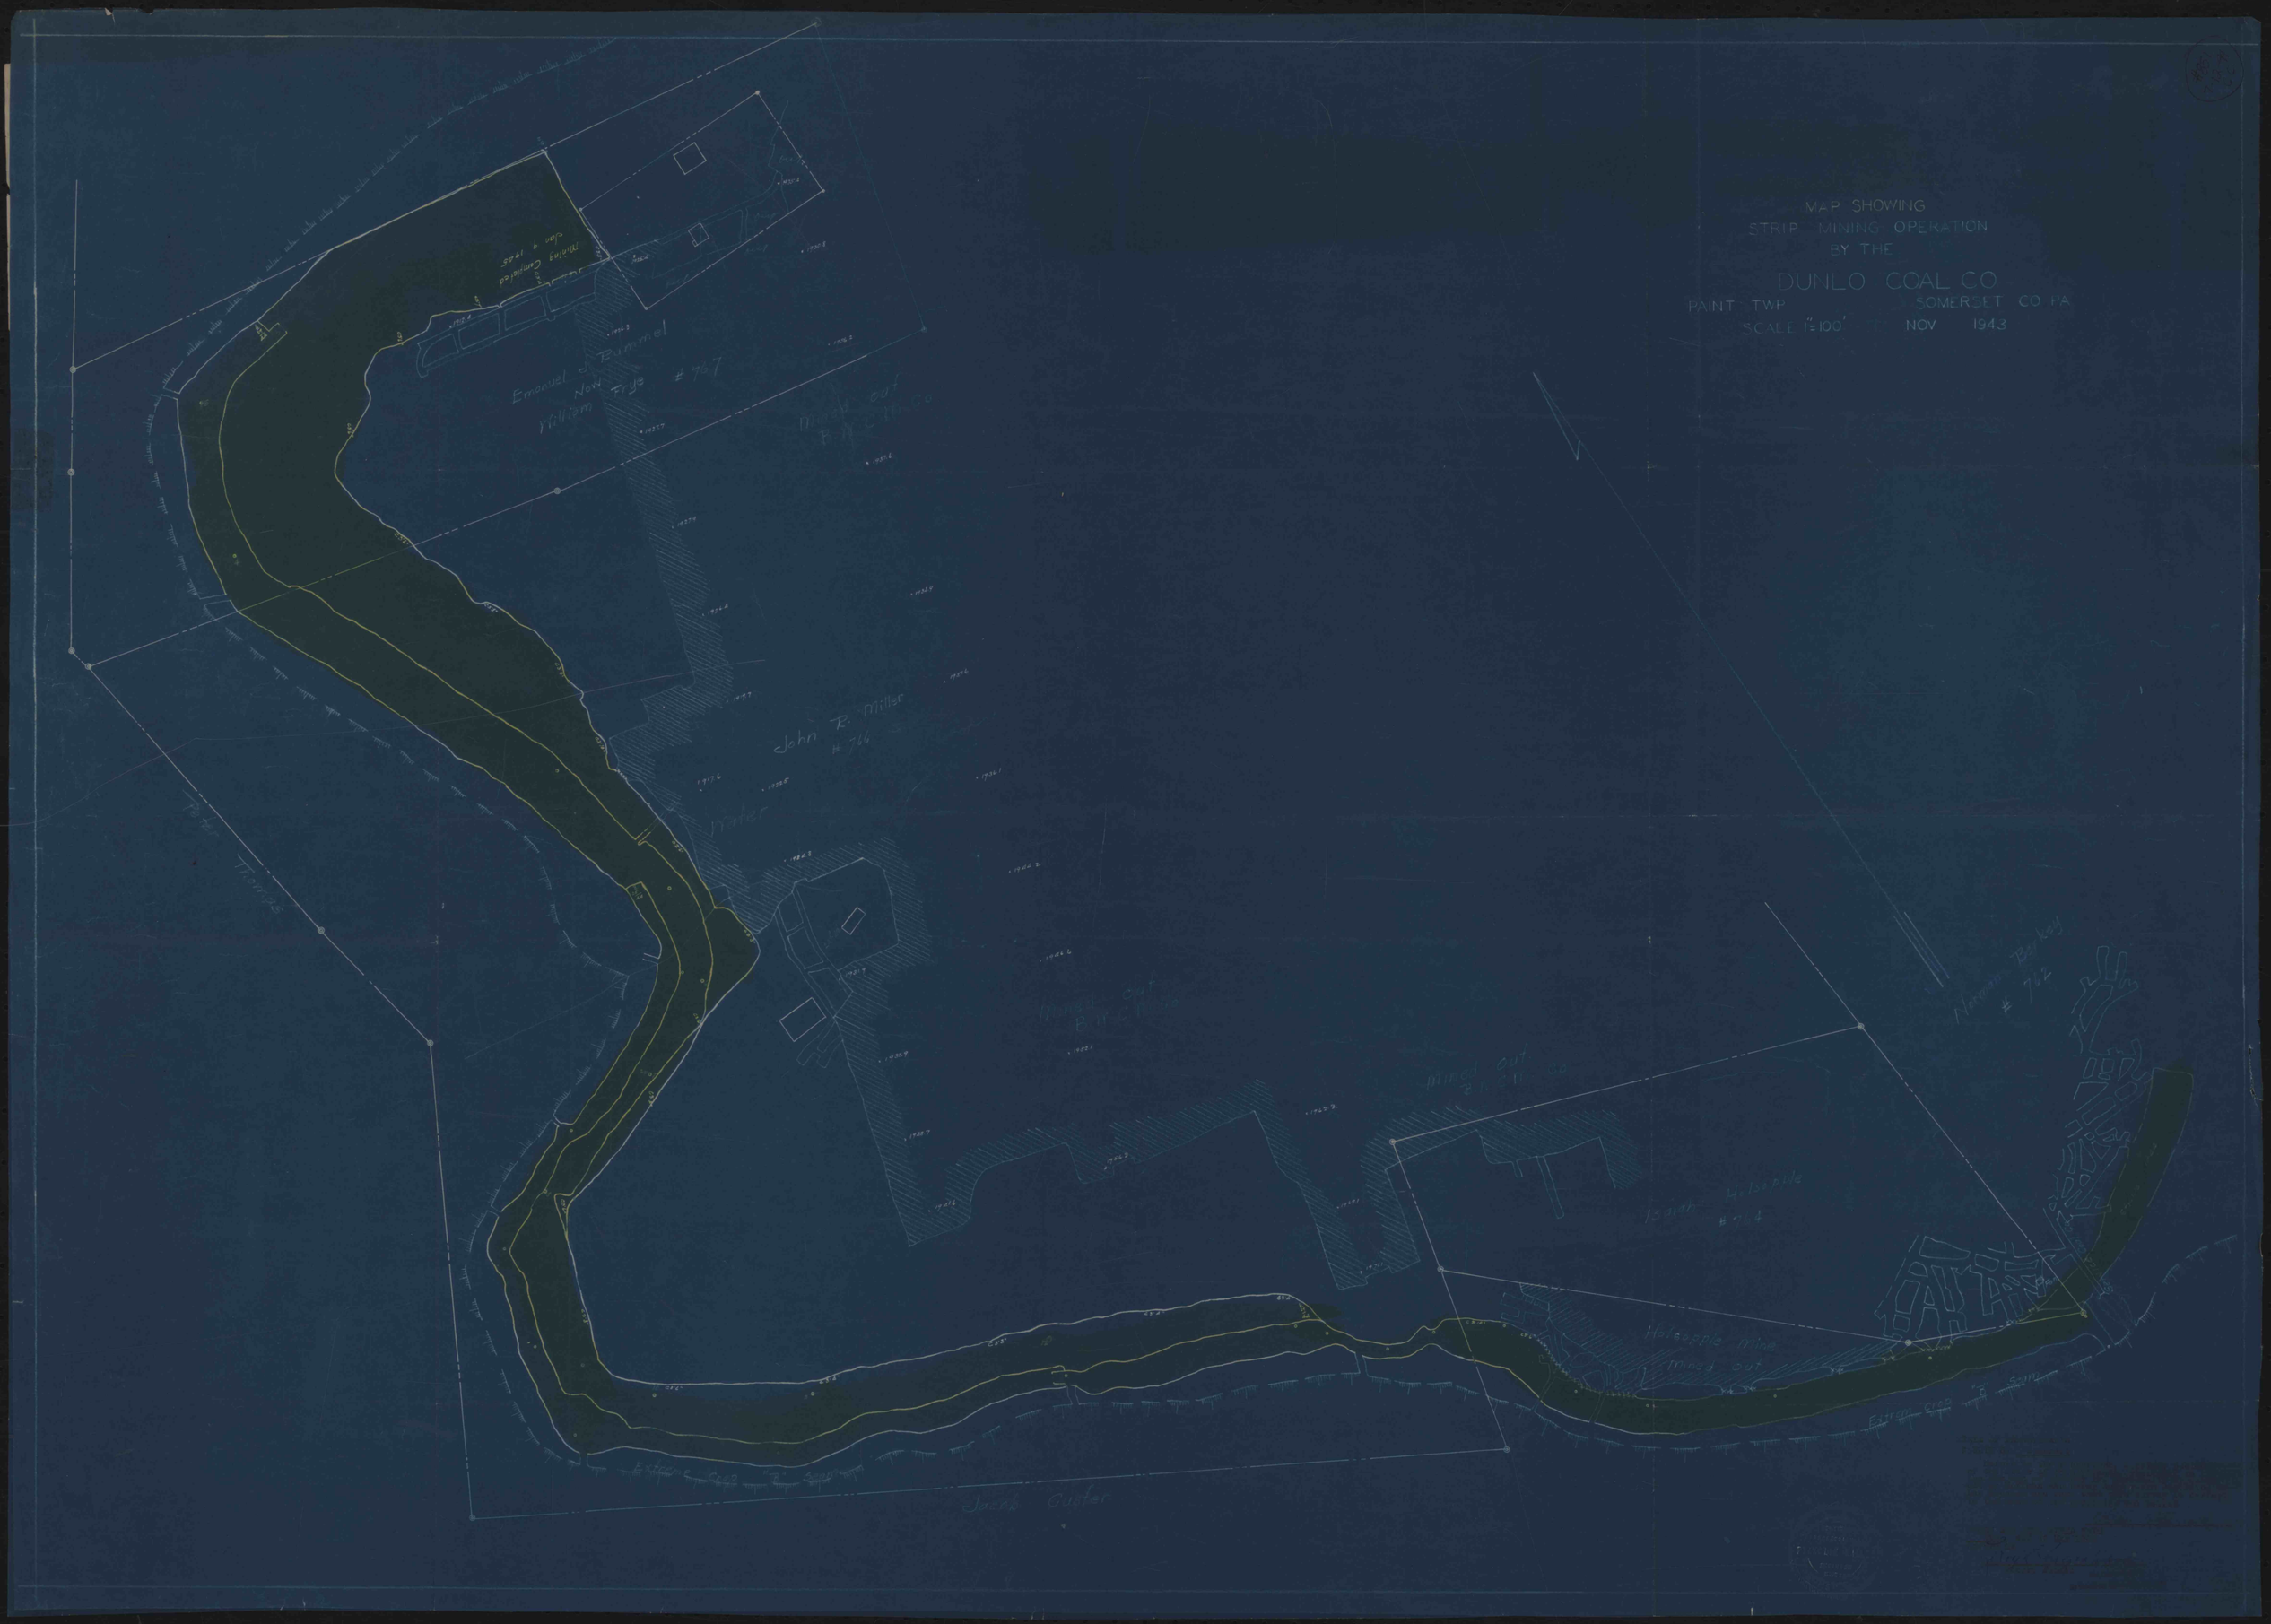
MAP SHOWING
STRIP MINING OPERATION
BY THE
DUNLO COAL CO
PAINT TWP
SOMERSET CO PA
SCALE 1"=100'
NOV 1943
Emanuel J. Rummel
William Frye #767
John R. Miller
#766
Mined out
Isaiah Holsopple
#764
Holsopple Mine
Mined out
Norman Berkey
#762
Jacob Custer