
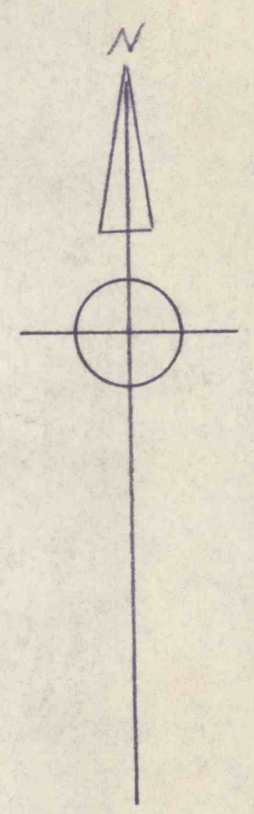


SUPPORT DETAIL VERNON WOLFE HOUSE

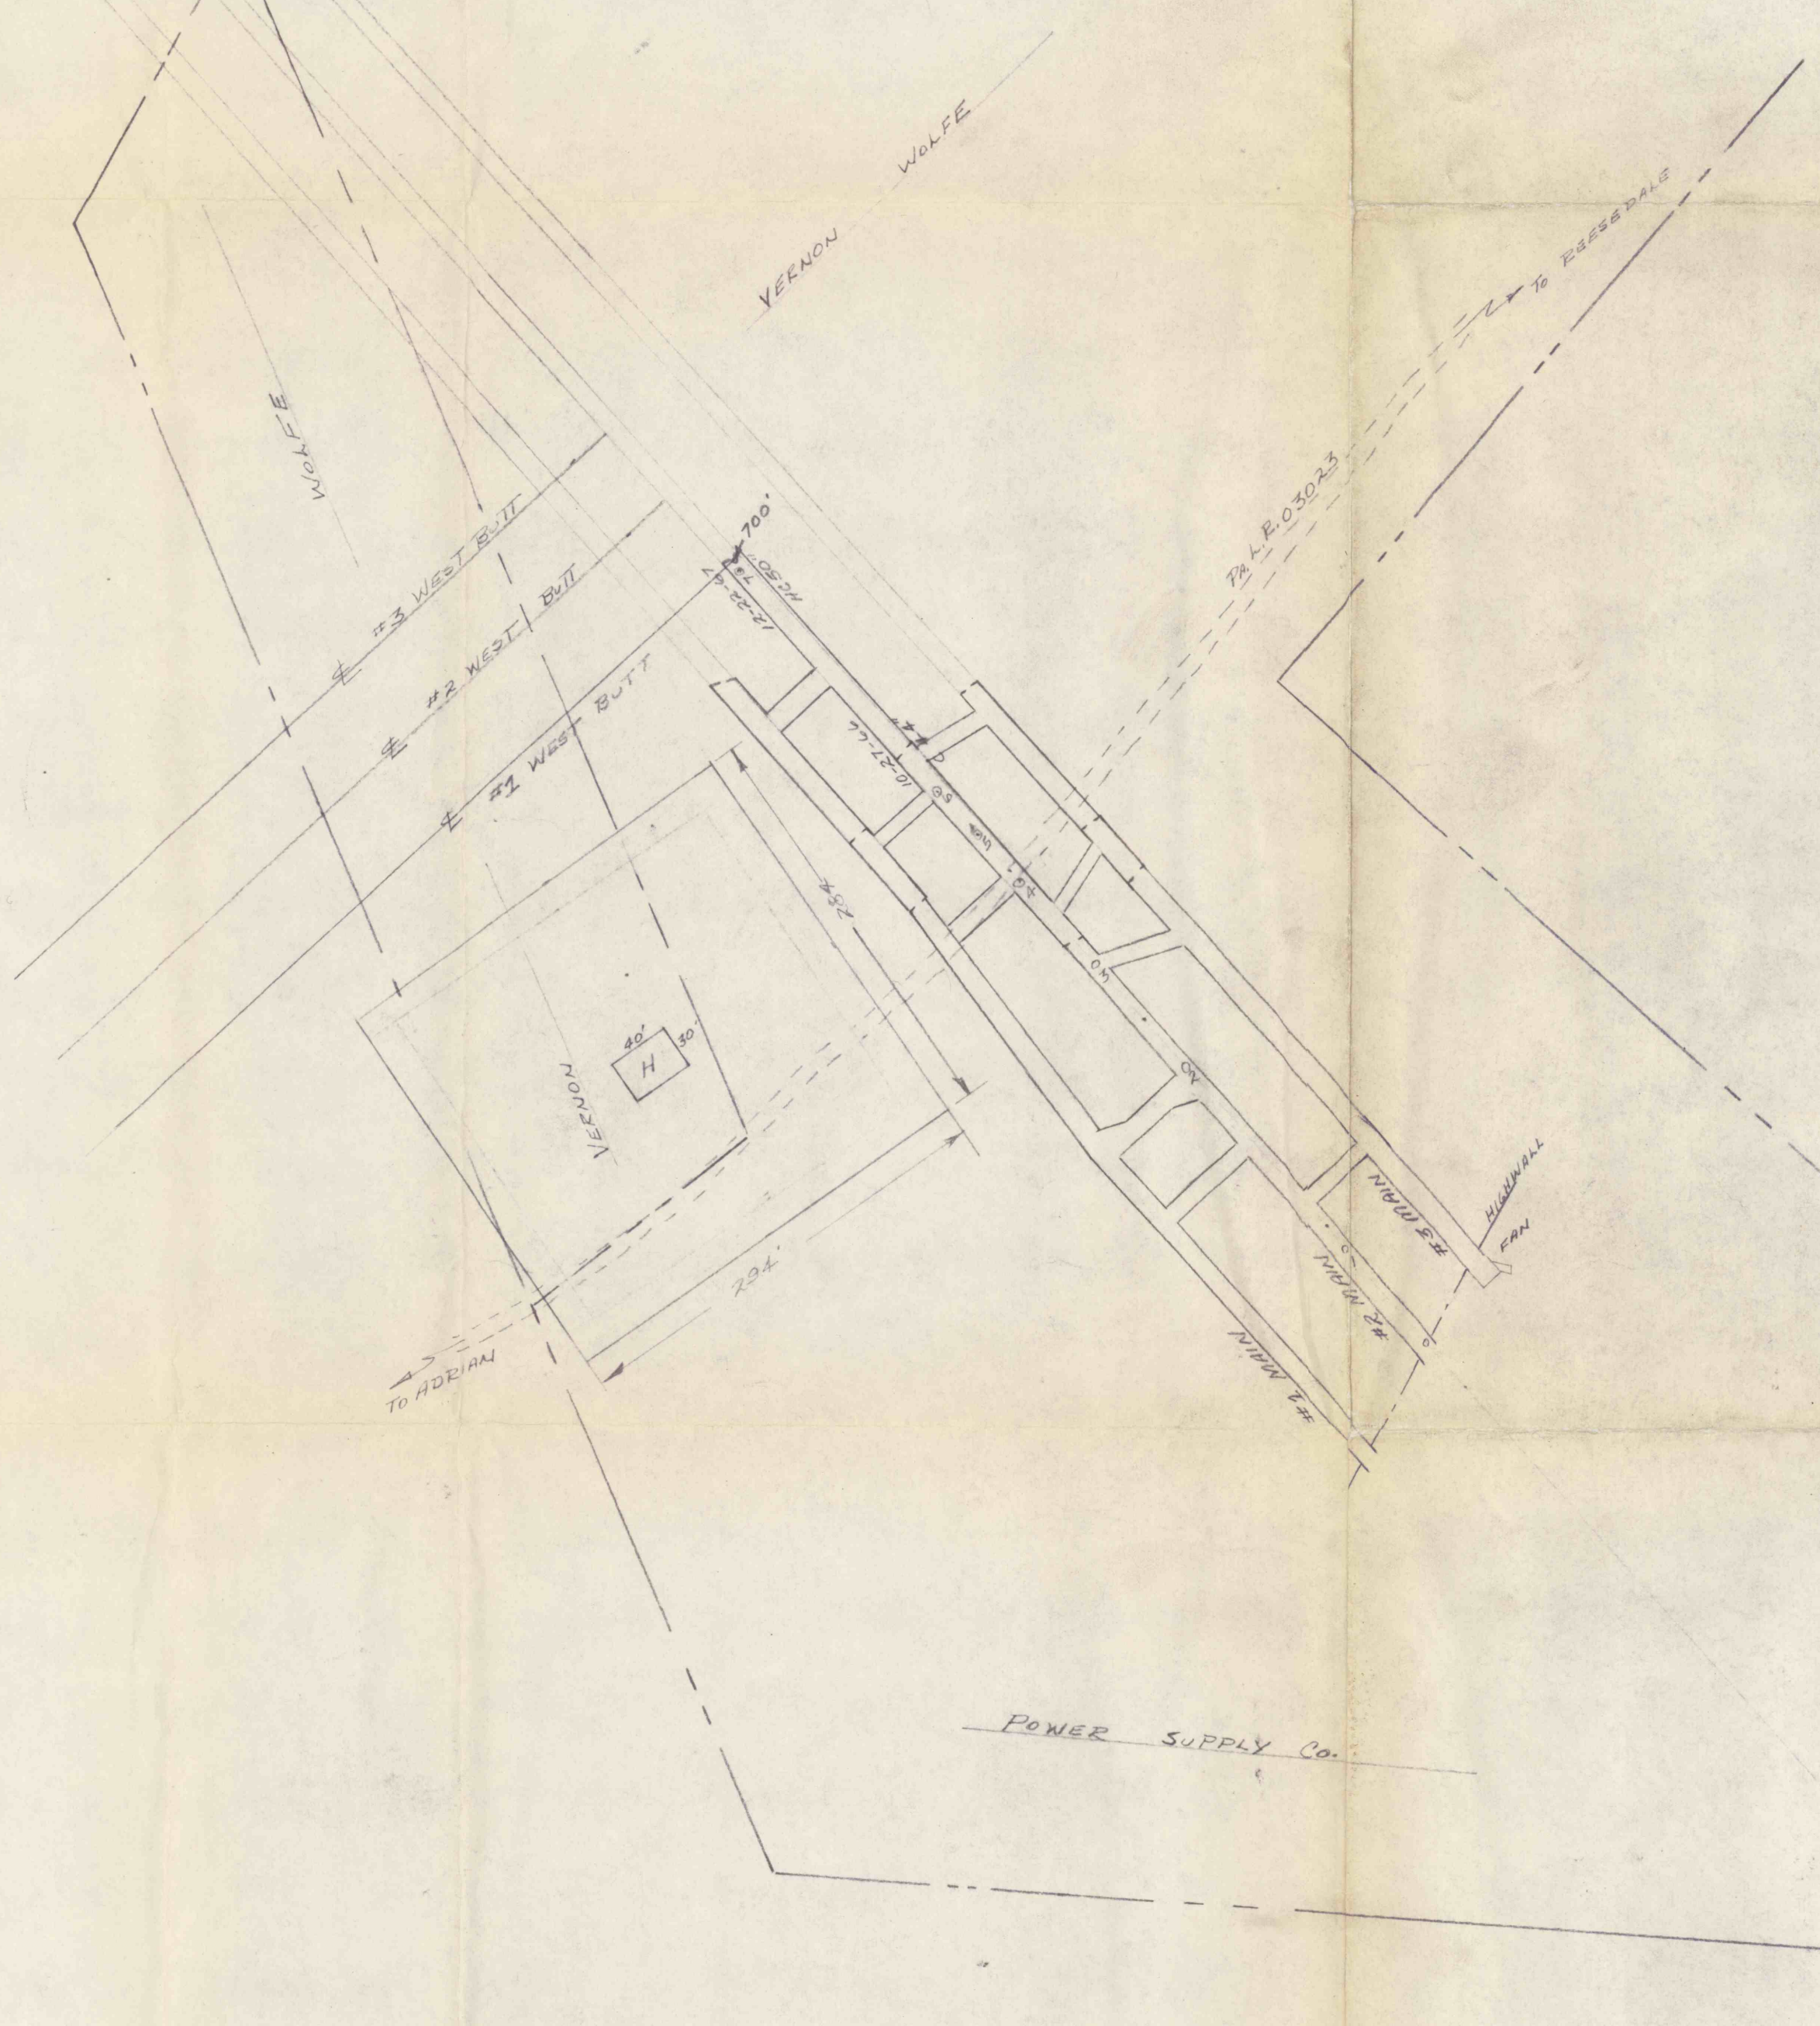

MINE MAP FOR DURIEZ COAL Co., INC.  
 WASHINGTON TWP., ARMSTRONG Co., PENNA.  
 SEPTEMBER 1966 SCALE: 1" = 100'

*J. M. Young*

#852  
 7-12-99  
 C.C.