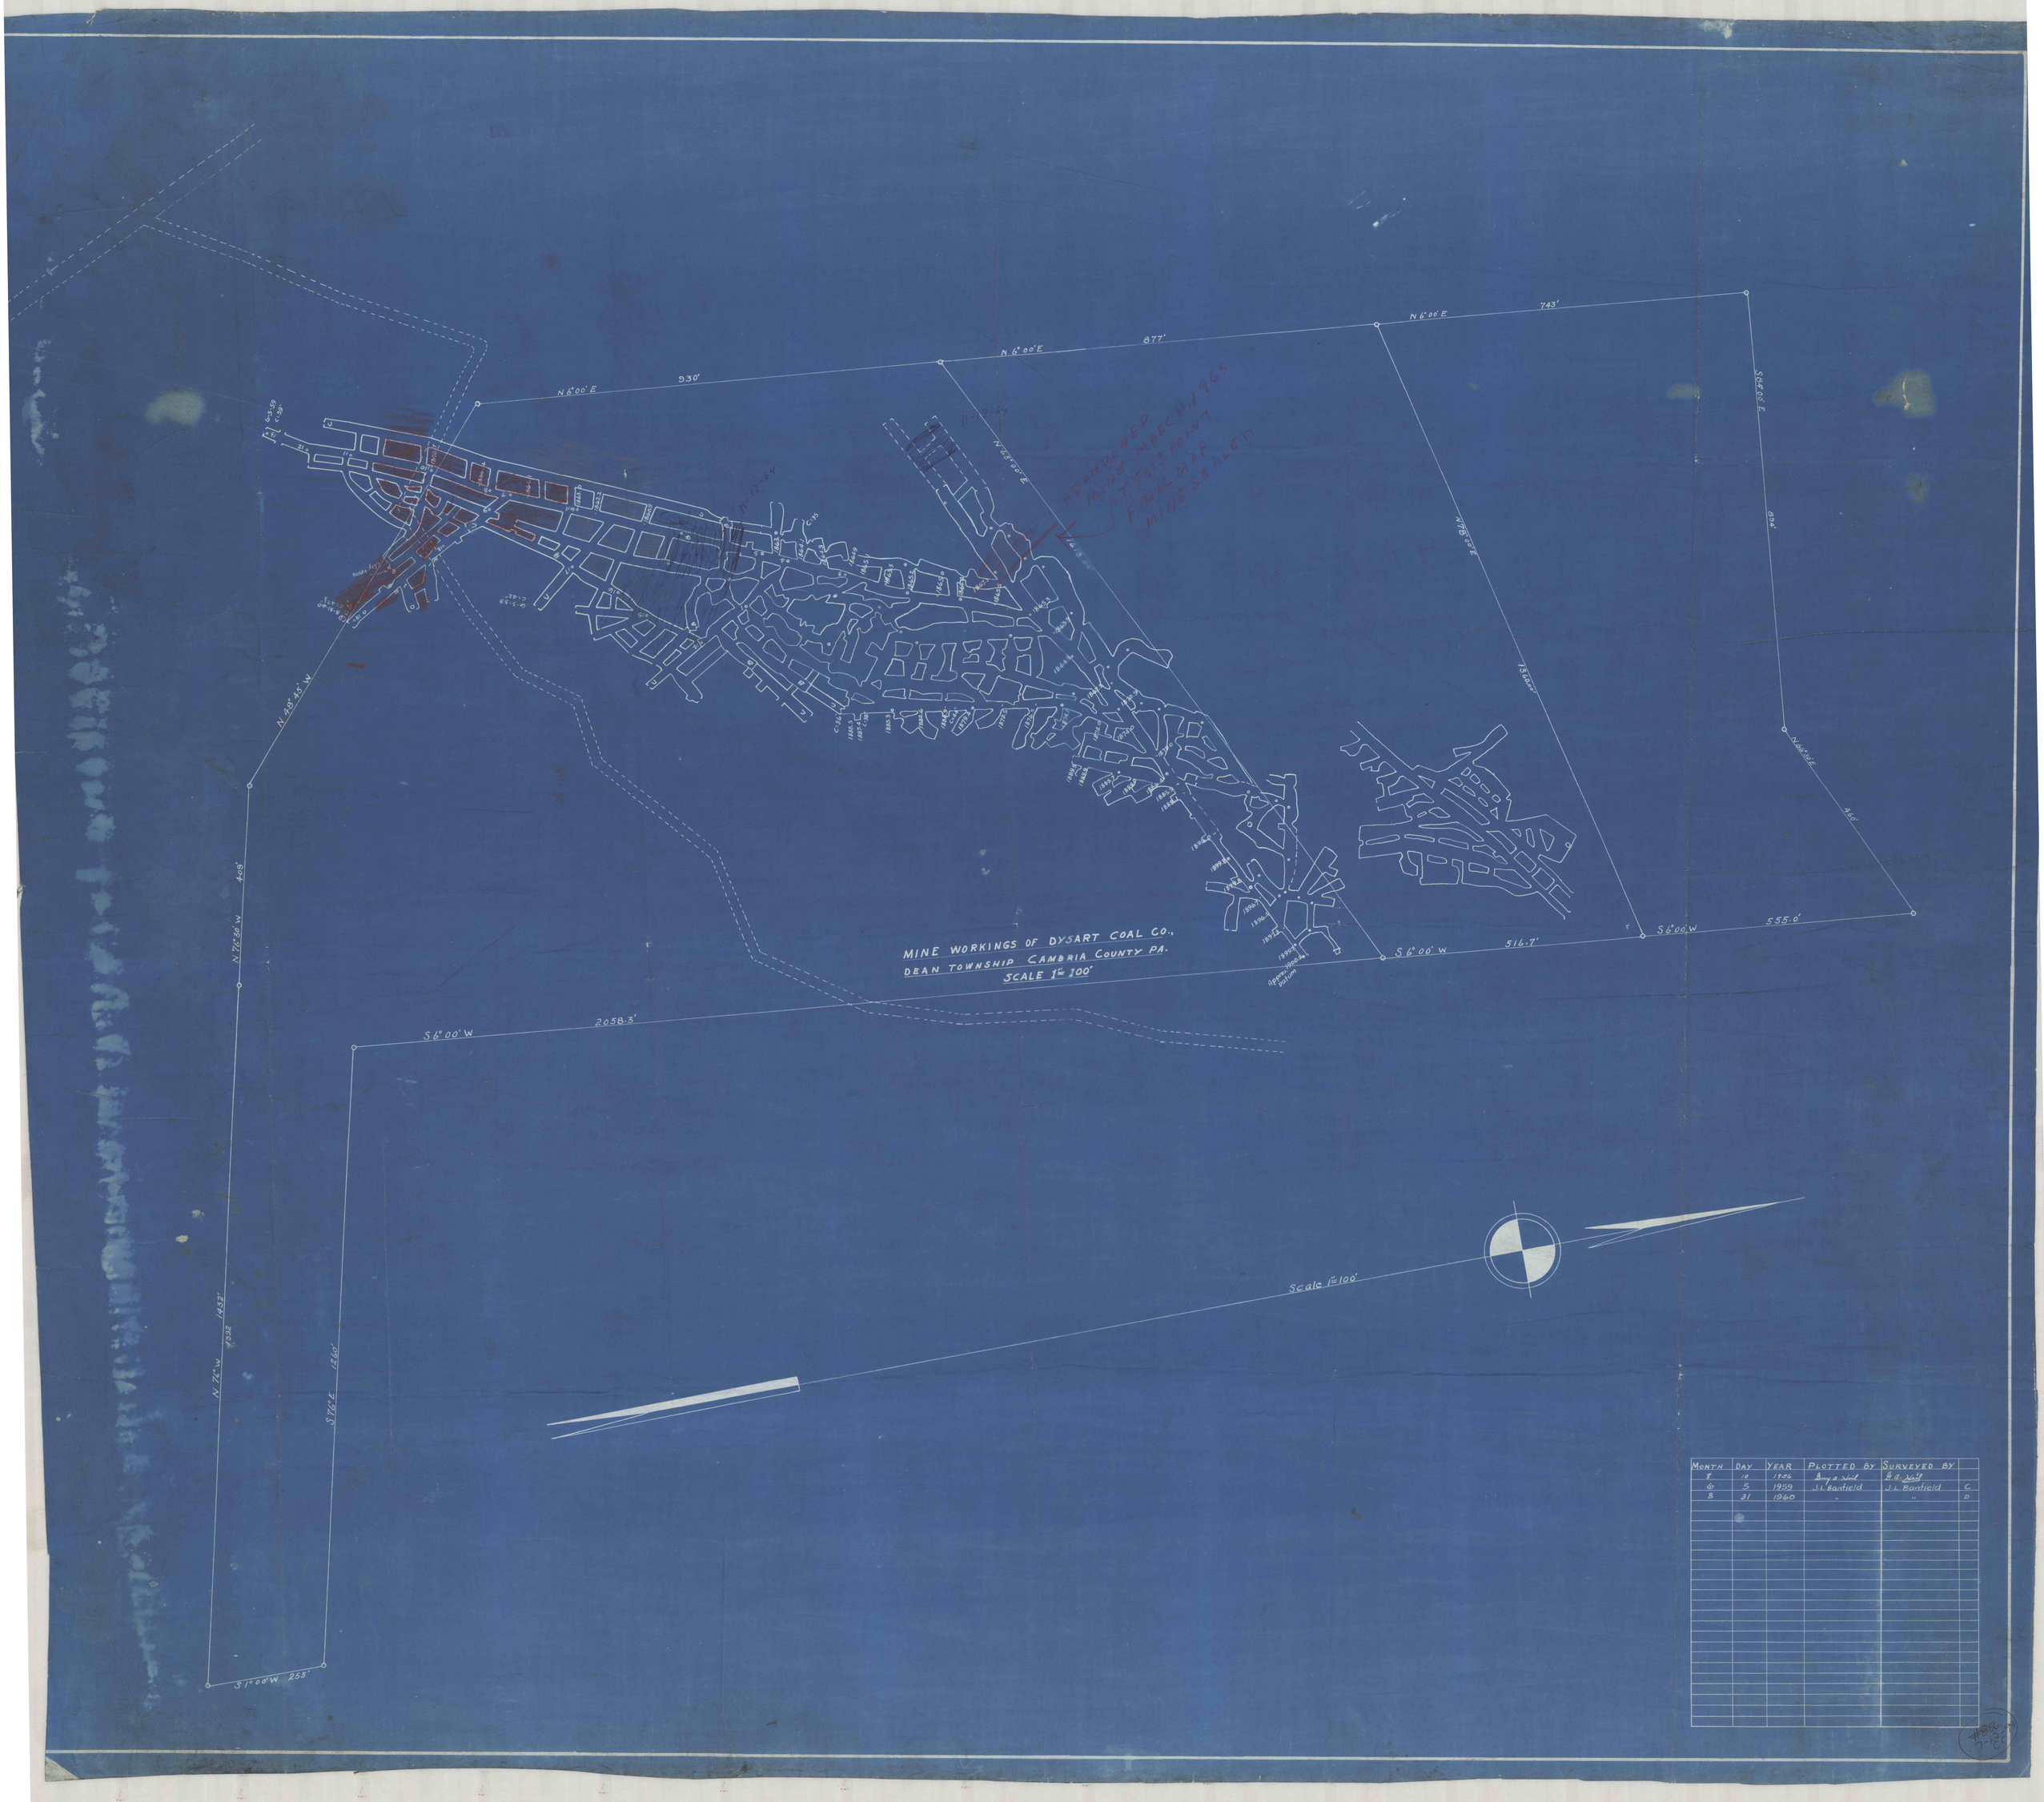

MONTH	DAY	YEAR	PLOTTED BY	SURVEYED BY	
8	10	1956	Guy A. Neil	G. A. Neil	
6	5	1959	J. L. Banfield	J. L. Banfield	C
8	31	1960	"	"	D