


MITCHELL ESTATE

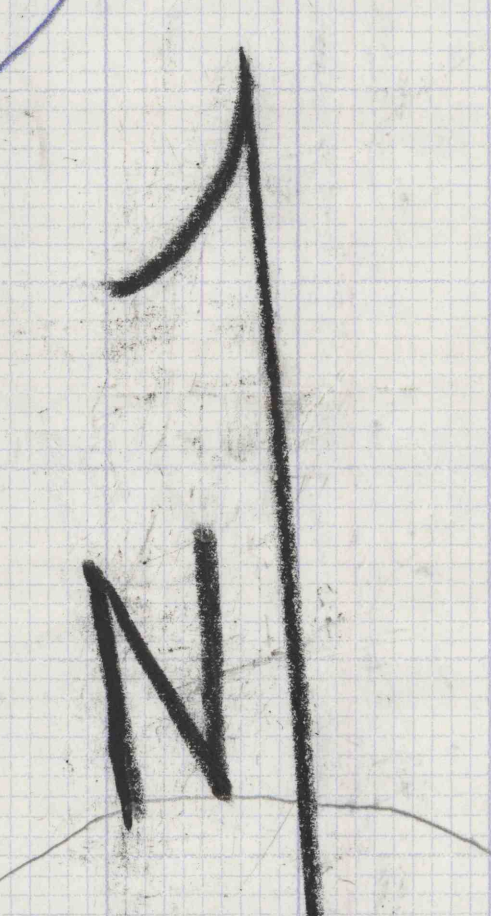

1892
1895

1896

Samuel Jordan

James Wrigley

Peters
Mines
"E" coal

10"

Eyre Galleries Co.
Eagle #1 mine

"C" coal

Scale: 1" = 100'

(add 's to all numbers in field)

W RIGLEY

Wrigley
mine
"D" coal

McGoey

GRAHAM

Graham
mine
"E" coal

TATE

ISAAC
JOHNSON



Eyre Galleries Co.
Eagle #1 mine
CREATED 12/24
HILSDNER CREW
RICHIE
C.F. CO
LAWRENCE LMP

