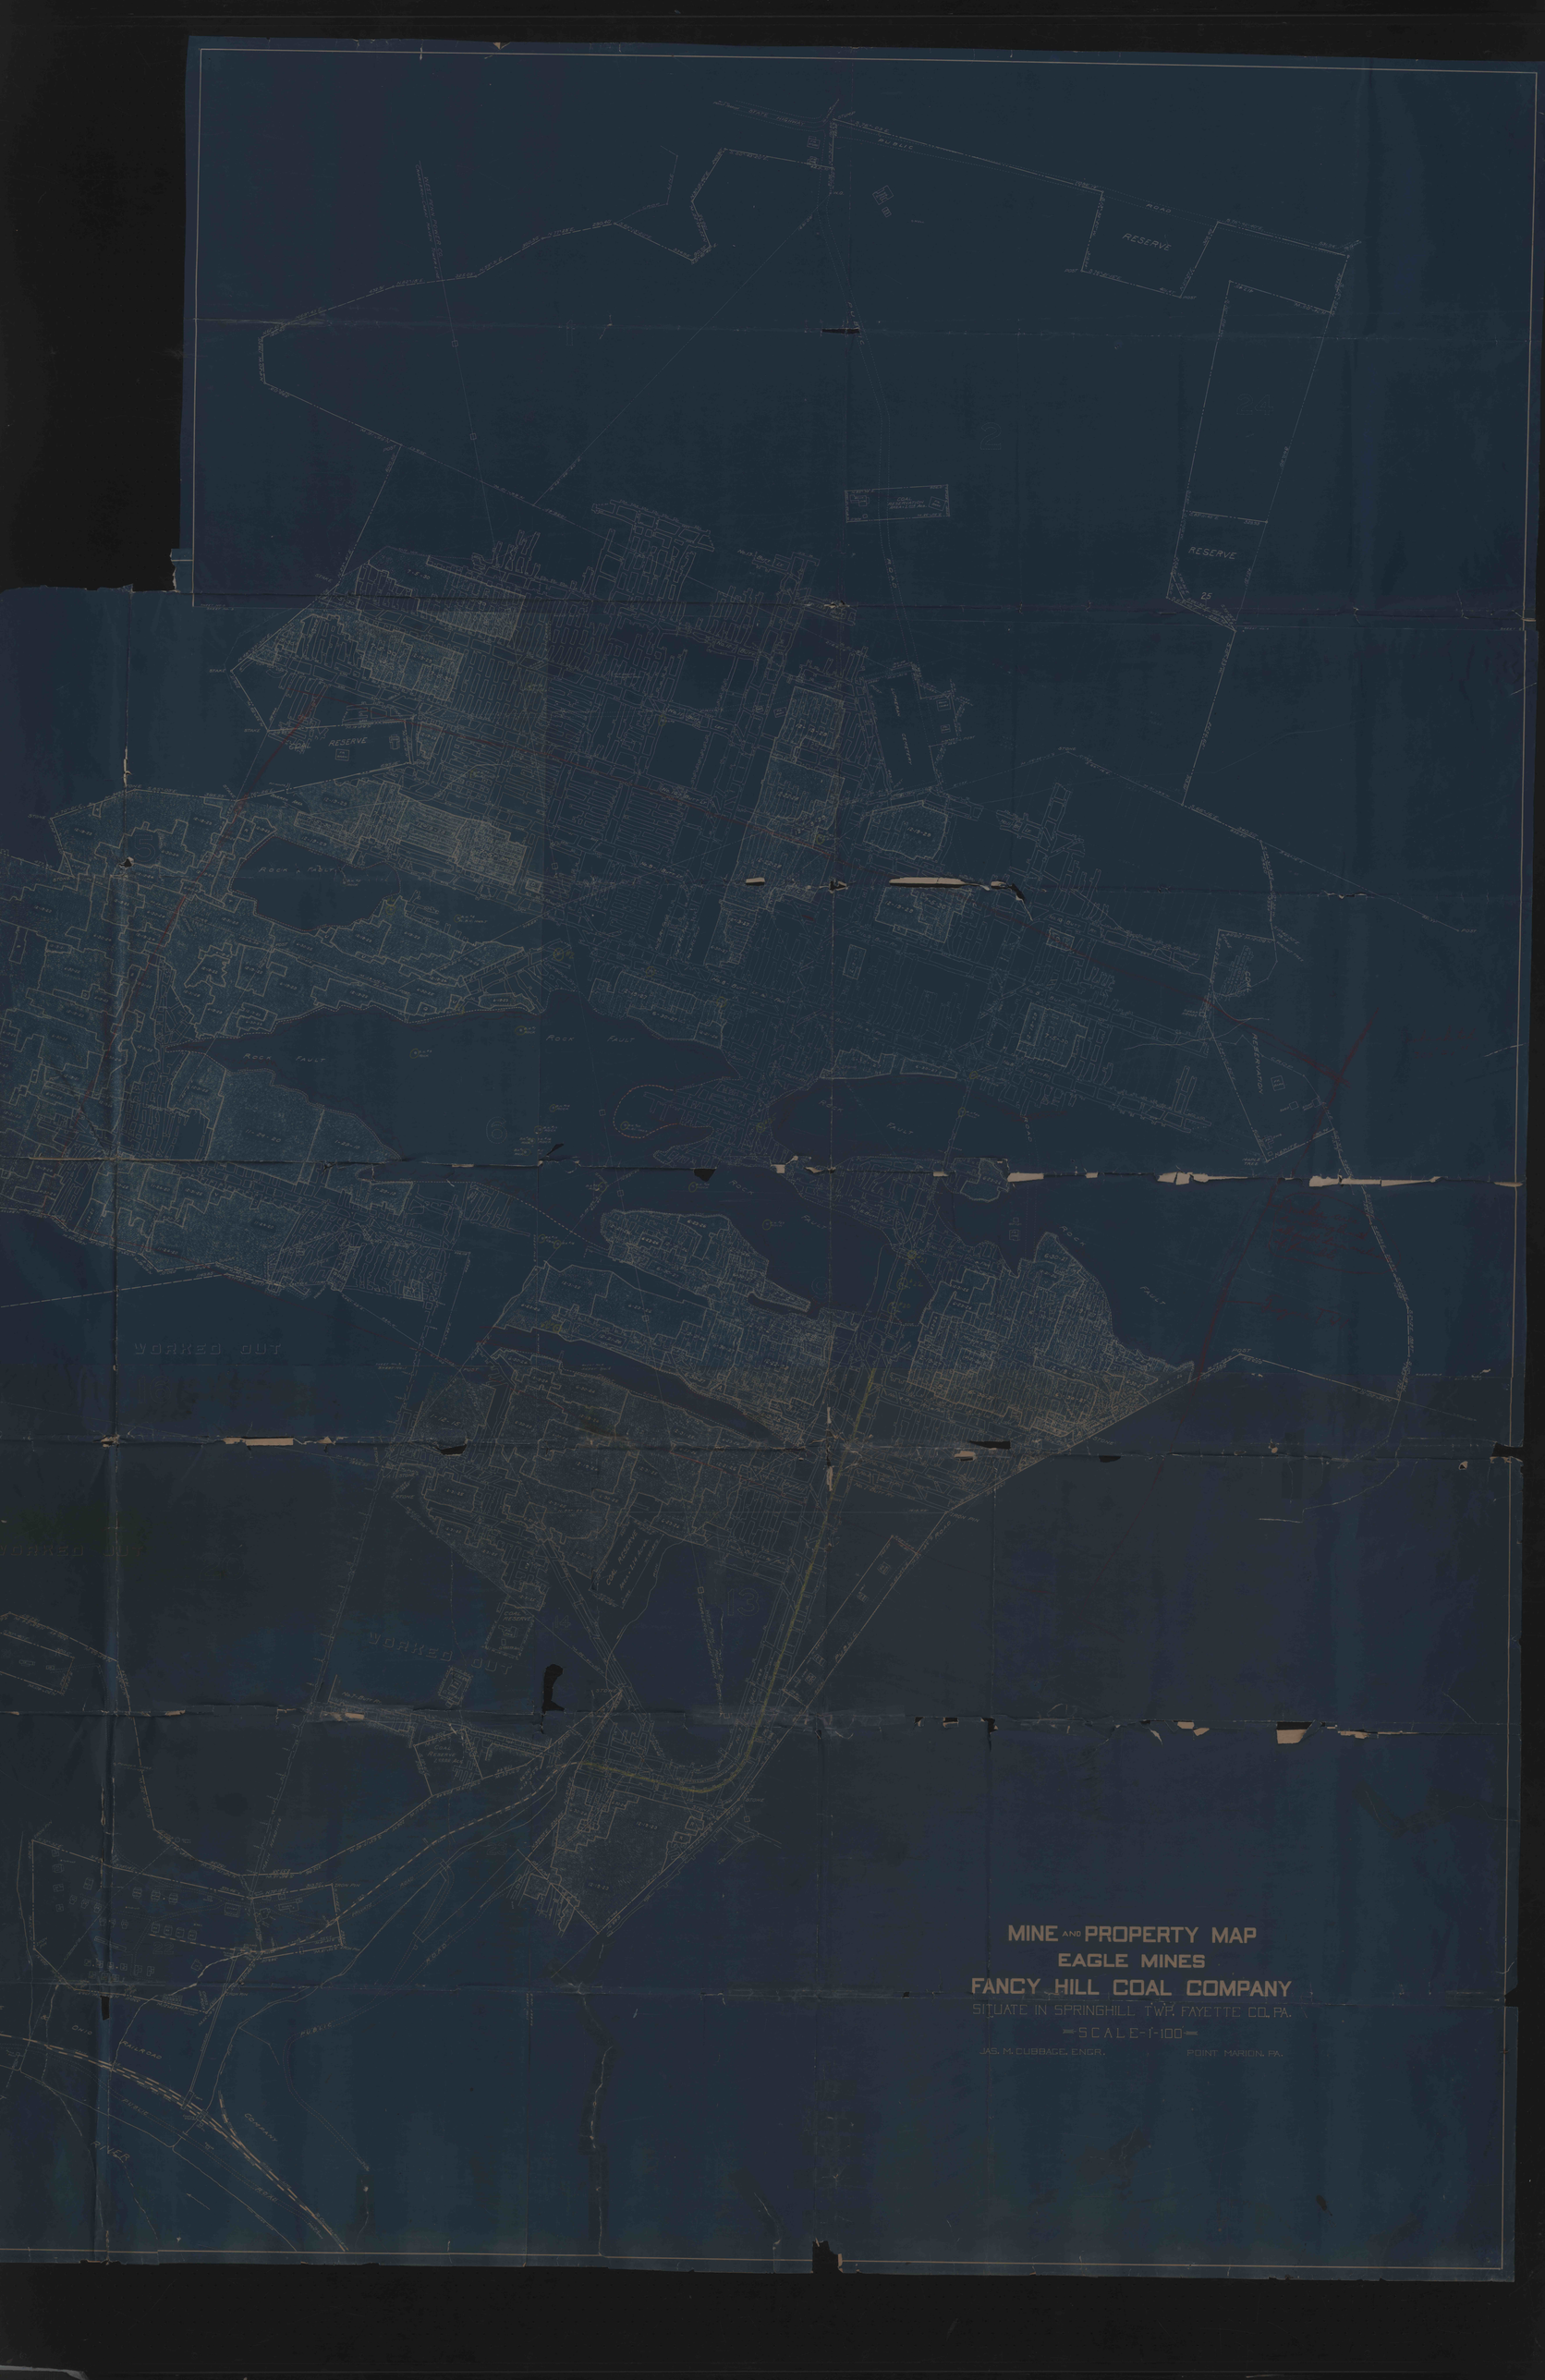
RESERVE
RESERVE
RESERVE
COAL
Rock Fault
Rock Fault
WORKED OUT
WORKED OUT
WORKED OUT
MINE AND PROPERTY MAP
EAGLE MINES
FANCY HILL COAL COMPANY
SITUATE IN SPRINGHILL TWP. FAYETTE CO. PA.
—SCALE-1-100—
JAS. M. CUBBAGE, ENGR.
POINT MARION, PA.