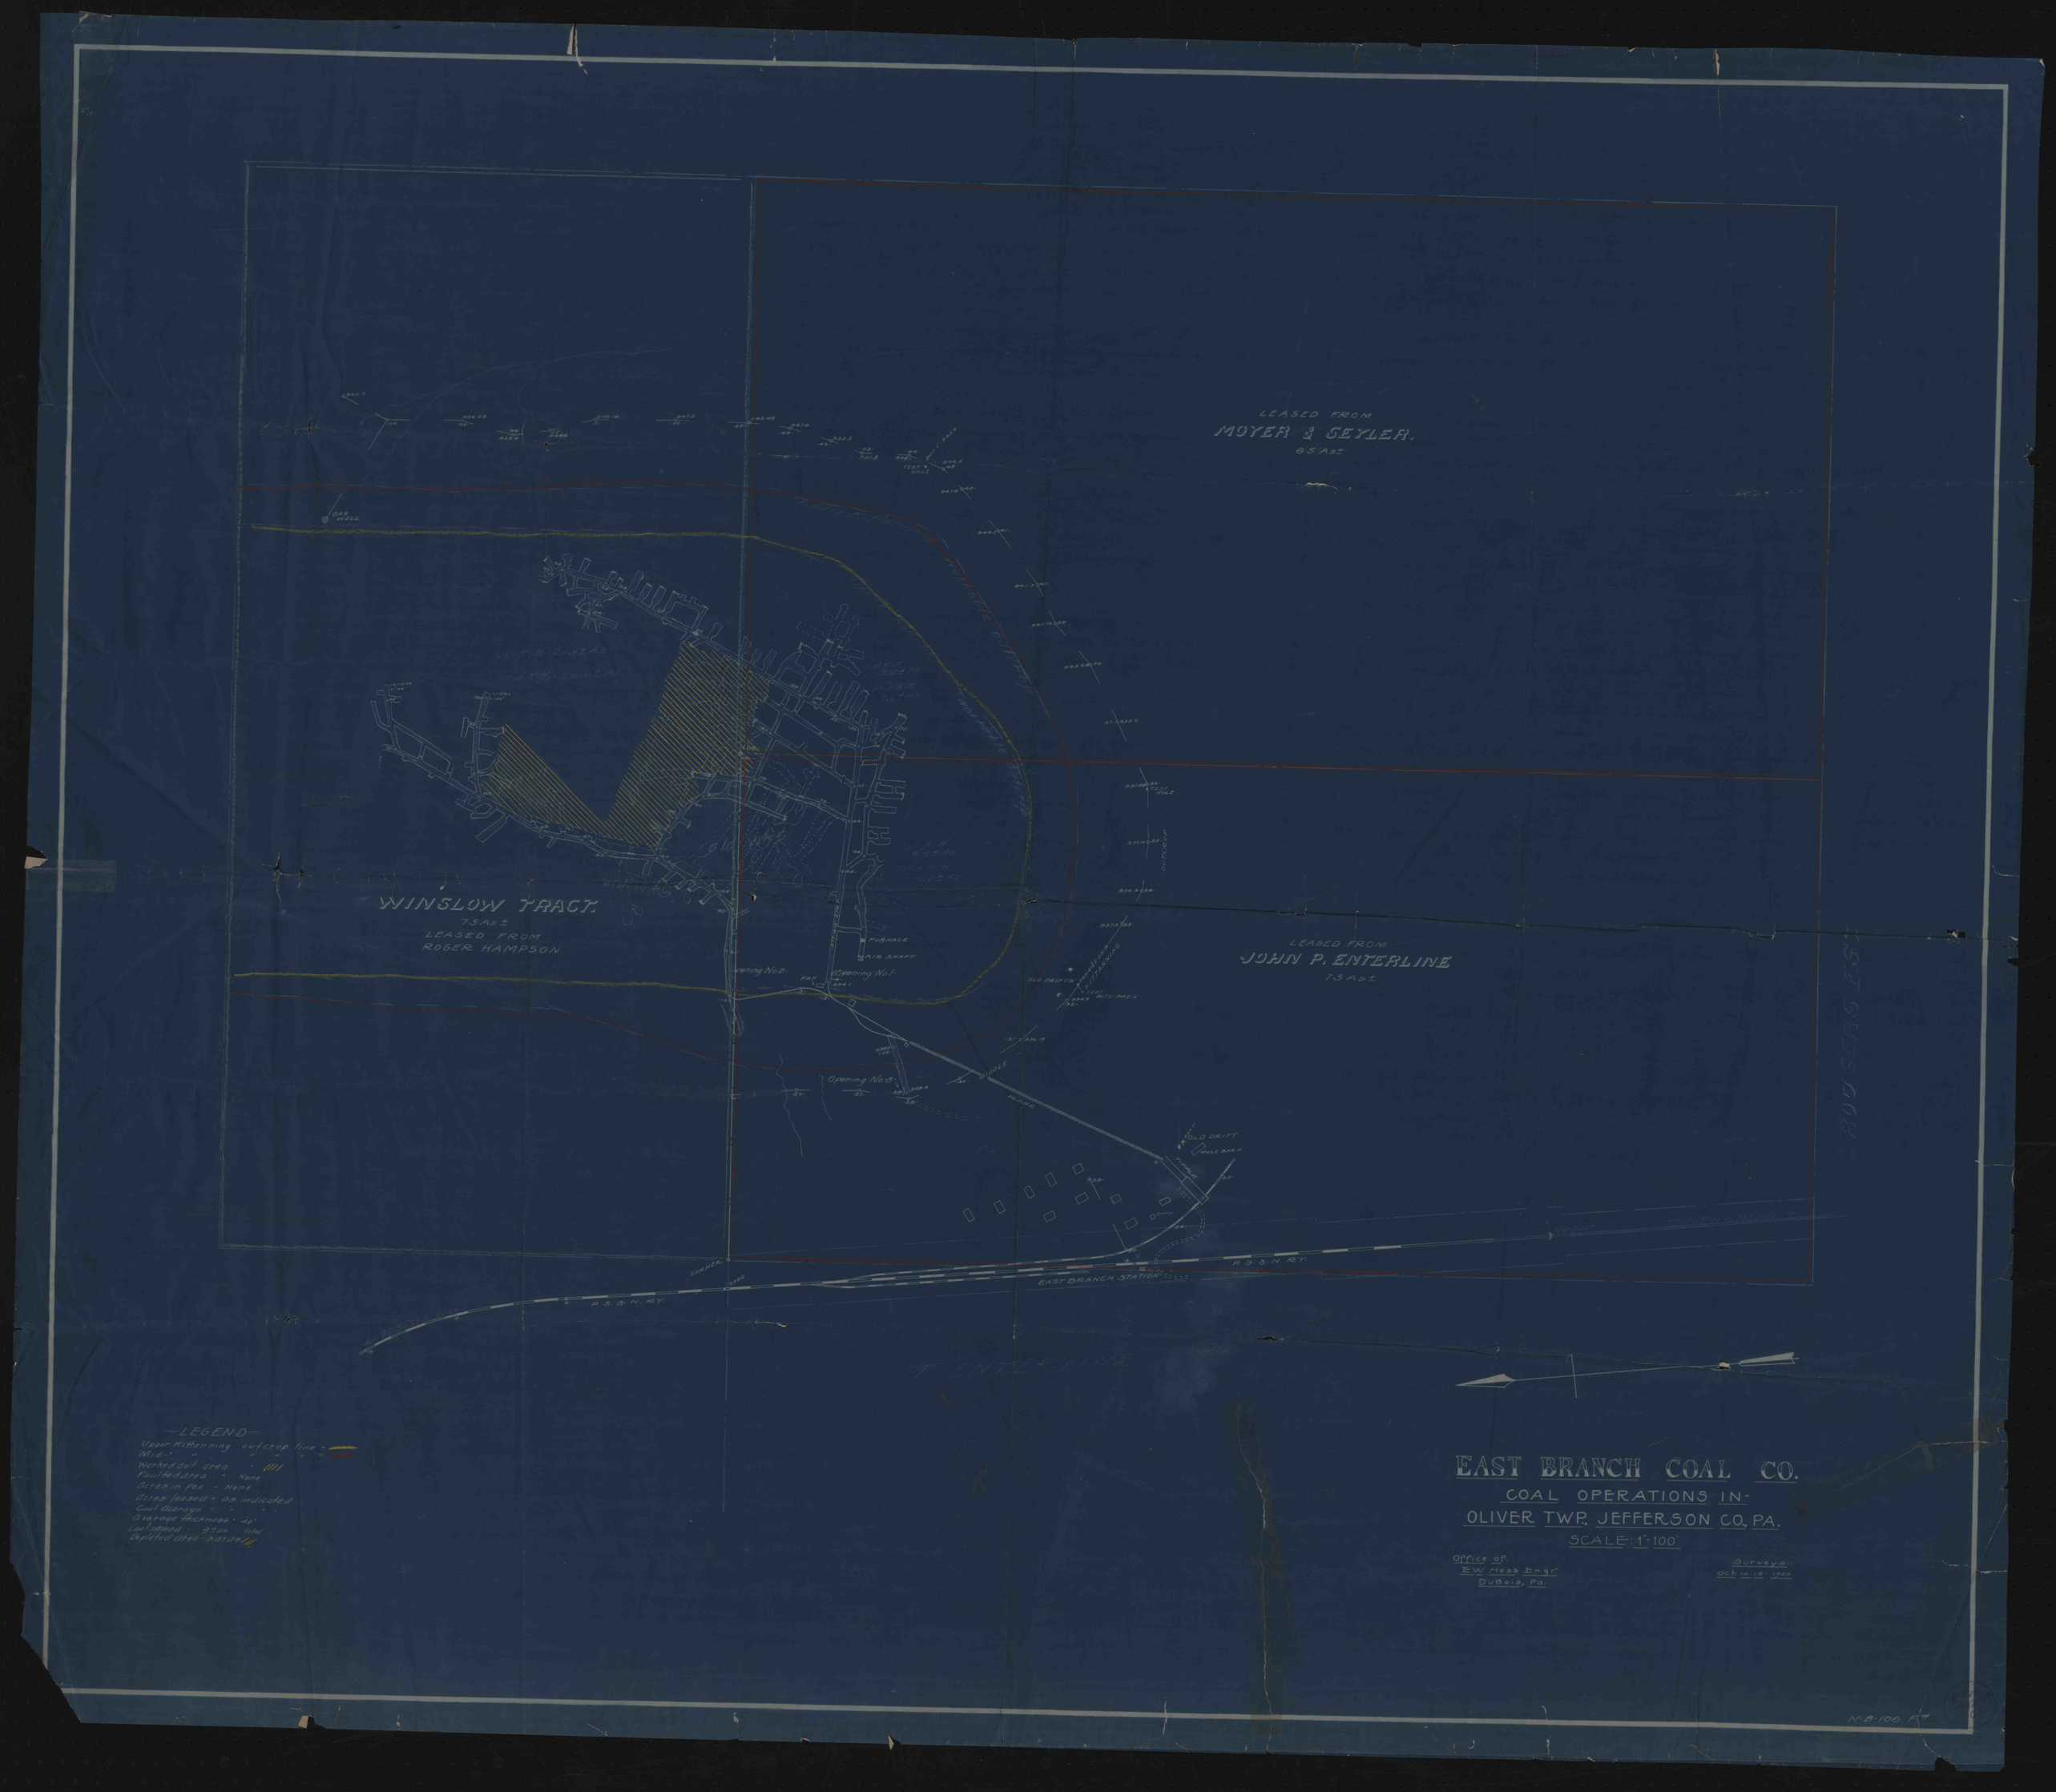
LEASED FROM
MOYER & SEYLER.
85 As±
WINSLOW TRACT.
75 As±
LEASED FROM
ROGER HAMPSON
LEASED FROM
JOHN P. ENTERLINE
75 As±
ROUGERS FS.
P.S.&N. RY.
EAST BRANCH STATION
P.S.&N. RY.
T. ENTERLINE
—LEGEND—
Upper Kittanning outcrop line -
Mid.- " " " " " -
Worked out area - ////
Faulted area - None
Acres in pee - None
Acres leased - as indicated
Coal Acerage - " "
Average thickness - 42"
Coal Mined - 9±as Total
Depleted Area - 33±as ///
EAST BRANCH COAL CO.
COAL OPERATIONS IN-
OLIVER TWP., JEFFERSON CO., PA.
SCALE: 1"=100'
Office of
E.W. Hess Engr.
DuBois, Pa.
Surveys:
Oct. 10-15-1920
N-B-108 F