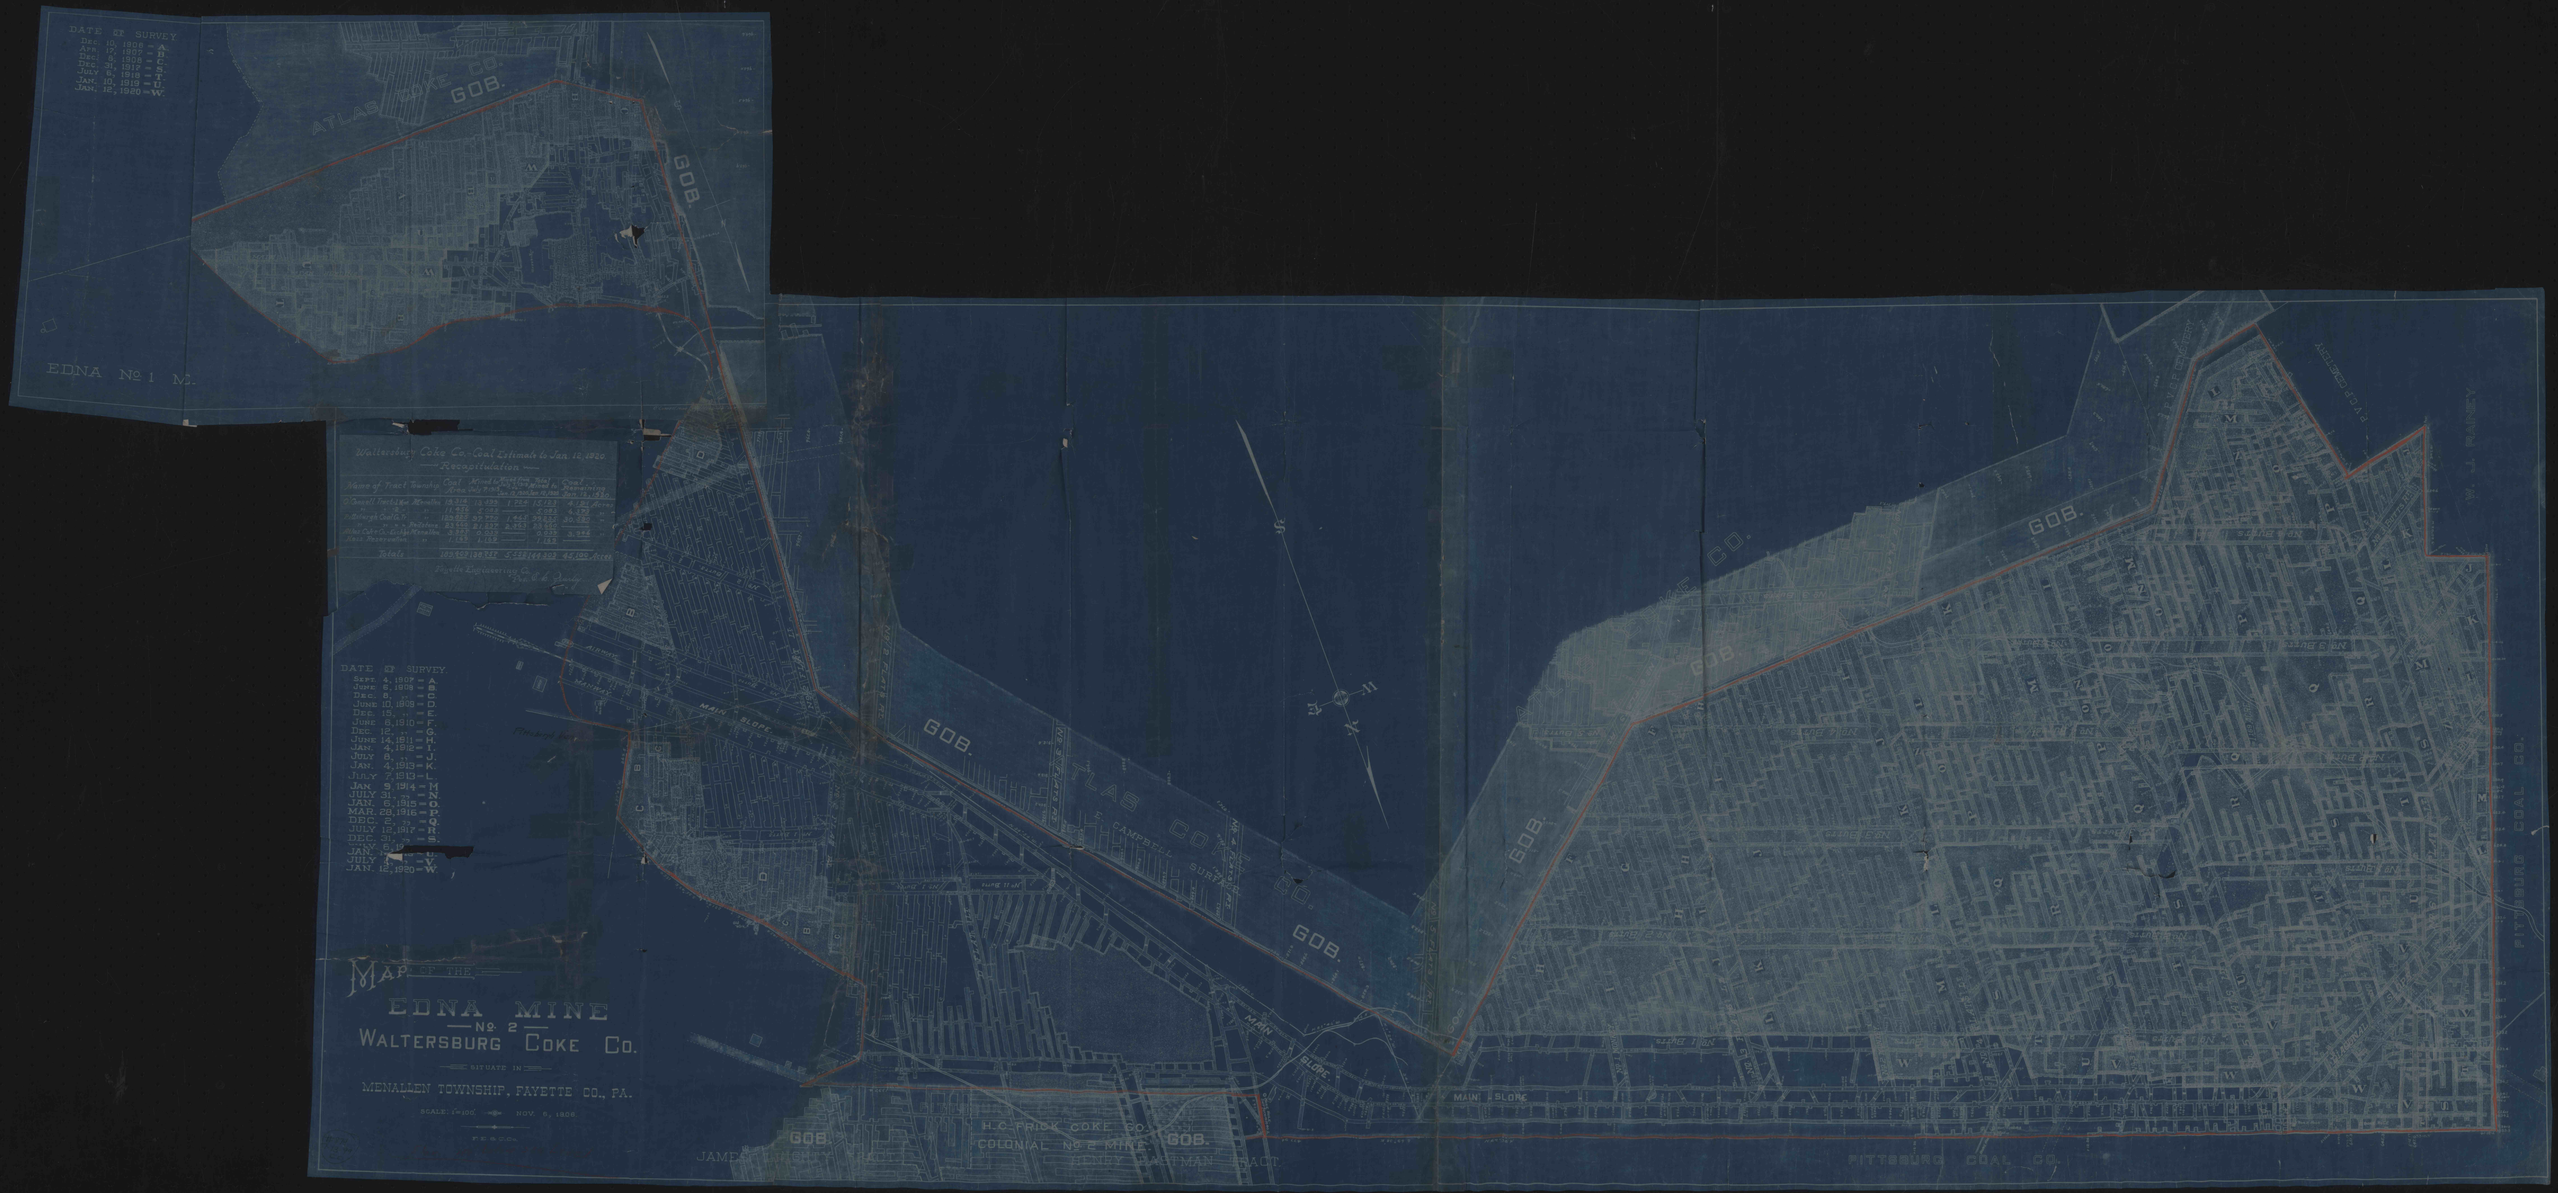
DATE OF SURVEY
DEC. 10, 1906 = A.
APR. 12, 1907 = B.
DEC. 3, 1908 = C.
JULY 6, 1912 = S.
JAN. 10, 1919 = U.
JAN. 12, 1920 = W.
ATLAS COKE CO.
GOB.
EDNA No 1 M.
Waltersburg Coke Co. Coal Estimate to Jan. 12, 1920.
Recapitulation
Name of Tract Township Coal Mined & Pillared Prior to Jan. 1, 1906 Mined & Pillared Jan. 1, 1906 to Jan. 12, 1920 Coal Remaining Jan. 12, 1920
Totals
Fayette Engineering Co.
DATE OF SURVEY.
SEPT. 4, 1907 = A.
JUNE 6, 1909 = B.
DEC. 8, " " = C.
JUNE 10, 1909 = D.
DEC. 13, " " = E.
JUNE 8, 1910 = F.
DEC. 12, " " = G.
JUNE 14, 1911 = H.
JAN. 4, 1912 = I.
JULY 8, " = J.
JAN. 4, 1913 = K.
JULY 7, 1913 = L.
JAN. 9, 1914 = M.
JULY 31, " = N.
JAN. 6, 1915 = O.
MAR. 28, 1916 = P.
DEC. 2, " = Q.
JULY 12, 1917 = R.
DEC. 31, " = S.
JAN. 6, 19[redacted] = U.
JULY [redacted] = V.
JAN. 12, 1920 = W.
MAIN SLOPE
MAP OF THE
EDNA MINE
No. 2
WALTERSBURG COKE CO.
SITUATE IN
MENALLEN TOWNSHIP, FAYETTE CO., PA.
SCALE: 1" = 100'.
NOV. 6, 1906.
H. C. FRICK COKE CO.
COLONIAL No 2 MINE
JAMES LINGHEY TRACT
HENRY HARTMAN TRACT
PITTSBURG COAL CO.