

EDENBORN MINE

H.C. FRICK COKE CO.

FAVETTE COUNTY, PA.

Dated Nov. 1, 1914
Chief Engineer

show the excavations in said Mine
and to the best of my knowledge and belief
copy of the original map of Edenborn Mine
These prints are certified to be an exact

NO.	DESCRIPTION	DATE
1
2
DATE OF LAST SURVEY

BY

...



M. J. FRANKS, INC.
OLD HOME MINE

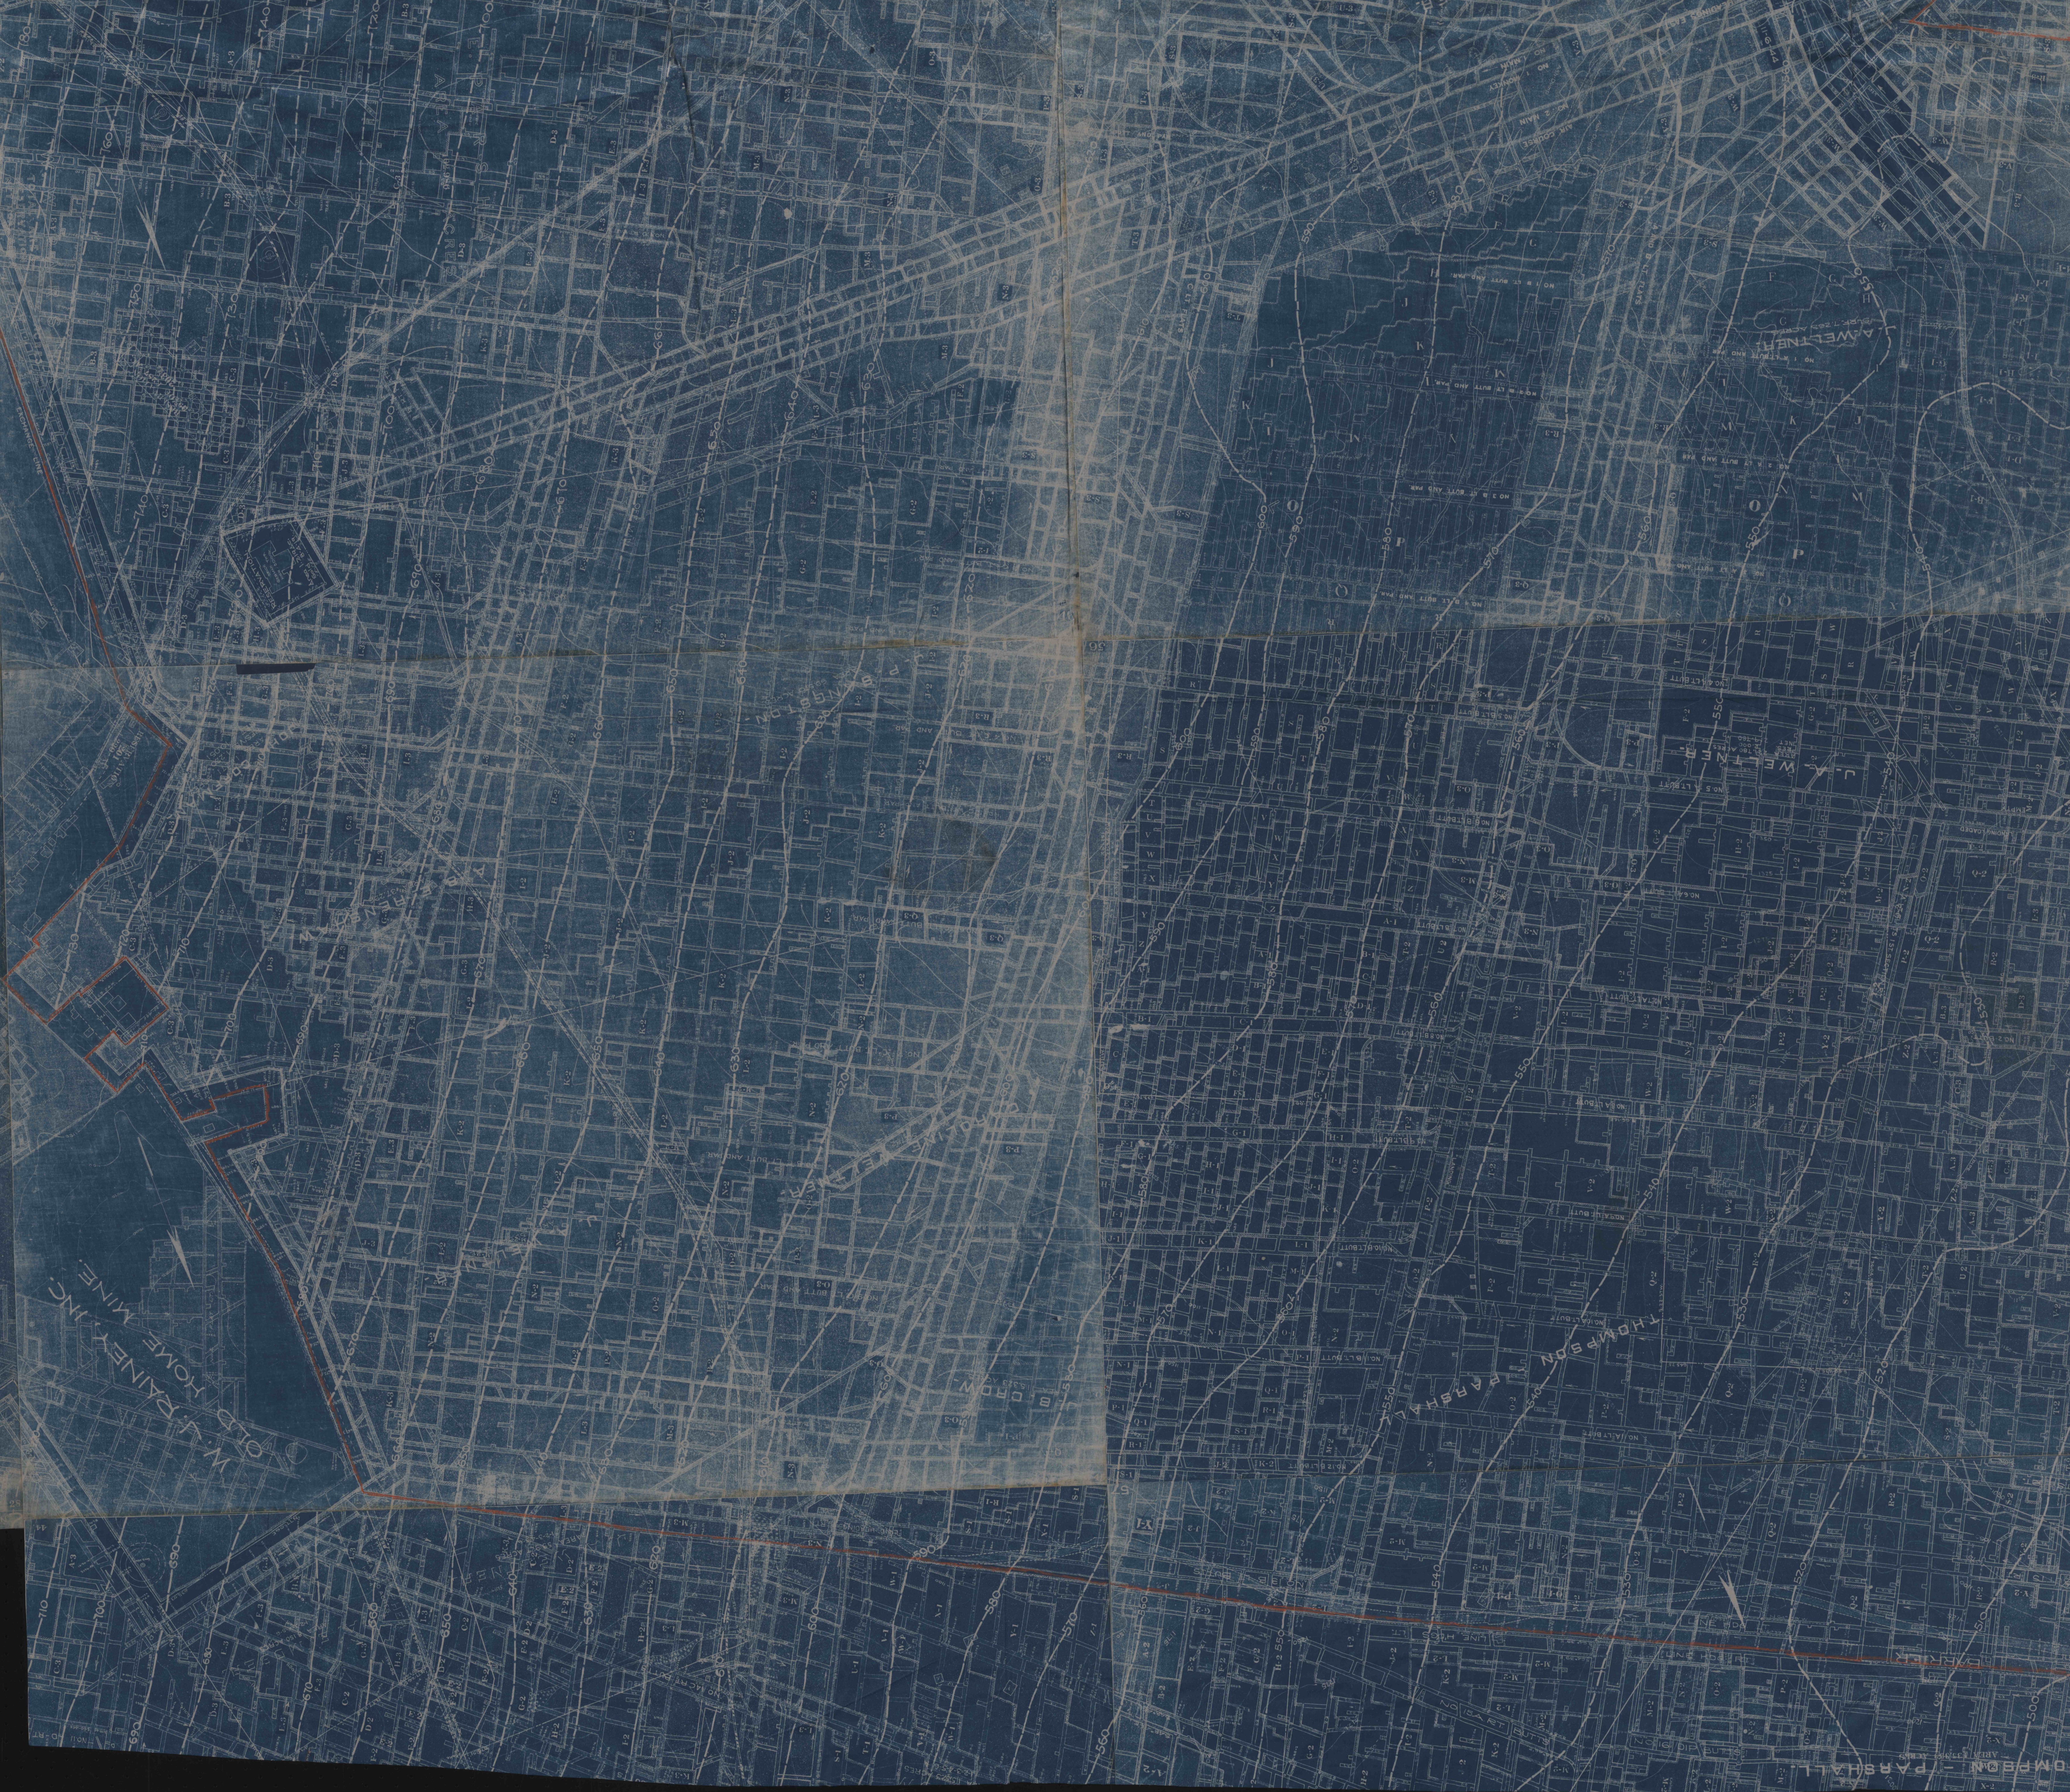

b2

HOMERON - PARSHALL