

ELLIOT COAL MINING CO. INC.

Operation: ELCOAL #1

Local Area: NEW LIBERTY

Township: DECATUR

County: CLEARFIELD




DATE: _____

PROPOSED AREA TO BE MINED:

AREA OF COMPLETED MINING:

AREAS UNDER STRUCTURES:

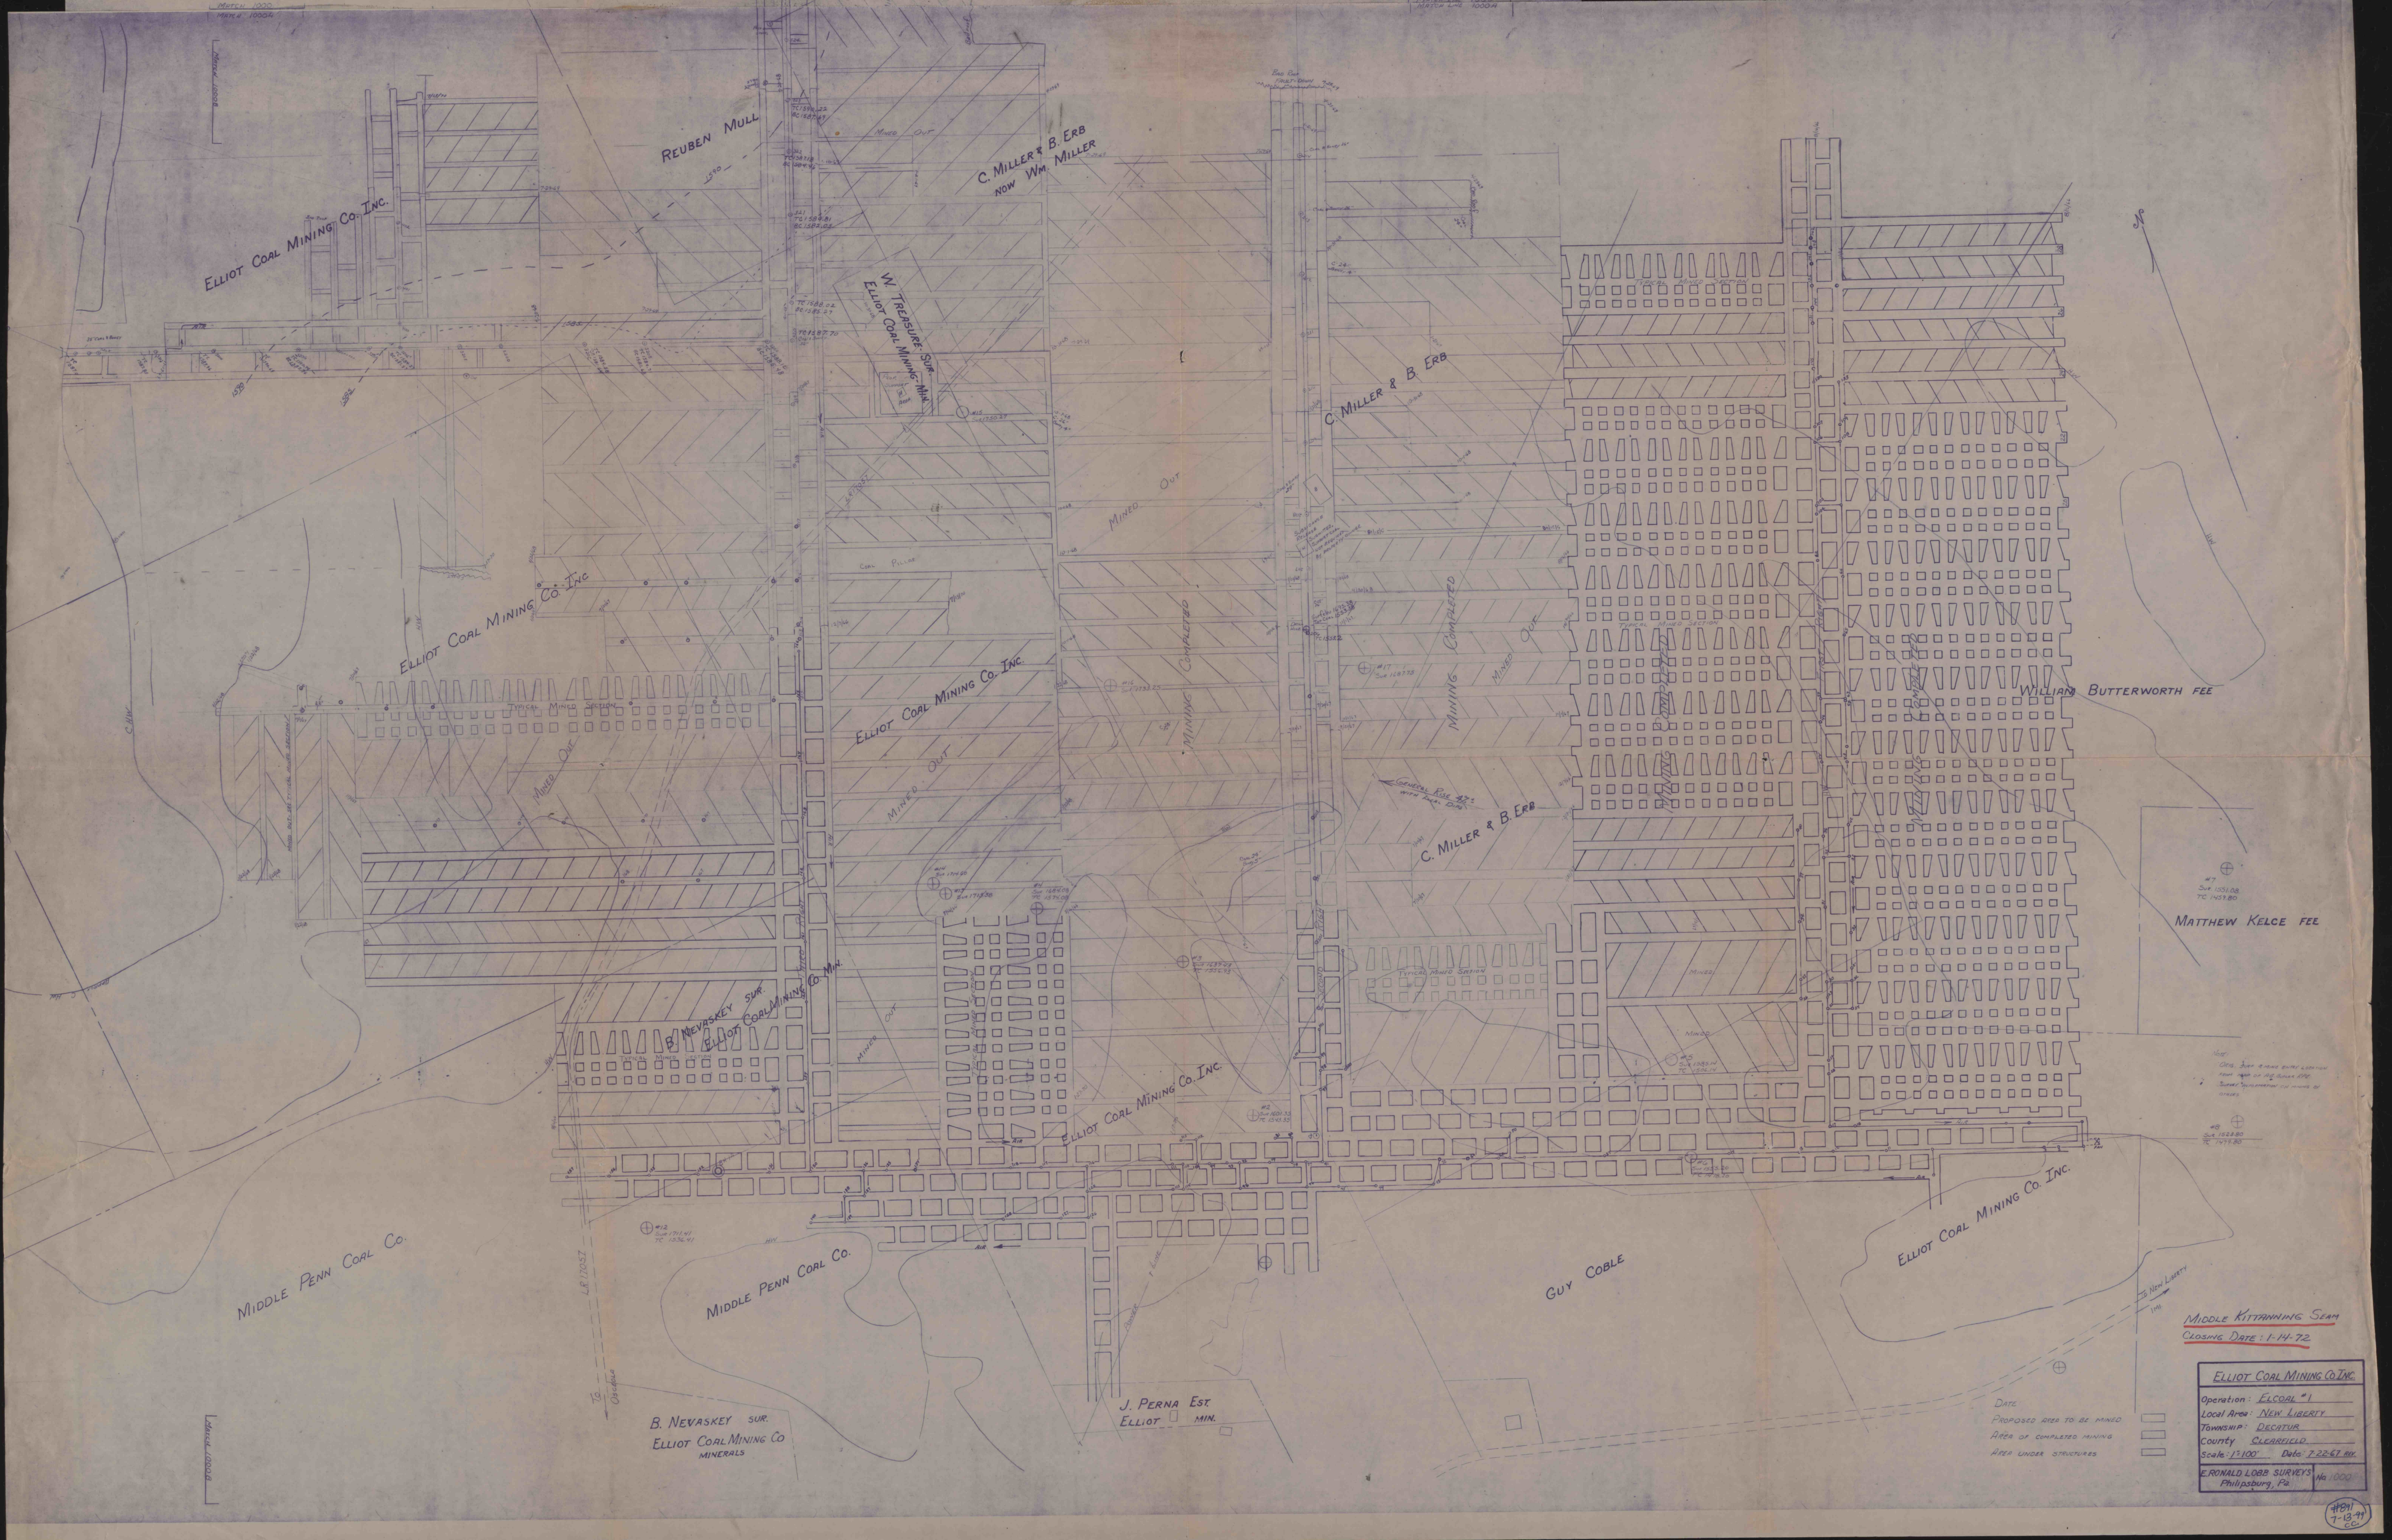

ELLIOT COAL MINING CO. INC.

Operation: ELCOAL #1

Local Area: NEW LIBERTY

Township: DECATUR

County: CLEARFIELD

Scale: 1/2" = 100' Date: 1-14-72

E. RONALD LOBB SURVEYOR No. 100034 Philadelphia, Pa.

DATE: _____

PROPOSED AREA TO BE MINED:

AREA OF COMPLETED MINING:

AREAS UNDER STRUCTURES:

APR 7-8-72