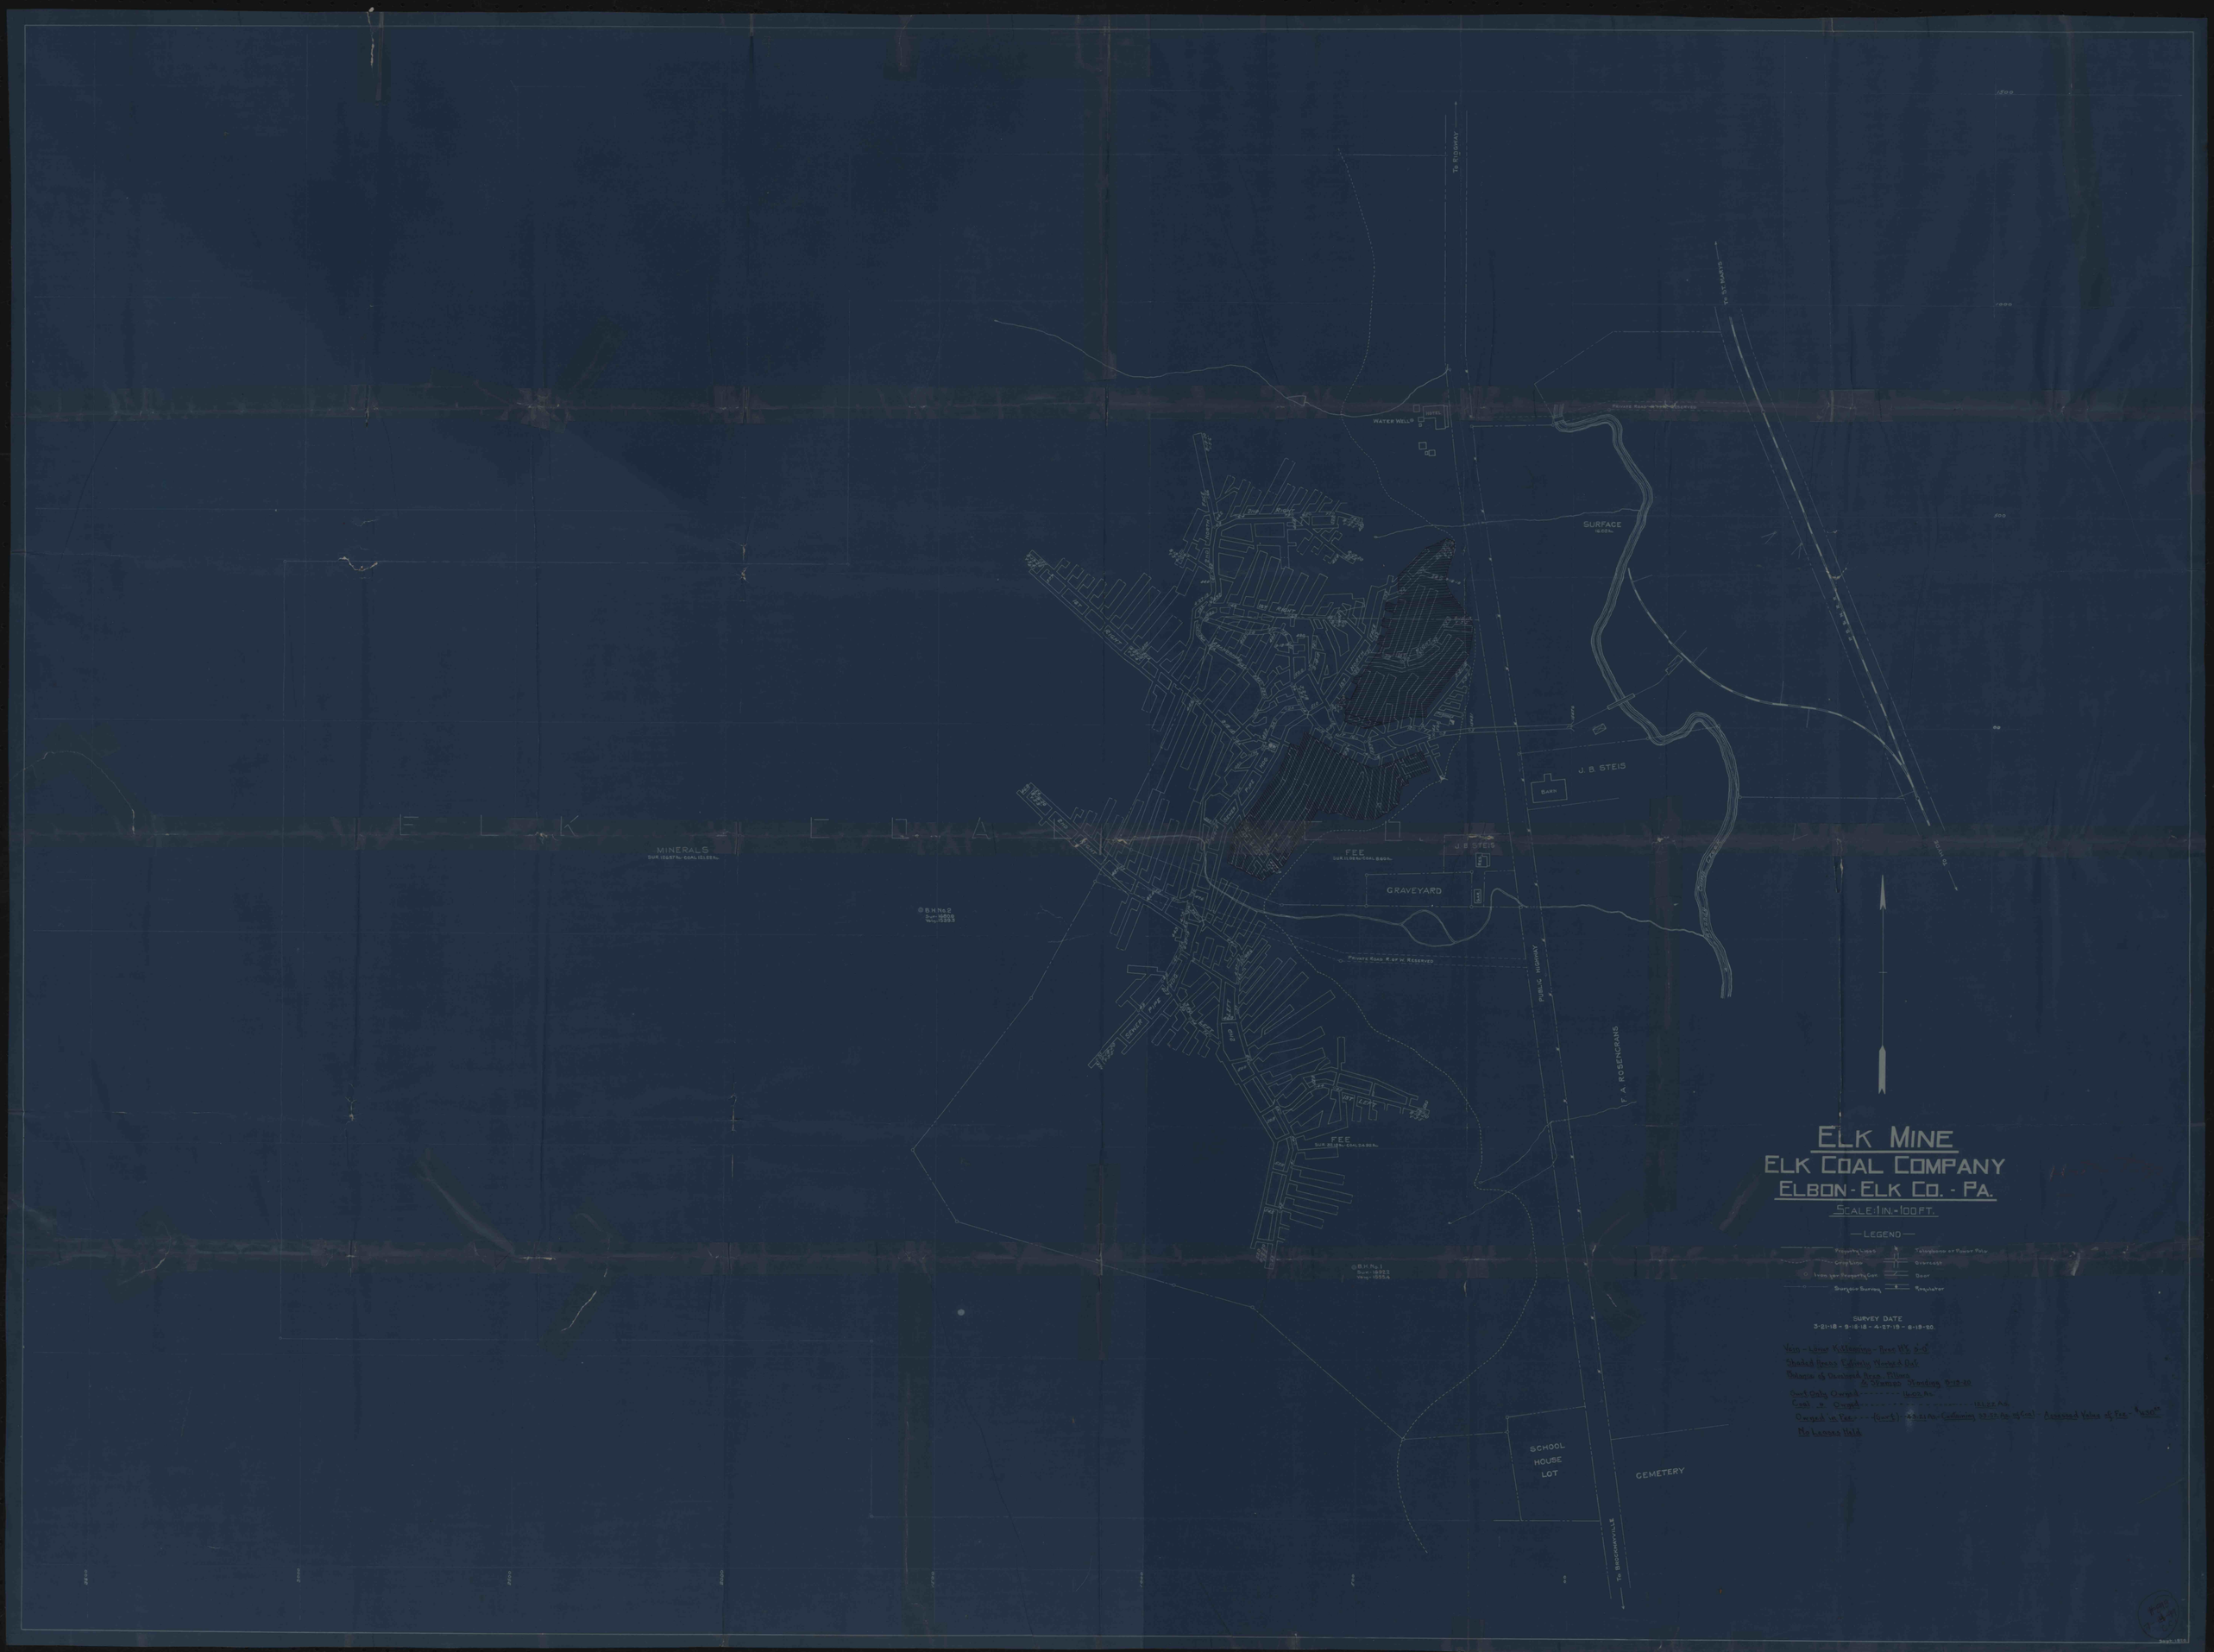
ELK MINE
ELK COAL COMPANY
ELBON - ELK CO. - PA.
SCALE: 1 IN. = 100 FT.
LEGEND
SURFACE
J. B. STEIS
BARN
GRAVEYARD
F. A. ROSENGRANS
PUBLIC HIGHWAY
SCHOOL HOUSE LOT
CEMETERY
To RIDGWAY
To ST. MARYS
To BROCKWAYVILLE
WATER WELL
HOTEL
MINERALS
FEE
SURFACE
SURVEY DATE
3-21-18 - 9-18-18 - 4-27-19 - 6-19-20.
No Leases Held