


DATE OF SURVEY.
DEC. 8, 1919 = A.

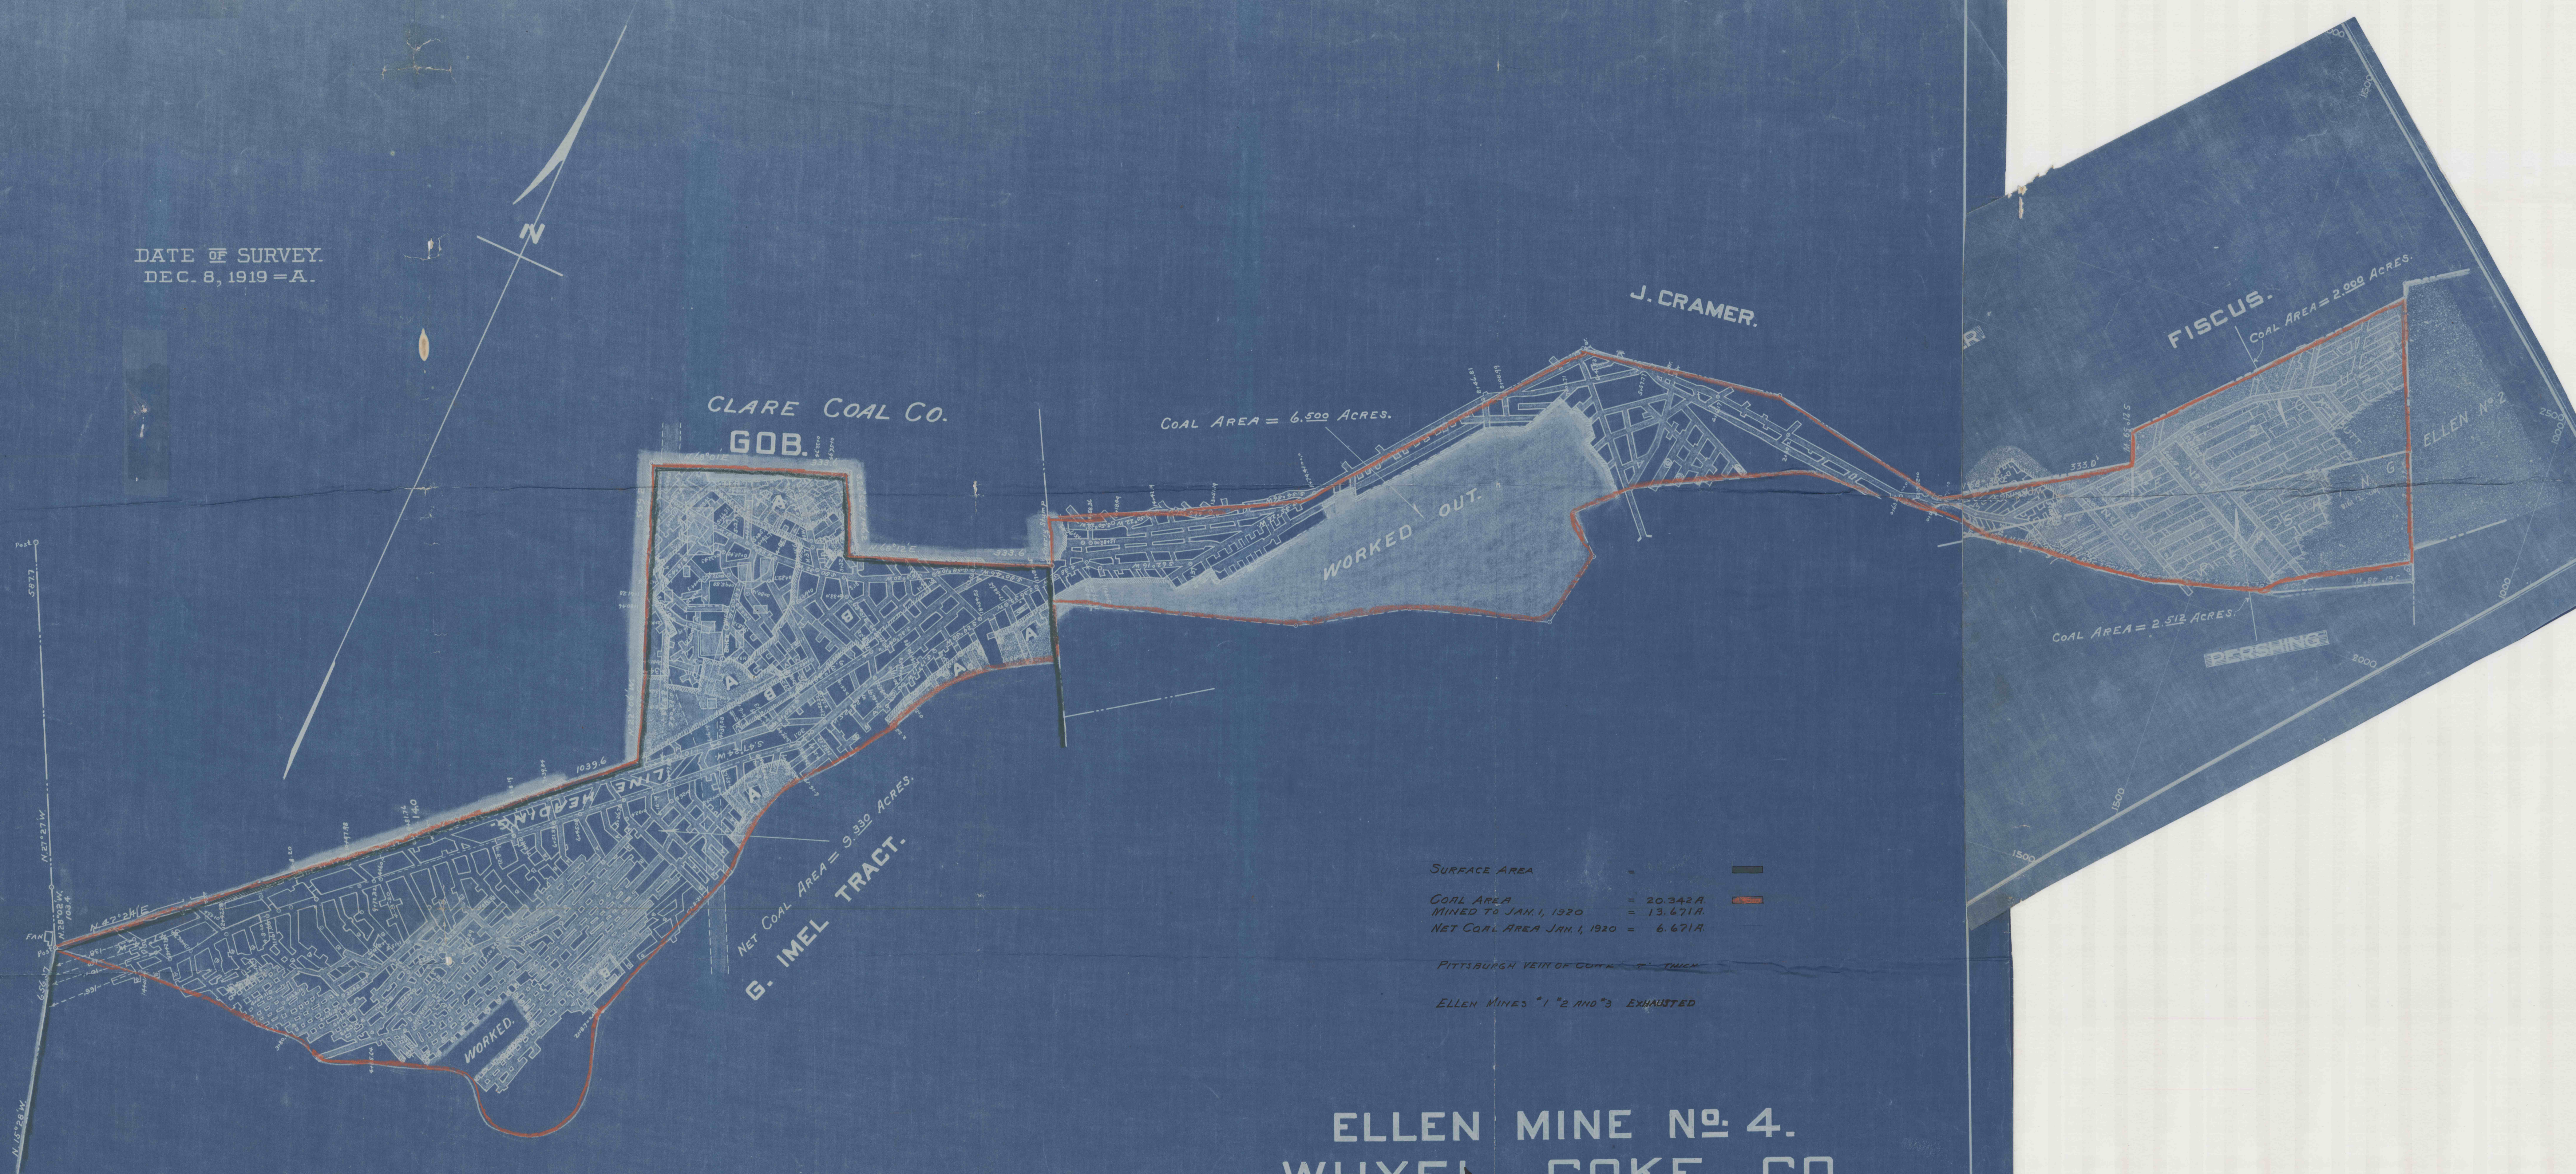

SURFACE AREA	=	—
COAL AREA	=	20,342 A.
MINED TO JAN. 1, 1920	=	13,671 A.
NET COAL AREA JAN. 1, 1920	=	6,671 A.

PITTSBURGH VEIN OF COAL - 5' THICK
ELLEN MINES "1" "2" AND "3" EXHAUSTED

ELLEN MINE No. 4. WHYEL COKE CO.

SITUATE IN
UNITY TOWNSHIP, WESTMORELAND CO., PA.

SCALE: 1" = 100 FT. MARCH 3, 1919.

