

TRIANGLE ENTERPRISES
BREN-MAR MINE
I.D. # 3602370



REVISION BY	DATE
Tom Ralby	4/22/84
Tom Ralby	1/14/84
Tom Ralby	12/16/83
Tom Ralby	2/16/85
Tom Ralby	3/18/85
Tom Ralby	1/28/85
Tom Ralby	1/10/85
Tom Ralby	1/20/85
Tom Ralby	1/24/85
Tom Ralby	2/14/86
Tom Ralby	2/18/86
Tom Ralby	3/25/86

REVISION BY	DATE
Mining Completed May 7, 1986	
[Large X mark]	


- LEGEND**
- [Symbol] INTAKE
 - [Symbol] RETURN
 - [Symbol] BLEEDER
 - [Symbol] OVERCAST
 - [Symbol] REGULATOR
 - [Symbol] PERMANENT STOPPING
 - [Symbol] BOXCHECK
 - [Symbol] MANDOOR
 - [Symbol] LOADING POINT
 - [Symbol] BELT
 - [Symbol] SURVEY STATION
 - [Symbol] PRIMARY ESCAPEWAY
 - [Symbol] SECONDARY ESCAPEWAY
 - [Symbol] COAL CONTOUR LINE
 - [Symbol] PILLARED AREA
 - [Symbol] 6 MONTHS PROJECTION
 - [Symbol] CHECK CURTAIN
 - [Symbol] MONITORING STATION
 - [Symbol] PERMANENT SEAL
 - [Symbol] INCOMBUSTIBLE MATERIAL

ELMER L. MCCLURE
43.98 Ac. Surface & Sewickley Coal

EMELIO MINING COMPANY, LTD.
NO. 1 MINE ID. NO. 36-07518
P.O. BOX 399 BOBTOWN, PA. 15315
DUNKARD TWP. GREENE CO.
SCALE: 1" = 100' DATE: 5/7/86

PREPARED BY
CHARBEL MINING SERVICES, INC.
P.O. BOX 399 BOBTOWN, PA


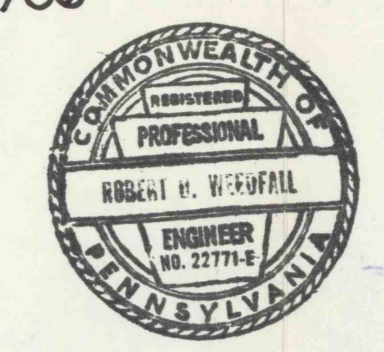

M.D. # 3083301

Final Map