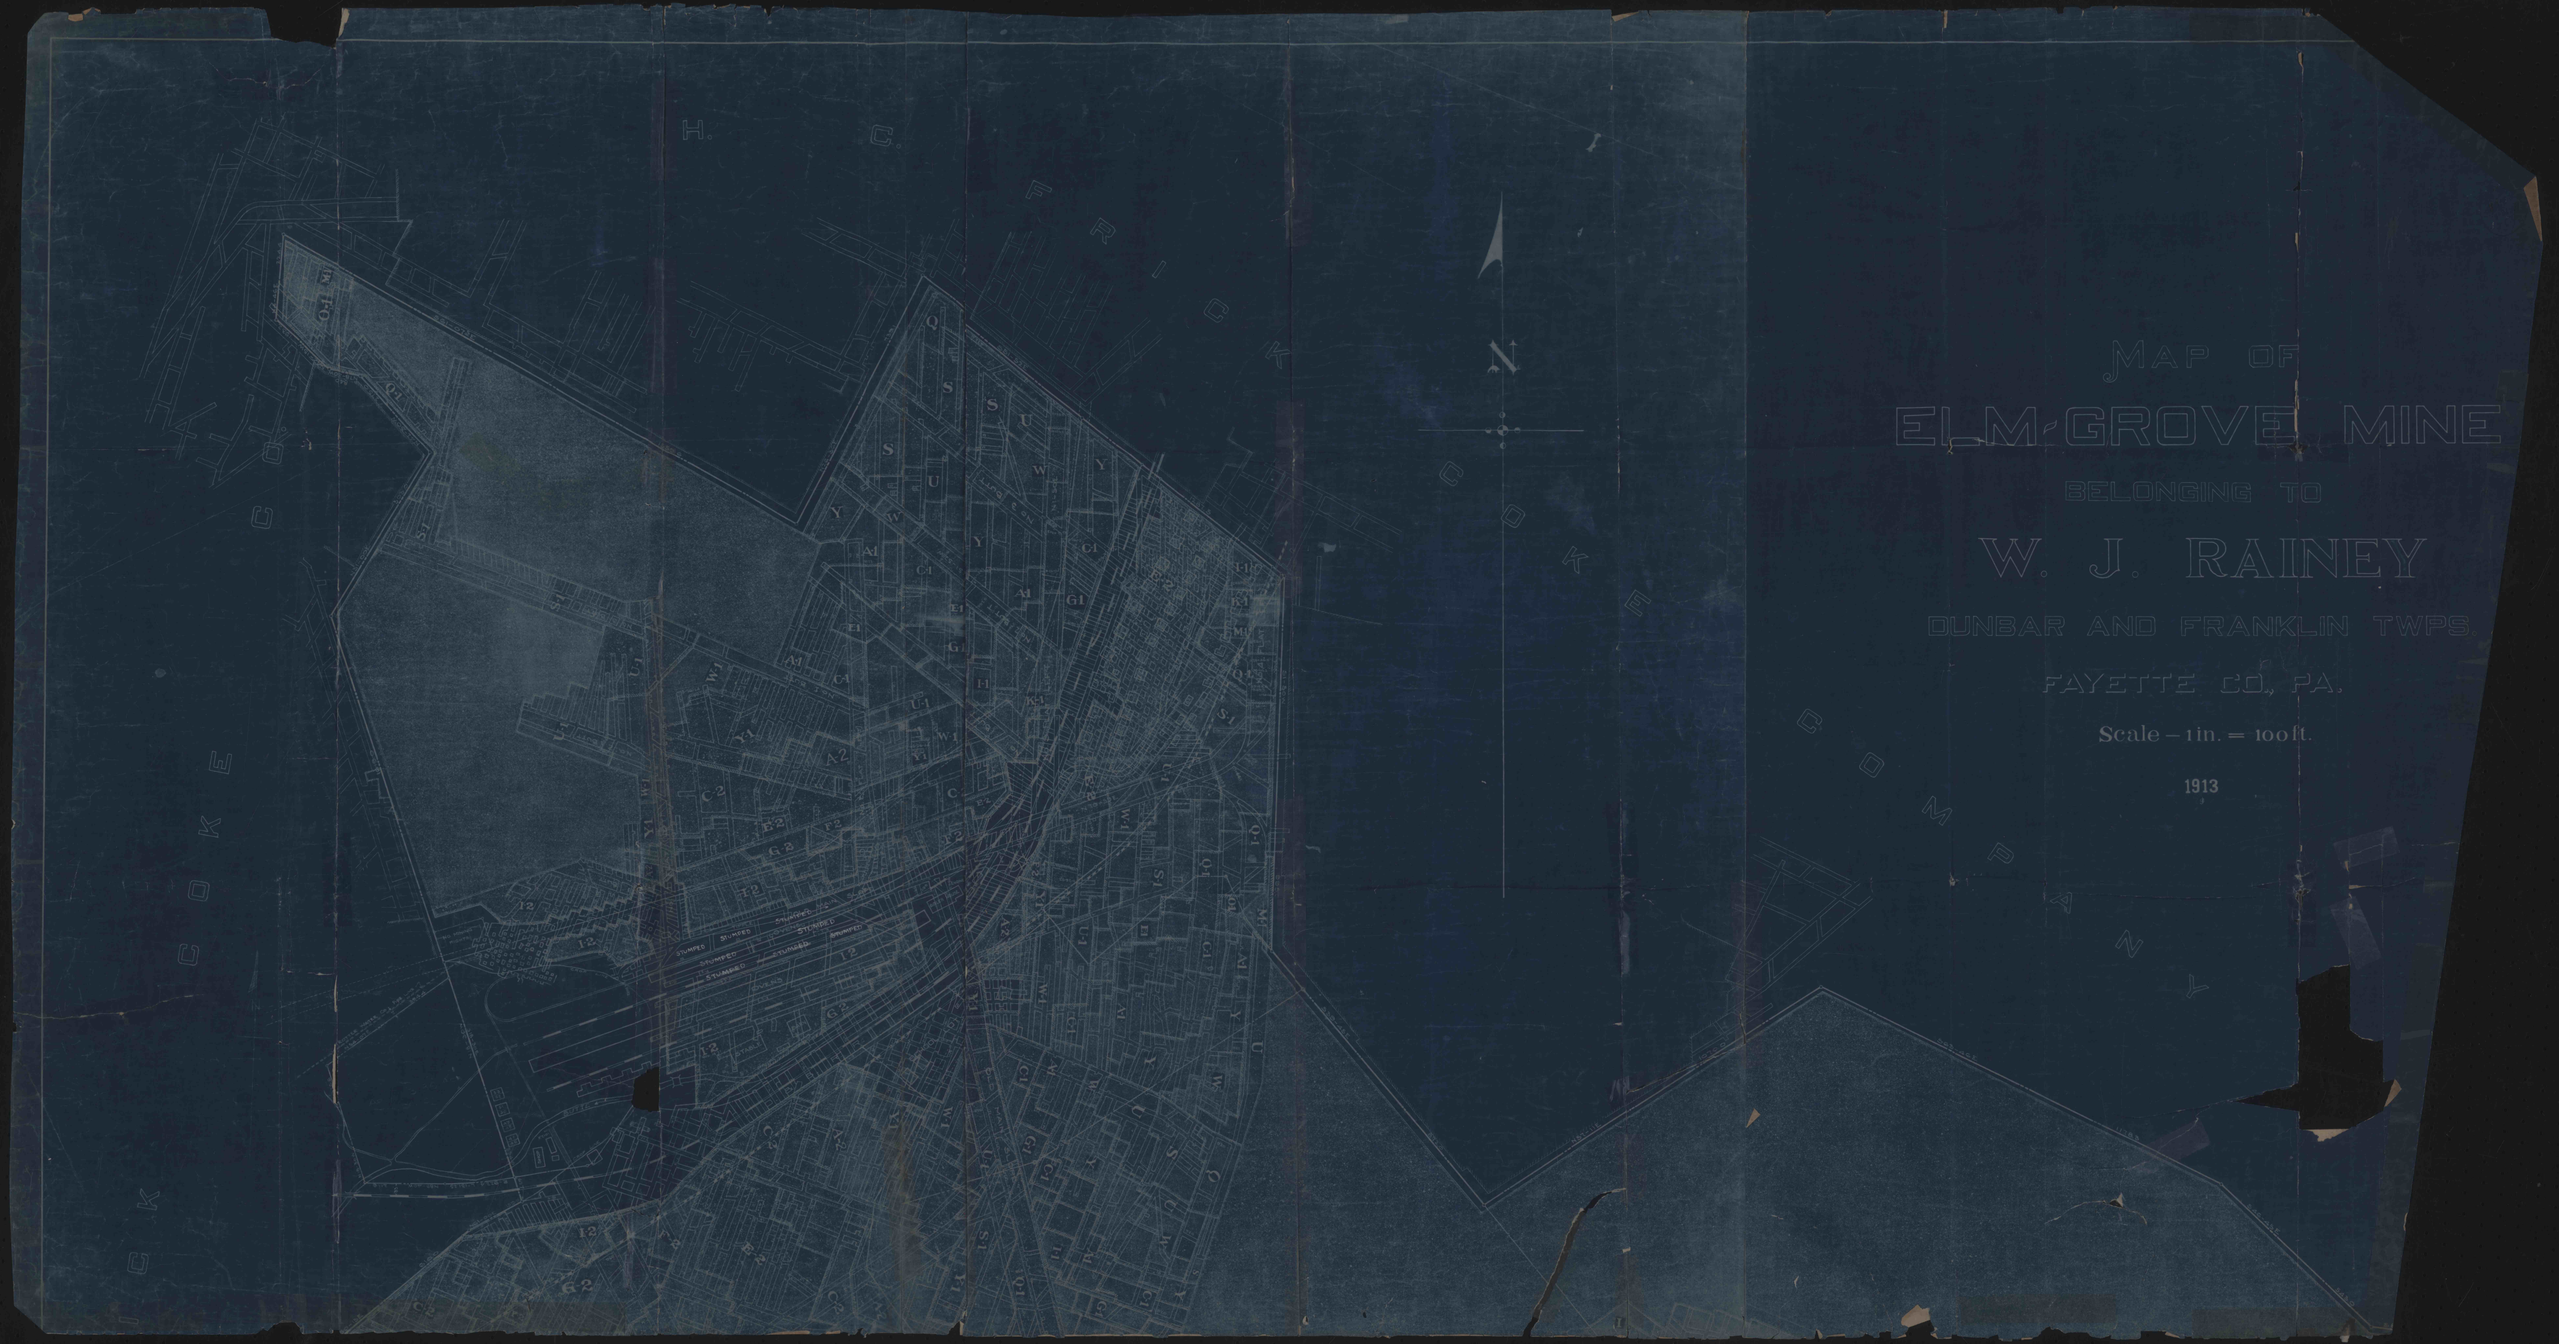
H. C. FRICK COKE COMPANY
N
MAP OF
ELM GROVE MINE
BELONGING TO
W. J. RAINEY
DUNBAR AND FRANKLIN TWPS.
FAYETTE CO., PA.
Scale – 1 in. = 100 ft.
1913