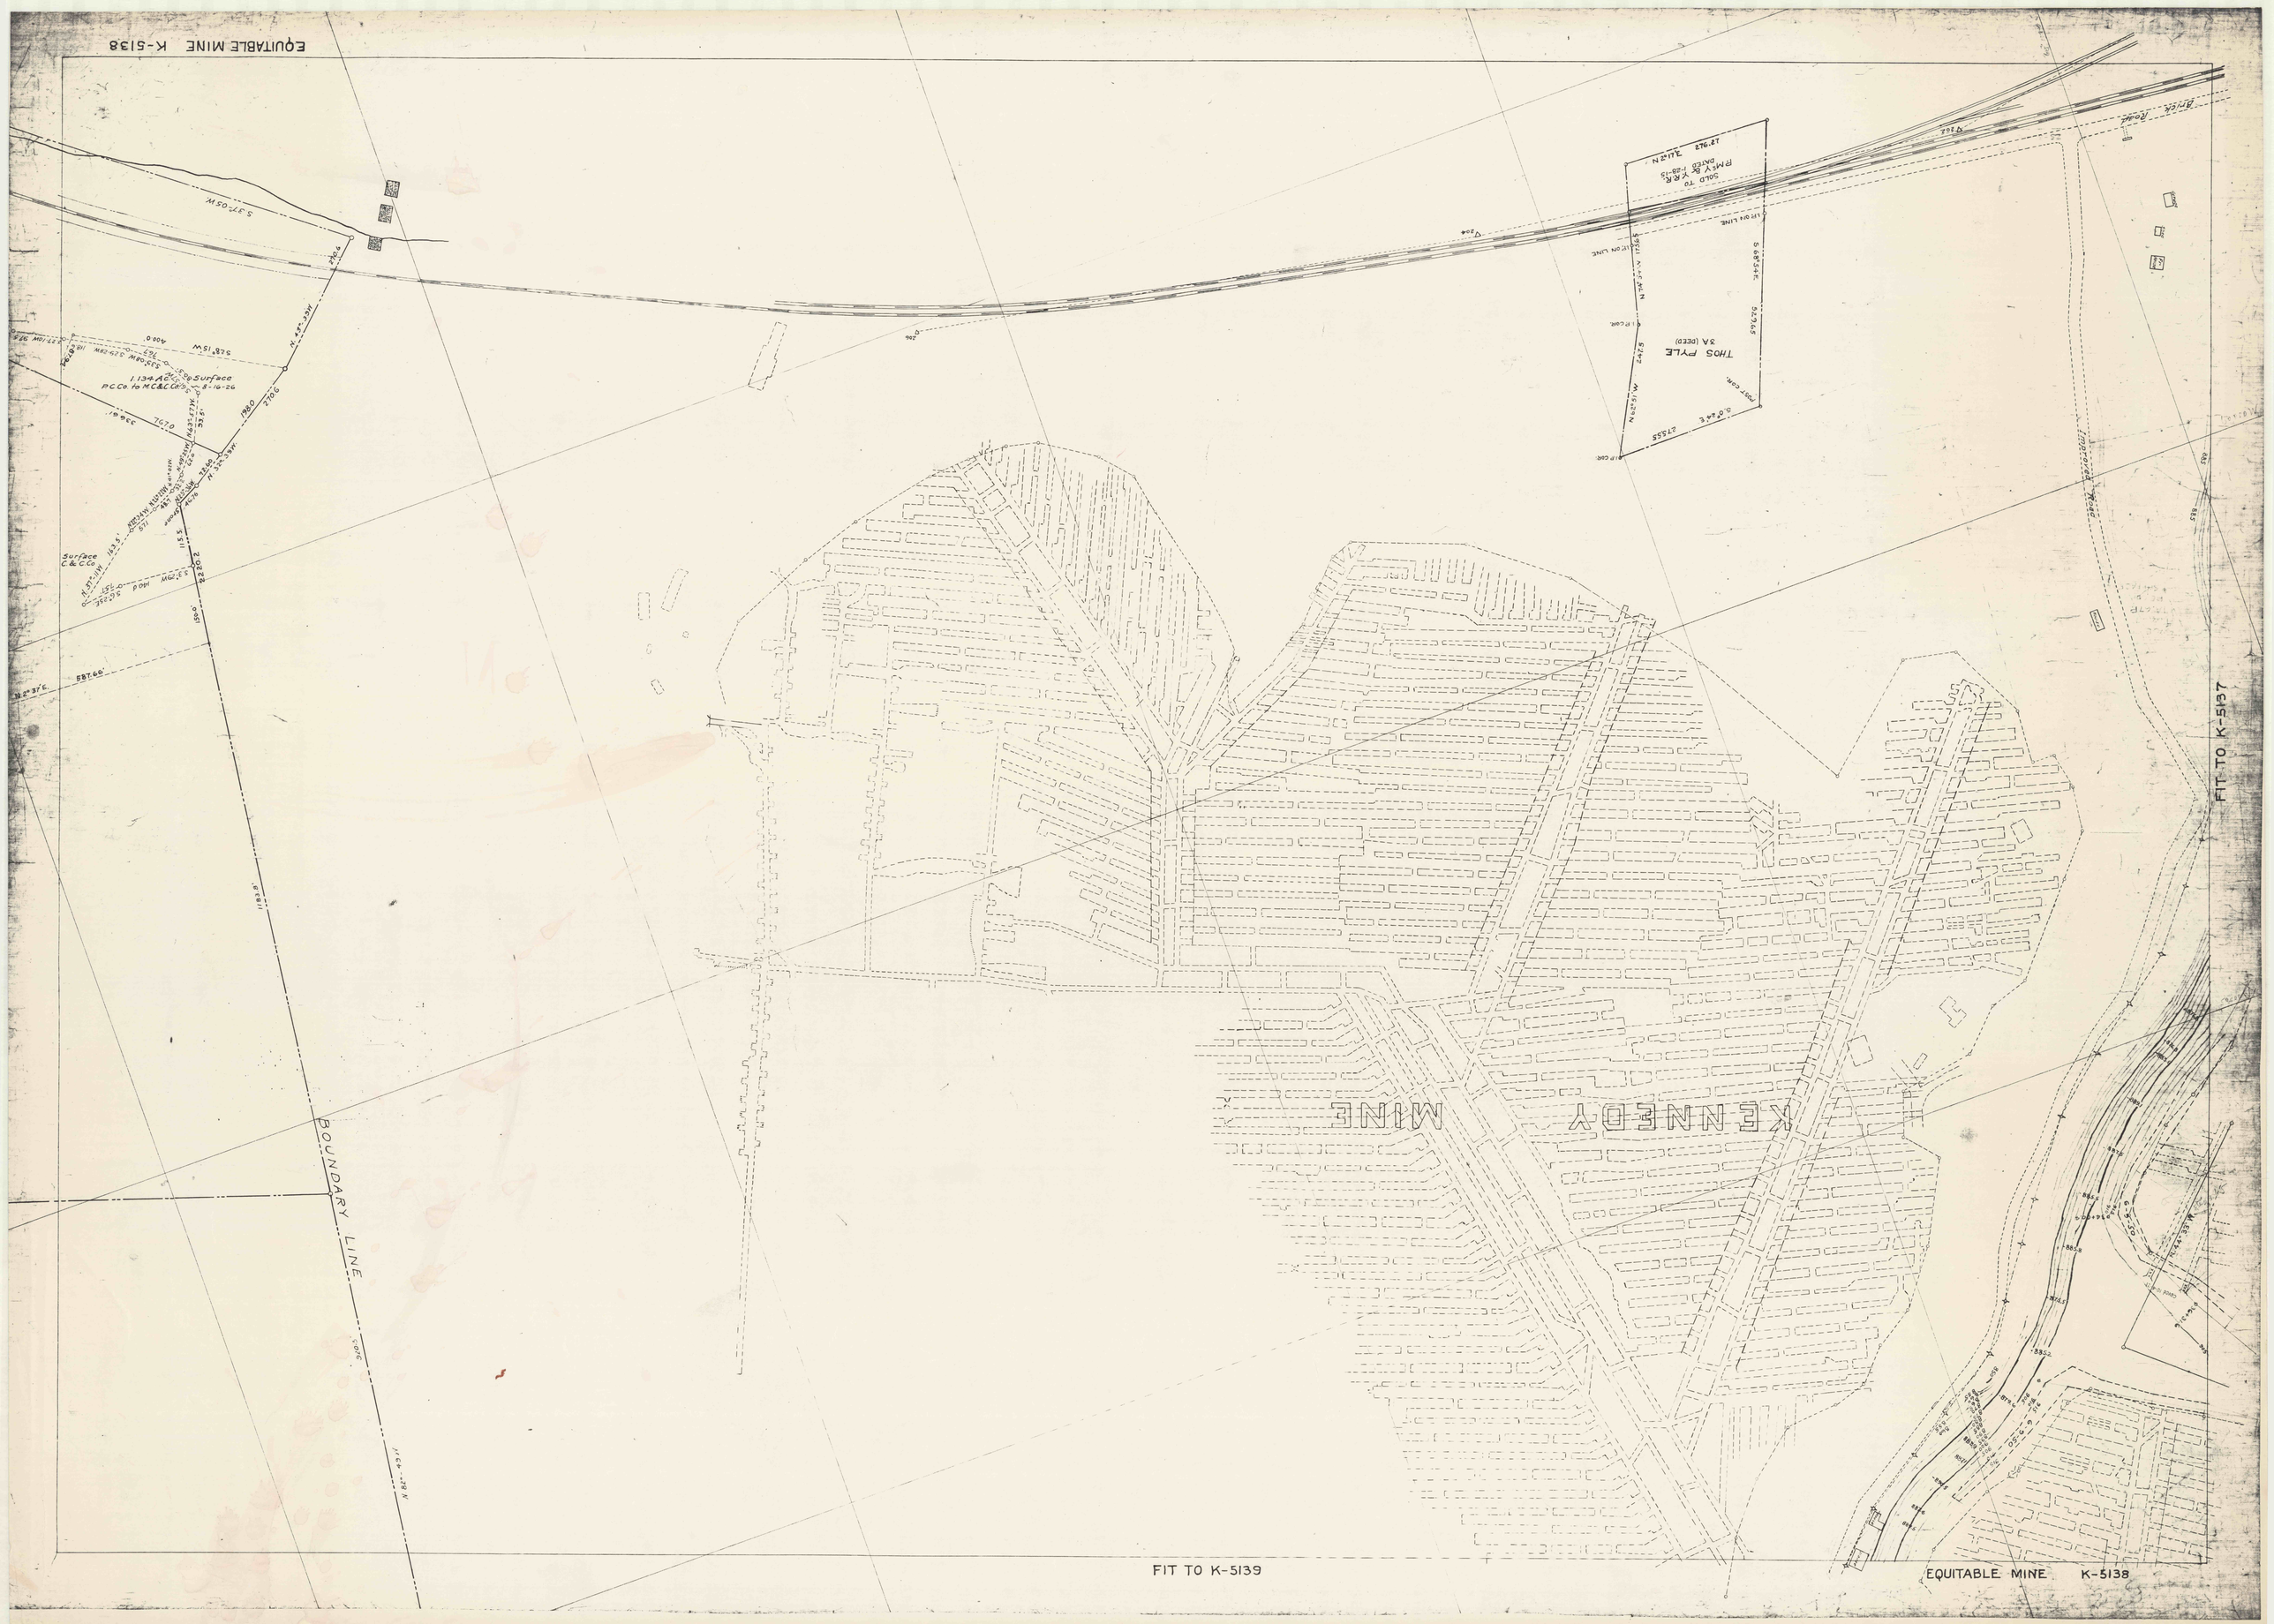EQUITABLE MINE K-5138