

BANNING & EQUABLE MINES K-5345

FIG TO K5194

FIG TO K5344

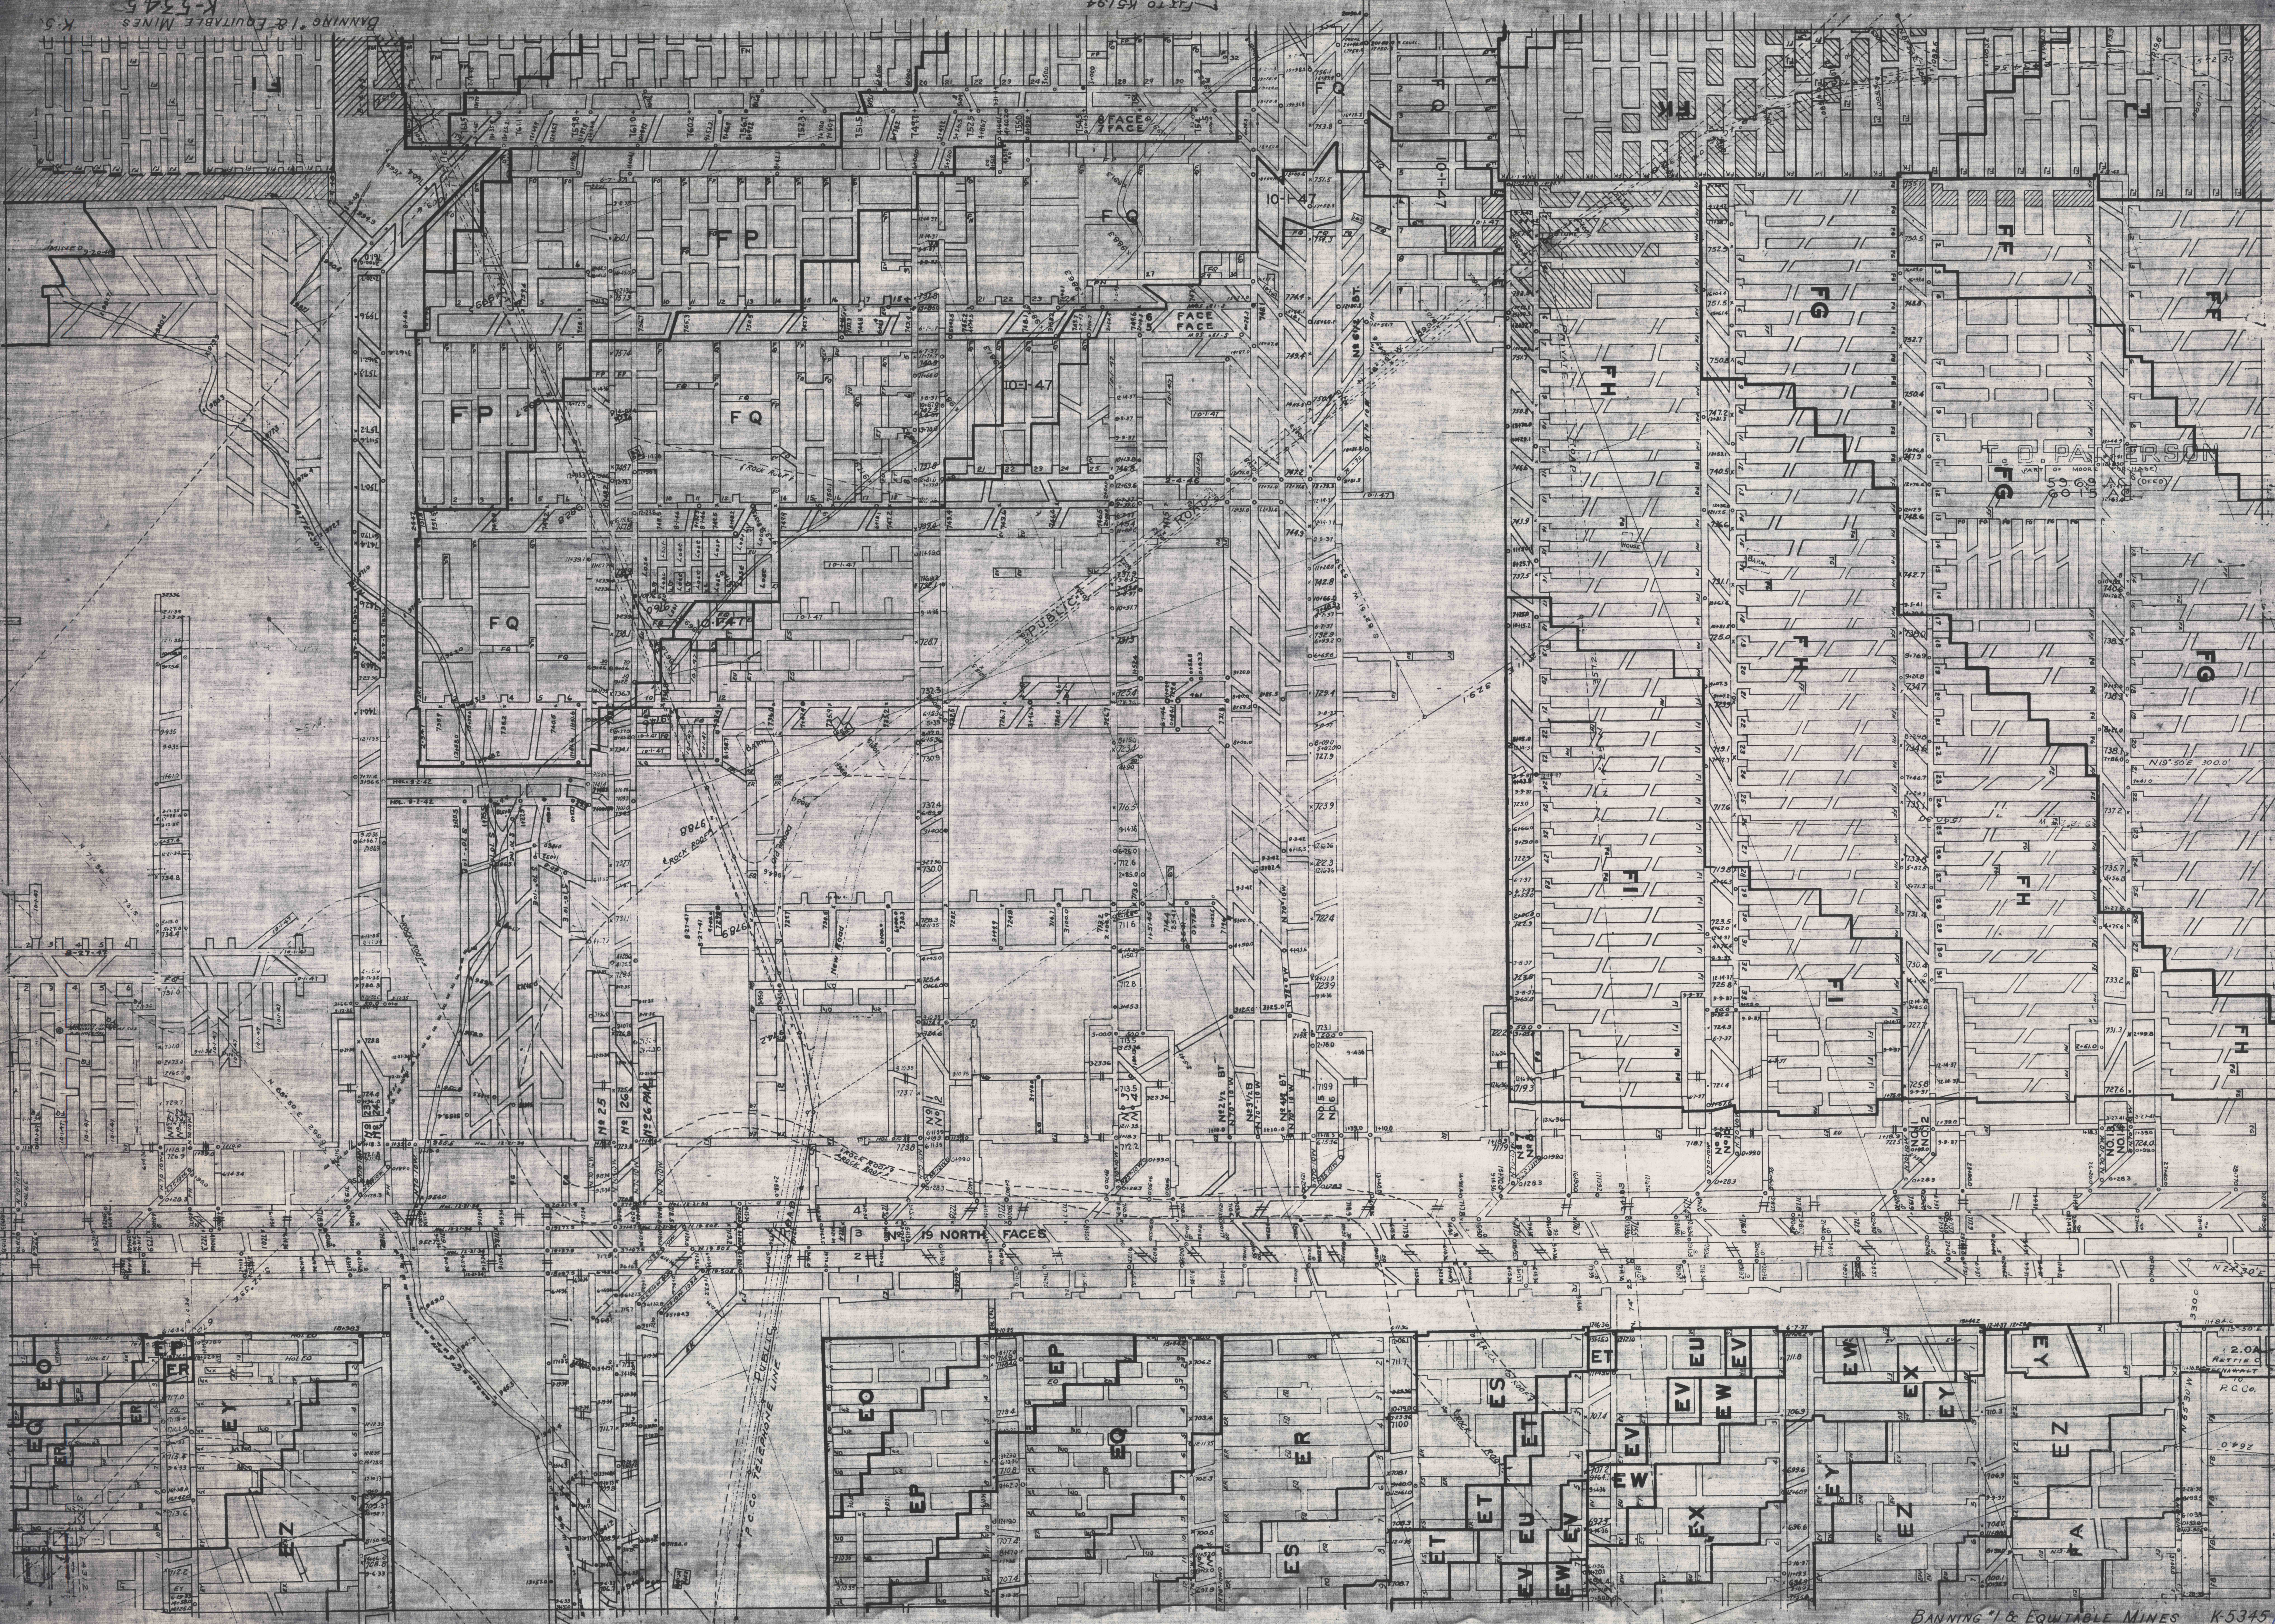


FIG TO K5352

BANNING & EQUABLE MINES K-5345

7-14-99
CC