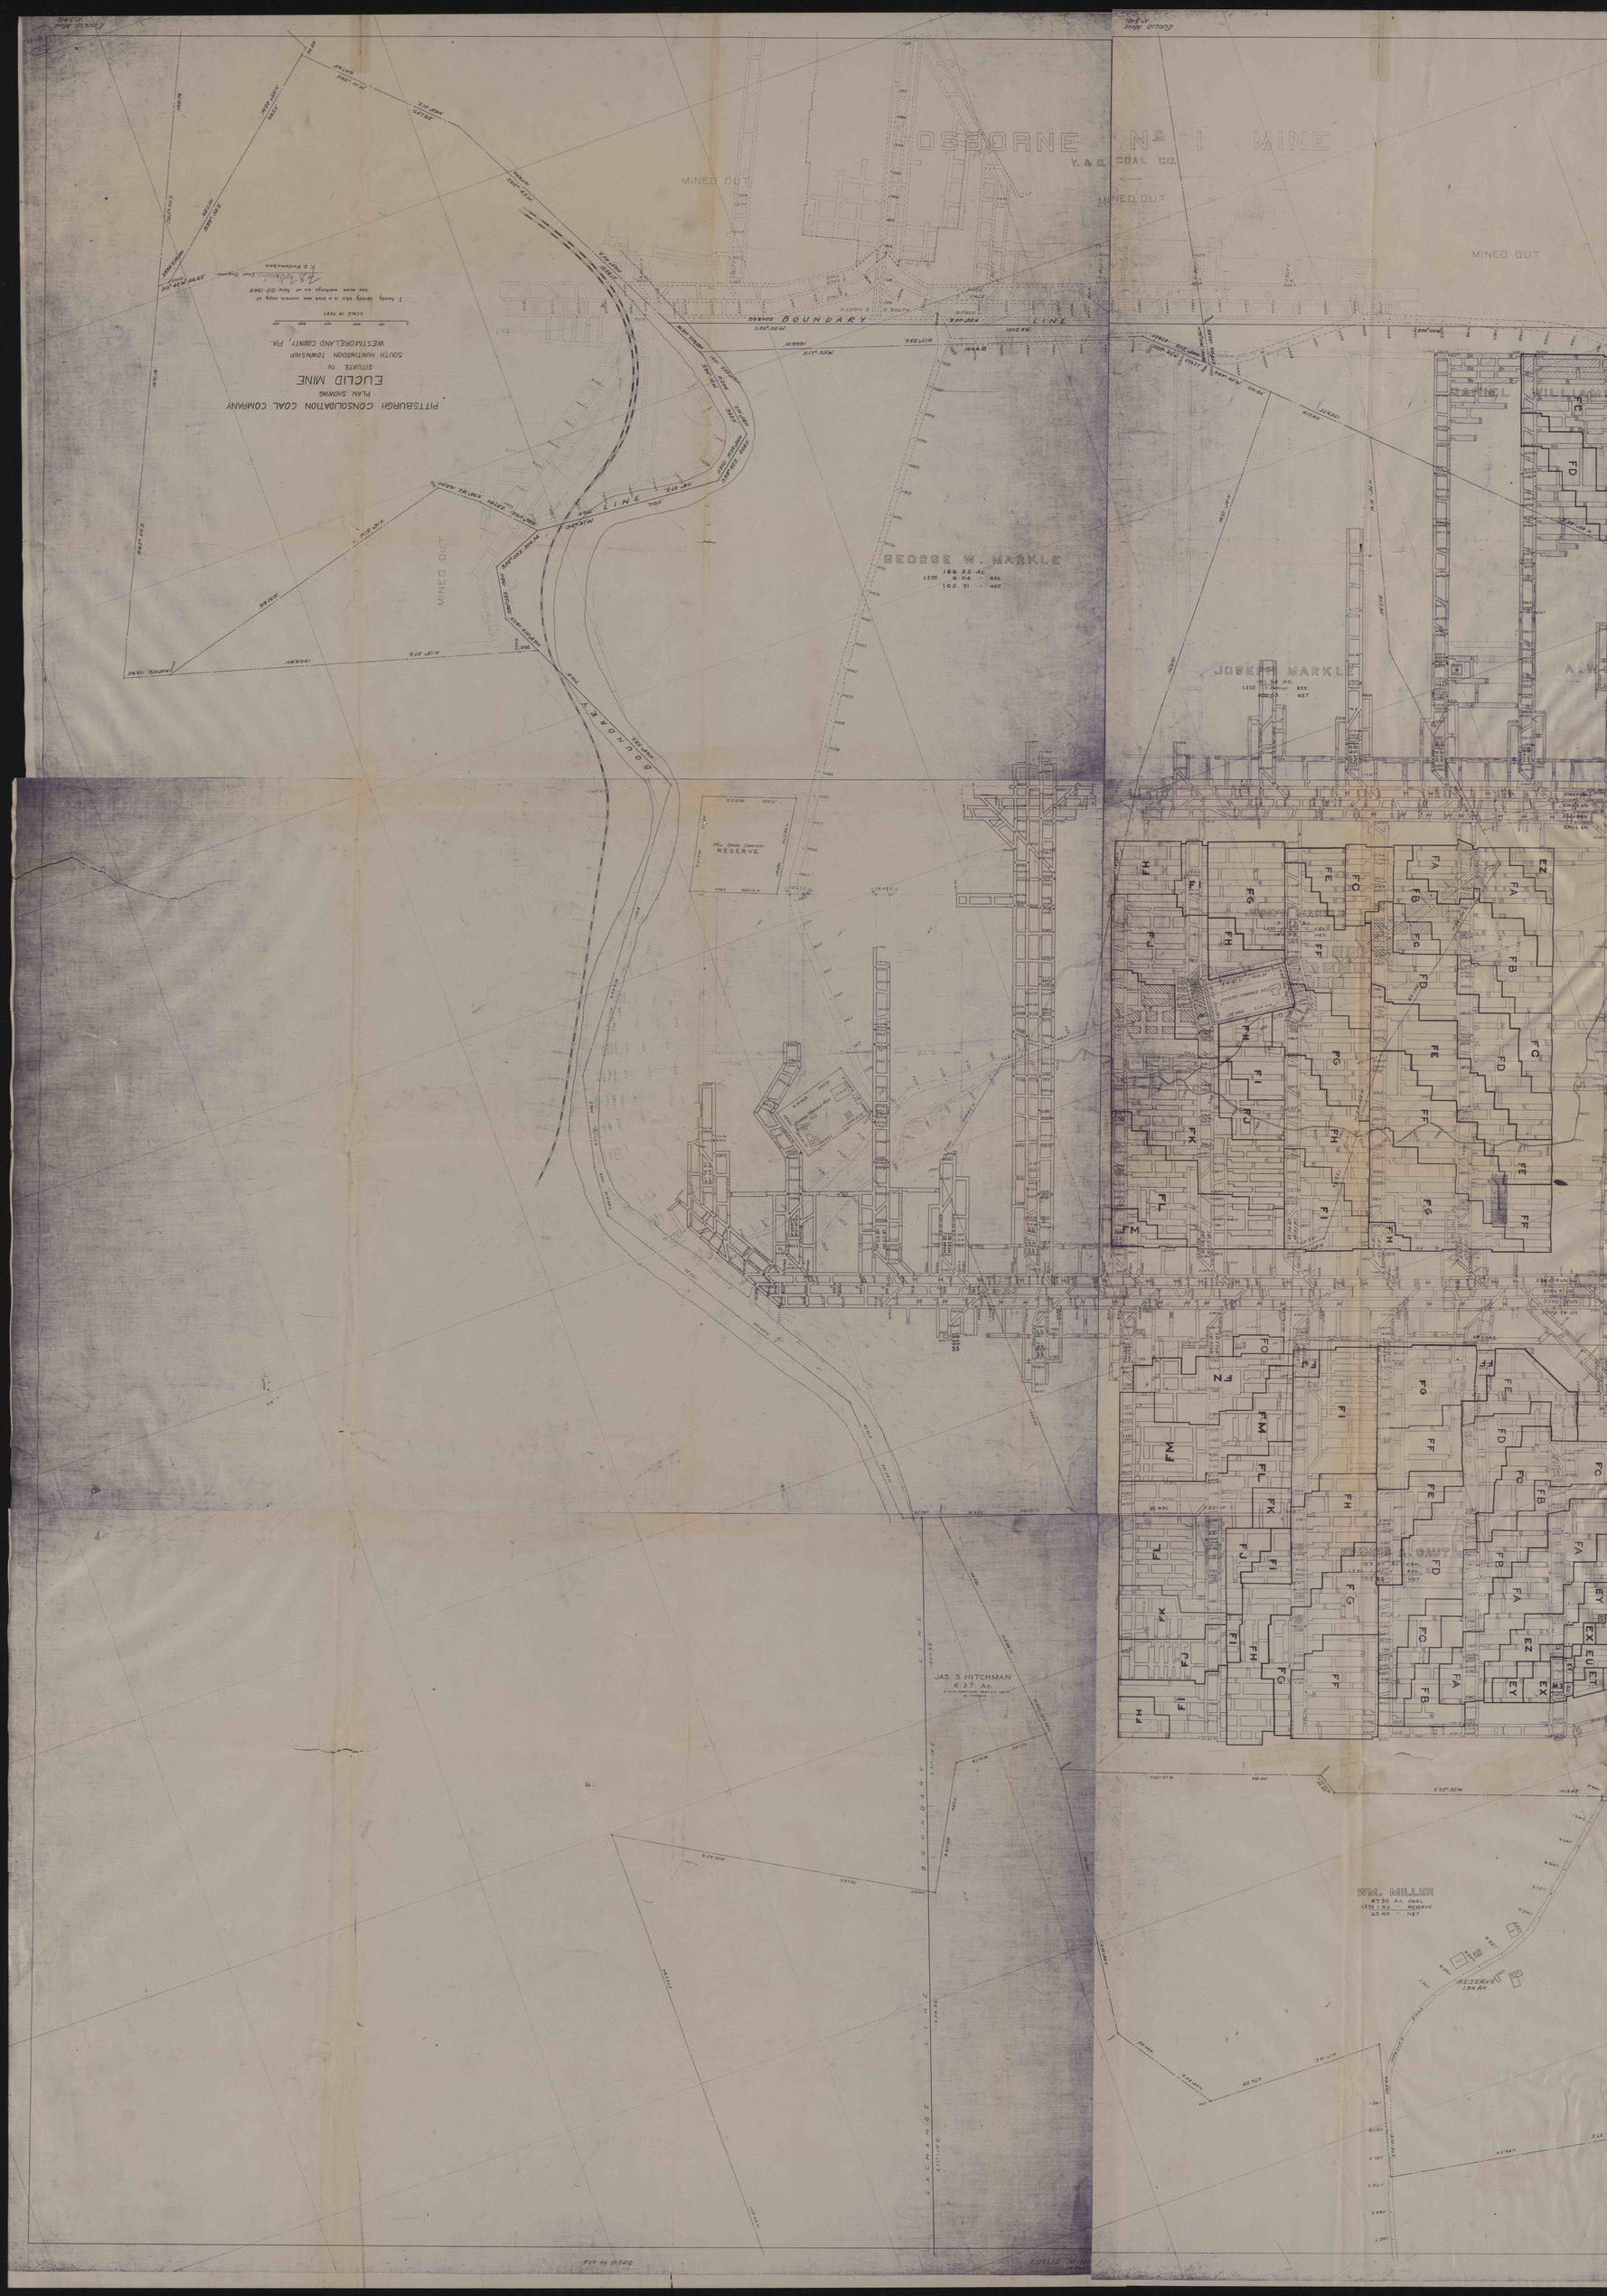

OSBORNE No 1 MINE
Y. & O. COAL CO.
MINED OUT
MINED OUT
MINED OUT
MINED OUT
BOUNDARY LINE
BOUNDARY LINE
PITTSBURGH CONSOLIDATION COAL COMPANY
PLAN SHOWING
EUCLID MINE
SITUATE IN
SOUTH HUNTINGDON TOWNSHIP
WESTMORELAND COUNTY, PA.
SCALE IN FEET
I hereby certify this is a true and correct copy of the mine working as of Nov. 20-1946
Y. S. Fallensbee
GEORGE W. MARKLE
166.35 AC.
LESS 4.04 - RES.
162.31 - NET.
JOSEPH MARKLE
101.53 AC.
LESS 1.00 - RES.
100.53 - NET
RESERVE
JAS. S. HITCHMAN
6.37 Ac.
WM. MILLER
67.30 AC. COAL
LESS 1.90 - RESERVE
65.40 - NET
RESERVE
1.90 Ac.
EXCHANGE LINE
BOUNDARY LINE