


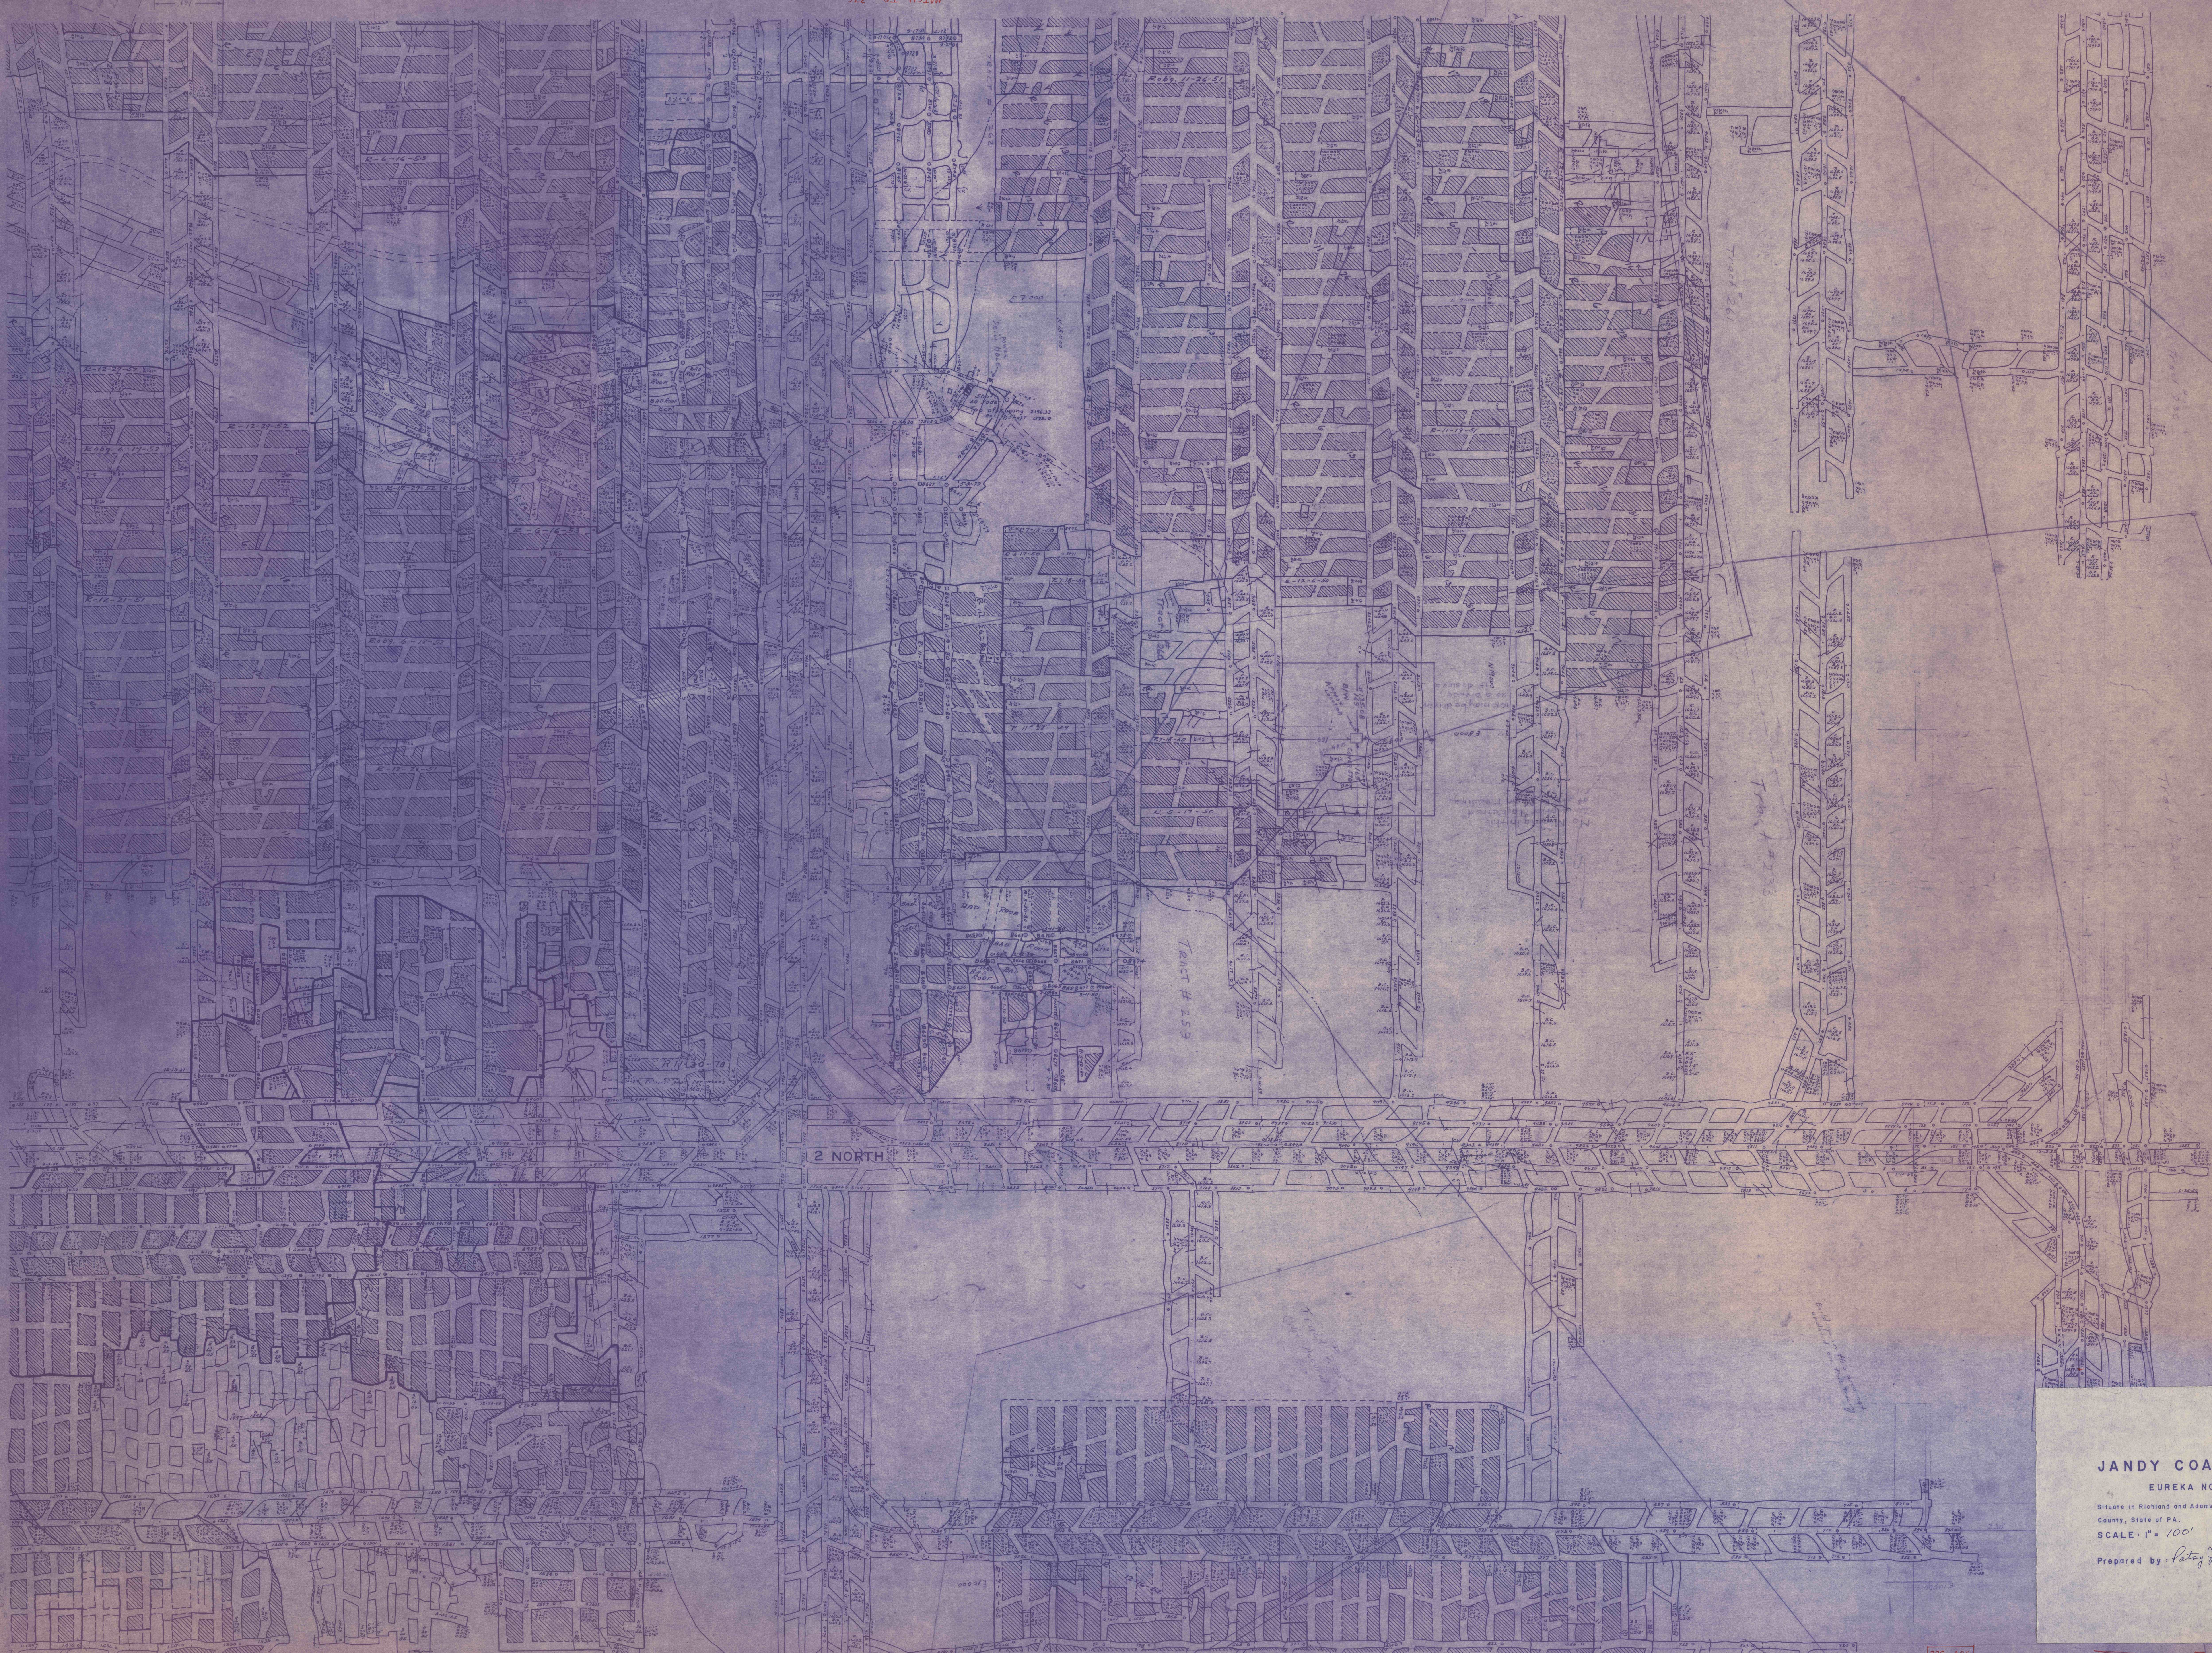

JANDY COAL CO., INC.
EUREKA NO. 40 MINE
Situate in Richmond and Adams Townships, Cambria
County, State of PA.
SCALE: 1" = 100' DATE: 9-17-82
Prepared by: *Patoy J. Franale*



27C-40C
10

#22
12674
CC