
 


JANDY COAL CO., INC.
EUREKA NO. 40 MINE
Slopes in Eureka and Adams Townships, Cambria
County, State of PA.
SCALE 1" = 100'
DATE 9-17-82
Prepared by *Robert J. Fawcett*

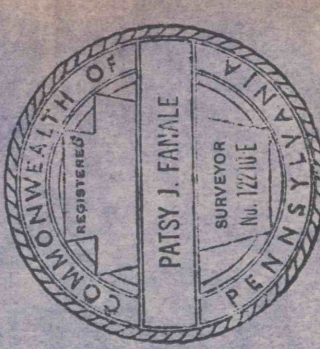

37-5-10-6

MATCH TO 37-5-10-7

326

324

322

320

925

328

TRACT # 311

No Additional Mining
in this
Area 5-16-80

act # 325

TRACT # 442

No Additional
Mining in this
Area 5-16-80

act # 325

923

MATCH TO 406

EUREKA AD. No. 1 NORTH PLAN