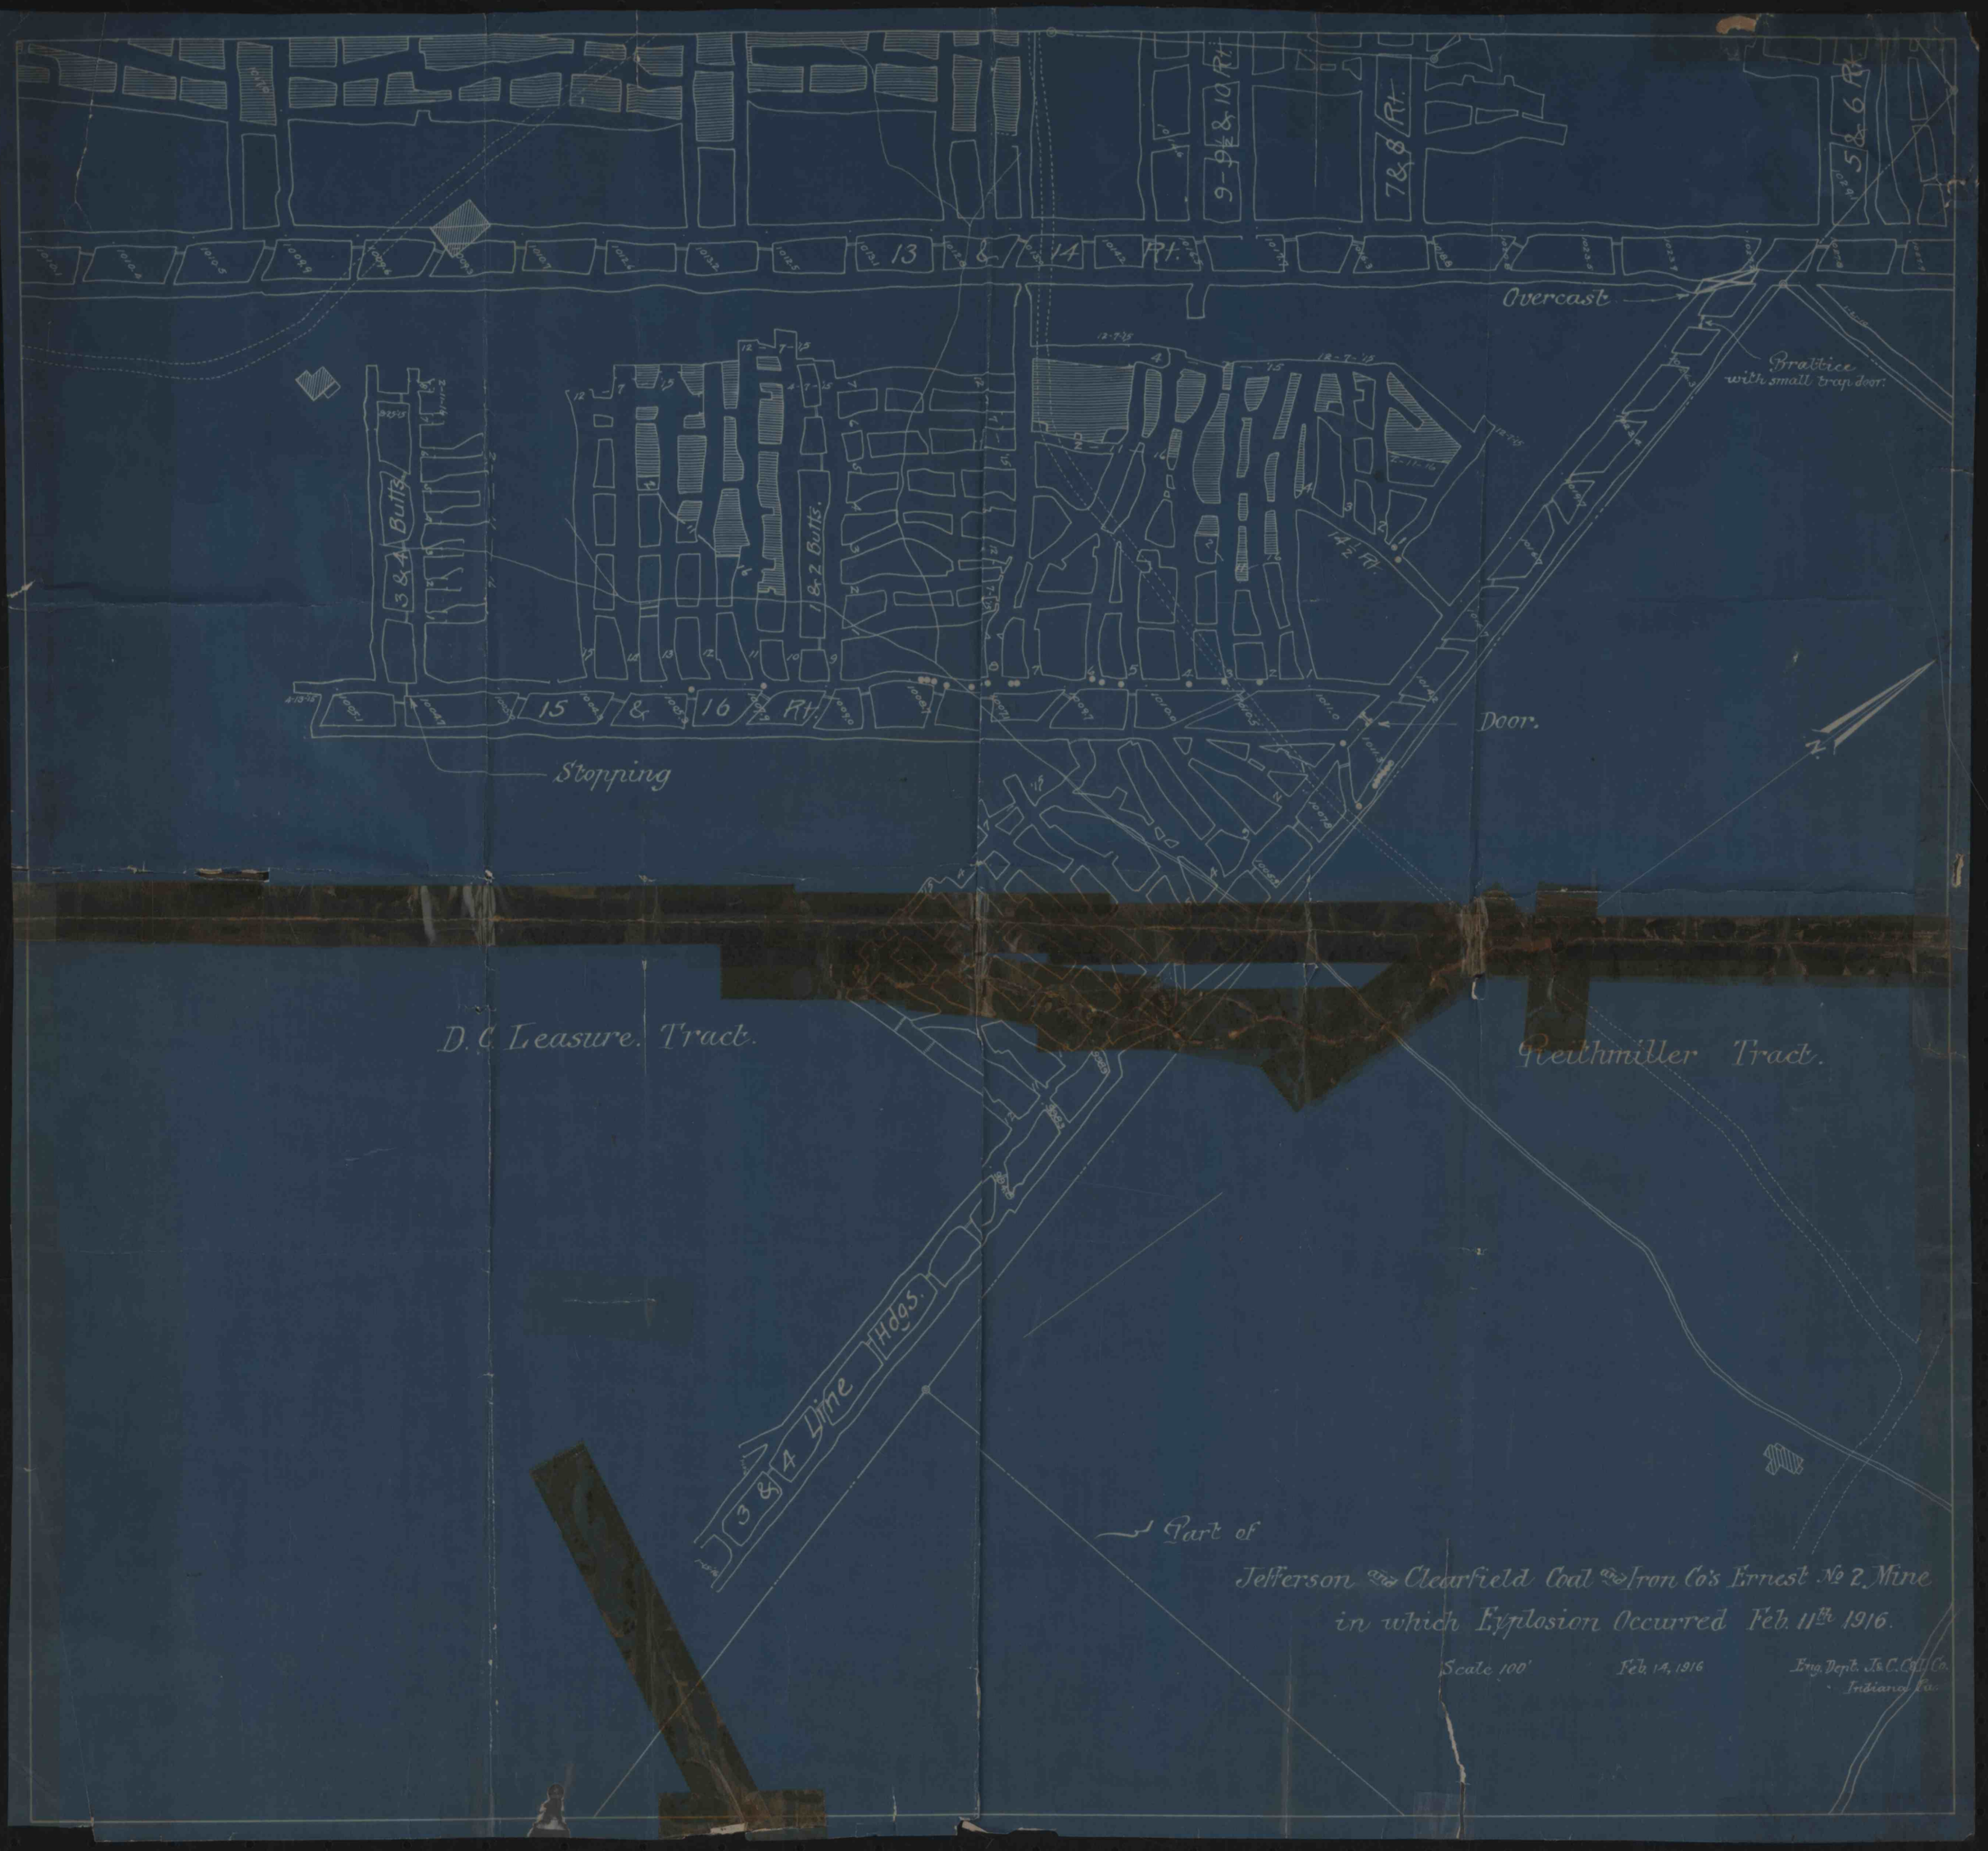

13 & 14 Rt.
9-9½ & 10 Rt.
7 & 8 Rt.
5 & 6 Rt.
Overcast
Brattice with small trap door.
3 & 4 Butts.
1 & 2 Butts.
14½ Rt.
15 & 16 Rt.
Door.
Stopping
D. C. Leasure. Tract.
Reithmiller Tract.
3 & 4 Line Hdgs.
Part of
Jefferson and Clearfield Coal and Iron Co's Ernest No 2 Mine
in which Explosion Occurred Feb. 11th 1916.
Scale 100'
Feb. 14, 1916
Eng. Dept. J. & C. Coal Co.
Indiana Pa.