


PART OF THE JOHN CARSON PROPERTY, AND OTHERS
SITUATE IN
ALLENPORT BOROUGH, WASHINGTON COUNTY PA.

OLD PLAN AND SURVEYS OCT. 1940 - FEB. 1941. Scale 1 in = 100 FT.

Alex. L. McKicker - Reg. Prof. Engr. #825.

- Additions - May 6-7 - 1941.
- " Feb 27 - 1942
- " May 4 - 1942
- " Nov. 21 - 1942.

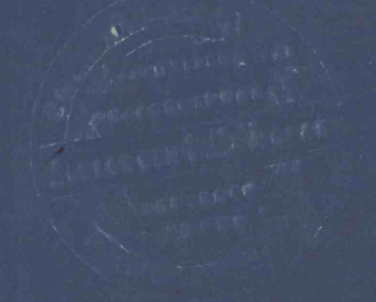

#949
7-15-99
cc