


PORTAGE COLLIERIES CO.
THICKET COAL-LEASE-COAL-COMPANY'S LEASE

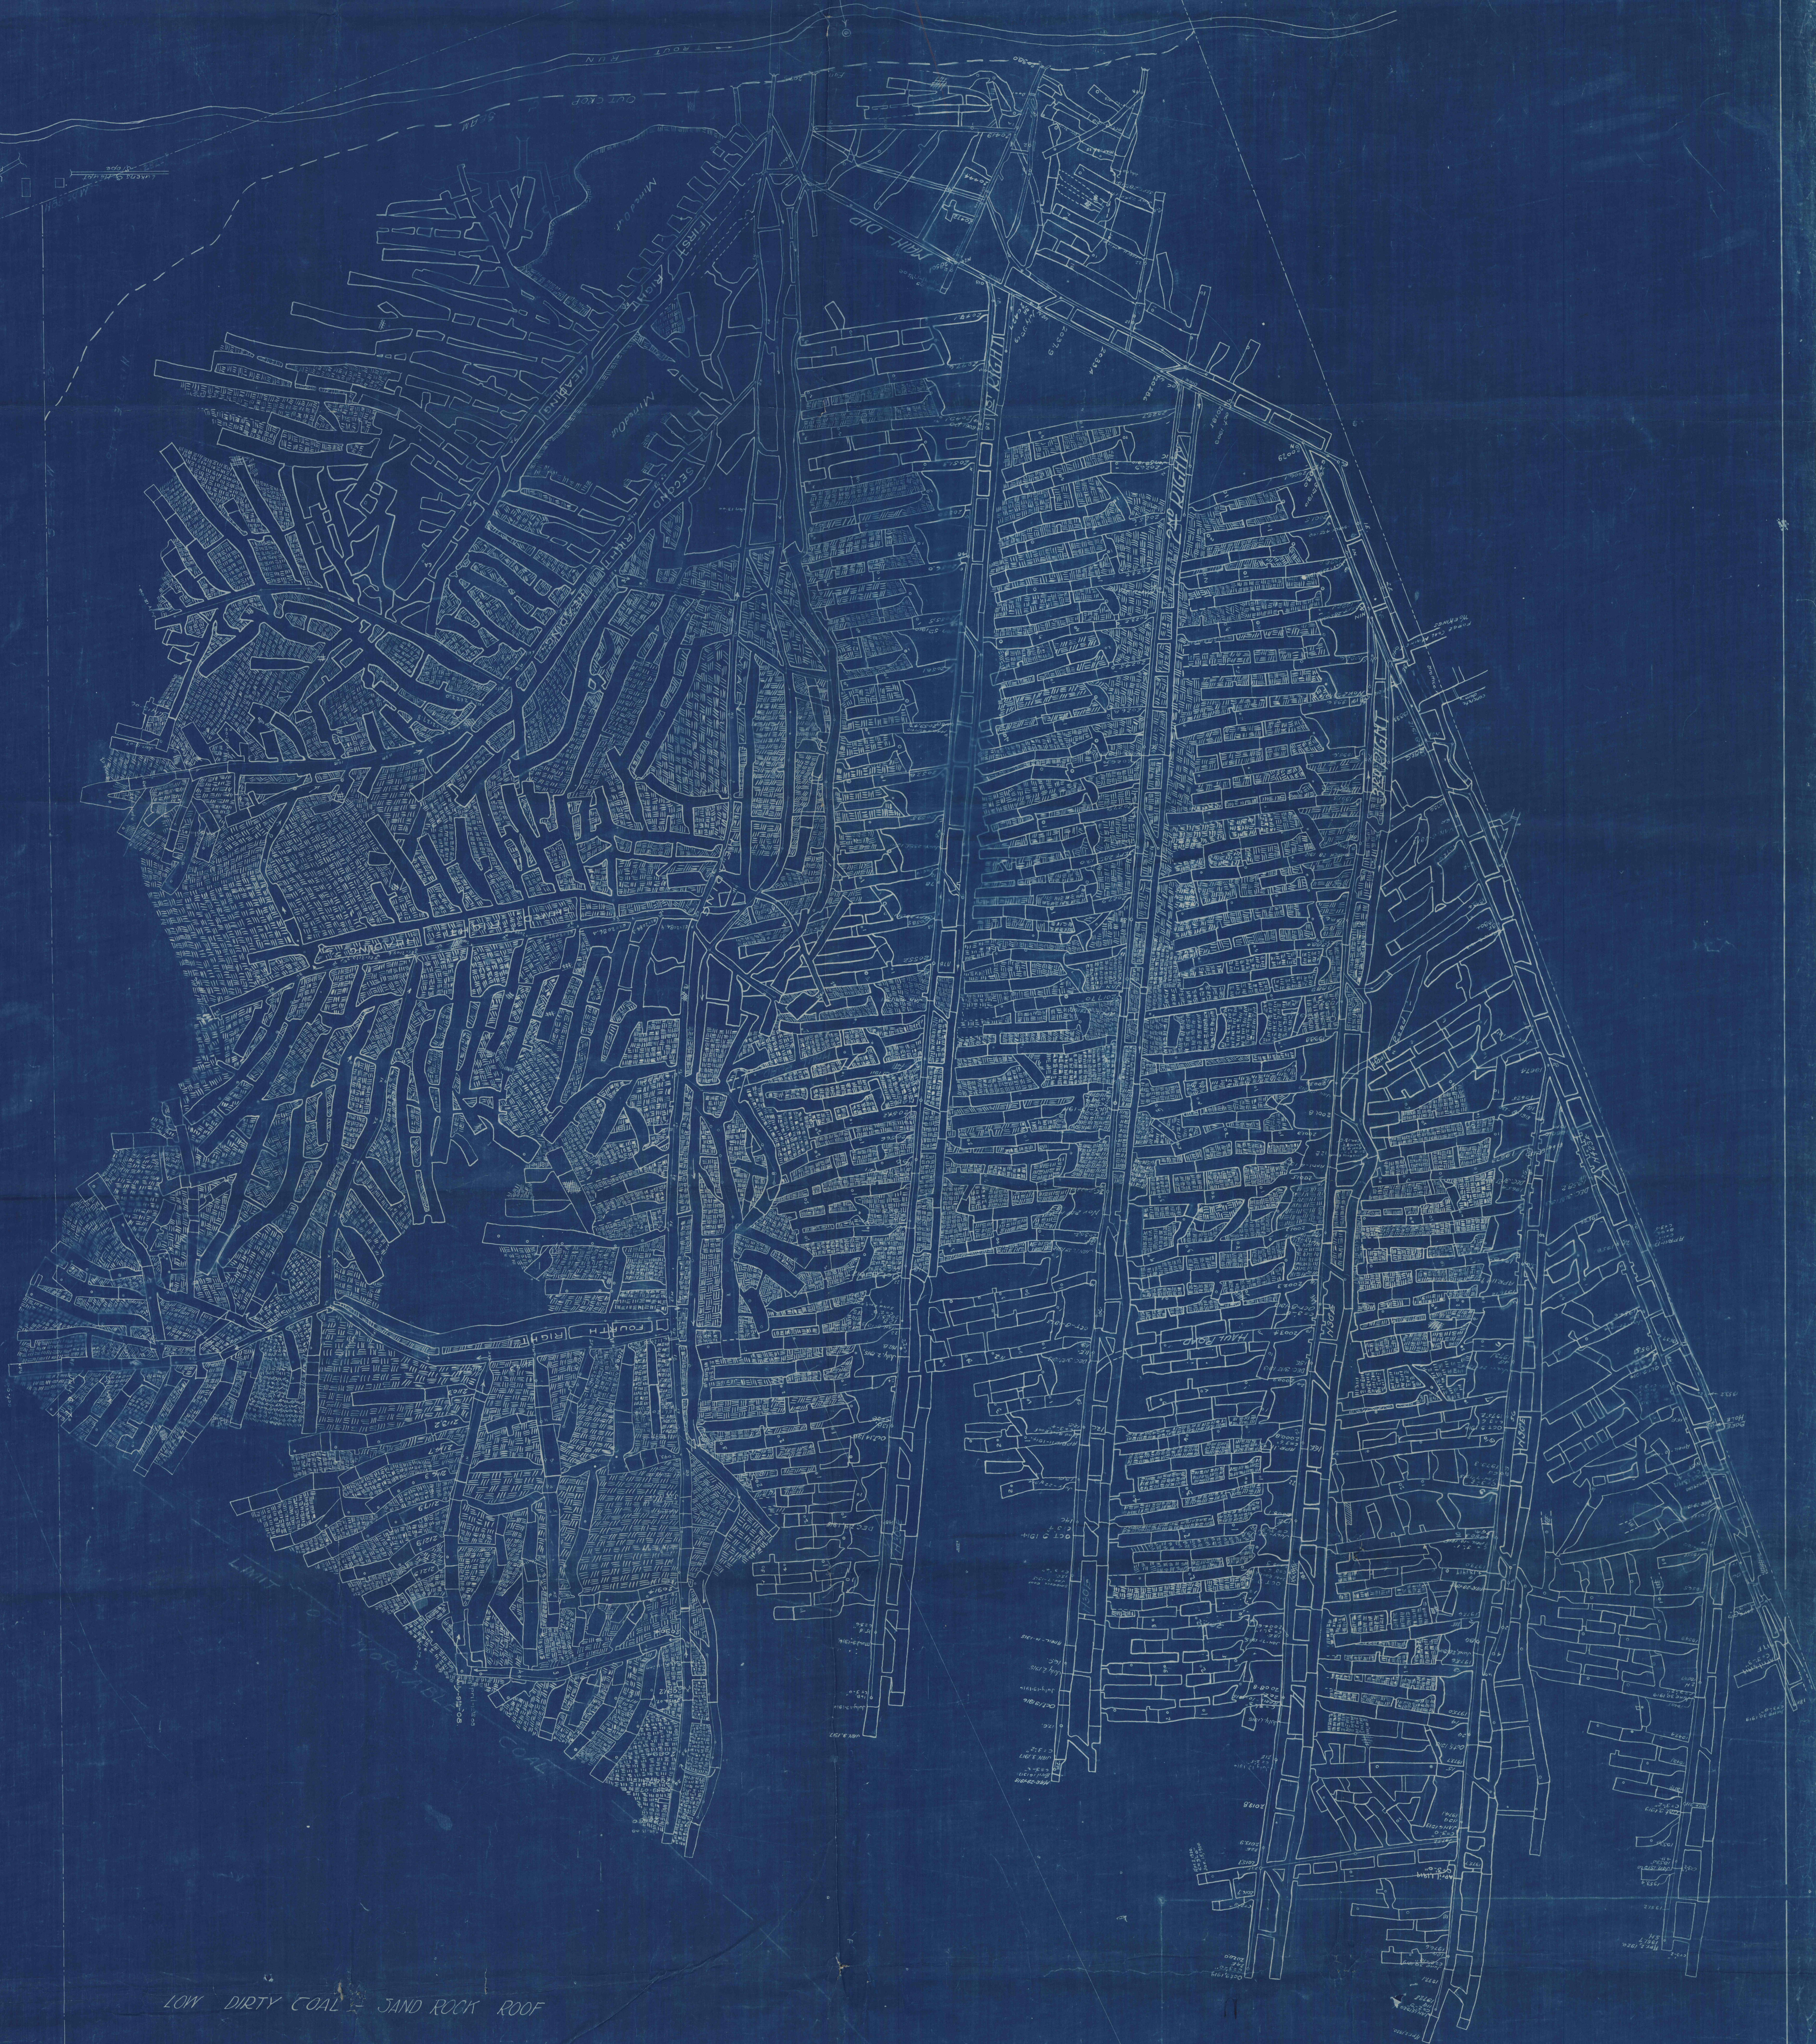

No. 9

Map of "C" Prime Coal Lease of
George Pearce & Sons
ON LANDS OF THE
CAMBRIA MINING & MAN'G CO.,
CAMBRIA COUNTY, PA.

Scale 1"=100'.

1906.

J.S. Sillyman & Co.