
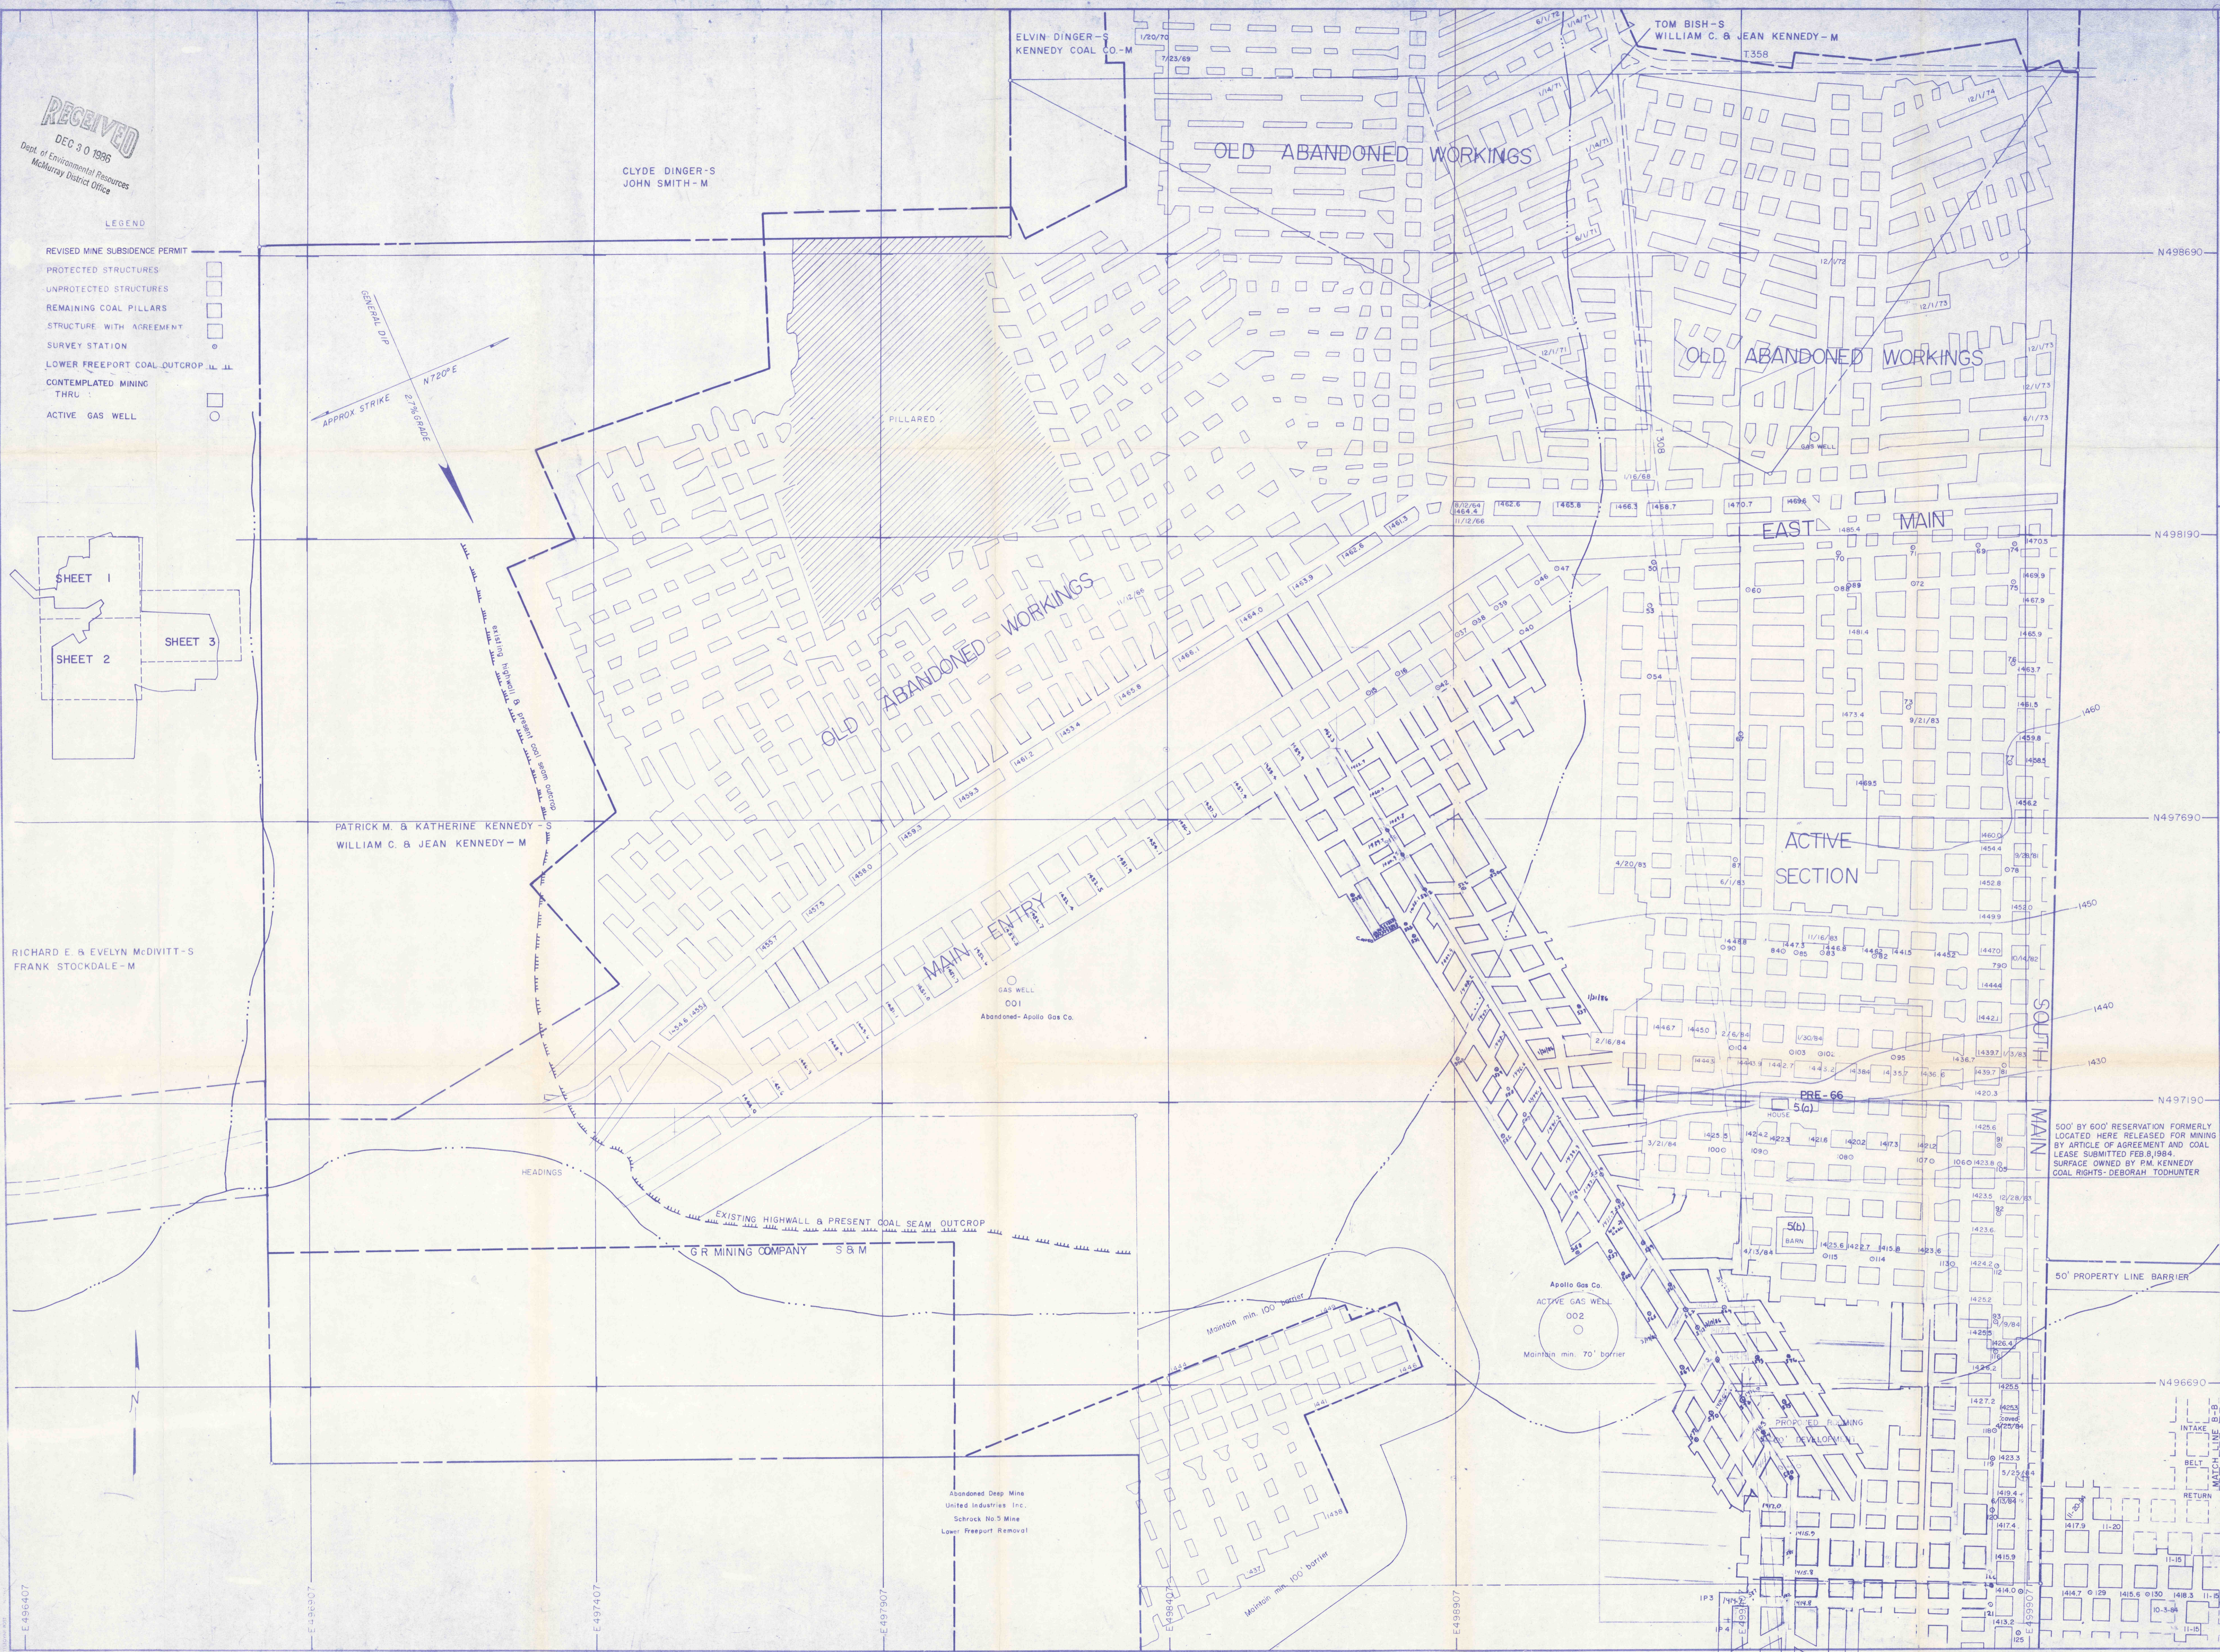


RECEIVED  
 DEC 9 0 1986  
 Dept. of Environmental Resources  
 McMurray District Office

- LEGEND
- REVISED MINE SUBSIDENCE PERMIT
  - PROTECTED STRUCTURES
  - UNPROTECTED STRUCTURES
  - REMAINING COAL PILLARS
  - STRUCTURE WITH AGREEMENT
  - SURVEY STATION
  - LOWER FREEPORT COAL OUTCROP
  - CONTEMPLATED MINING THRU
  - ACTIVE GAS WELL

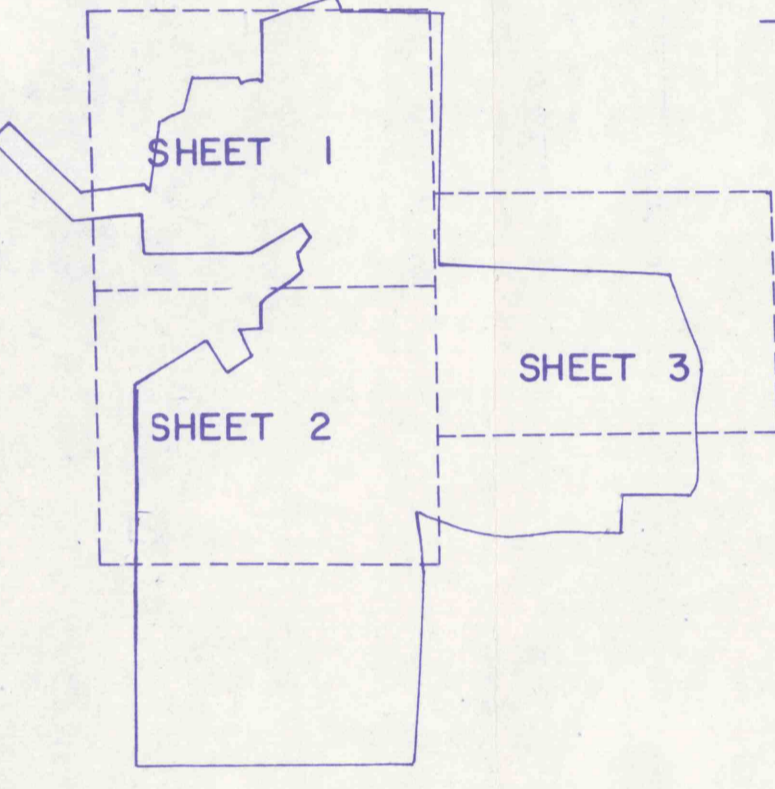

RICHARD E. & EVELYN McDIVITT-S  
 FRANK STOCKDALE-M

PATRICK M. & KATHERINE KENNEDY  
 WILLIAM C. & JEAN KENNEDY-M

ELVIN DINGER-S  
 KENNEDY COAL CO-M

TOM BISH-S  
 WILLIAM C. & JEAN KENNEDY-M

Abandoned Deep Mine  
 United Industries Inc.  
 Schrock No 3 Mine  
 Lower Freeport Removal

50' BY 60' RESERVATION FORMERLY  
 LOCATED HERE RELEASED FOR MINING  
 BY ARTICLE OF AGREEMENT AND COAL  
 LEASE, SUBMITTED FEB. 8, 1984.  
 SURFACE OWNED BY DM KENNEDY  
 COAL RIGHTS - DEBORAH TODDUNTER

NOTE: Mine site locations & elevations provided by  
 survey of Plateau Corporation  
 & GR Mining Company.

EXISTING DEEP MINE  
 LOWER FREEPORT COAL SEAM  
**G R MINING COMPANY**  
 FAIRVIEW NO. 5 DEEP MINE  
 Porter & Perry Twp. Jefferson Co.

SHEET 1 OF 3  
 FINAL  
 CLOSURE  
 EXTENT

VAPCO ENGINEERING  
 PUNXSUTAWNEY, PENNSYLVANIA

APPROVED: [Signature]  
 DATE: 12-22-86  
 APPROVED: [Signature]  
 DATE: 12-22-86  
