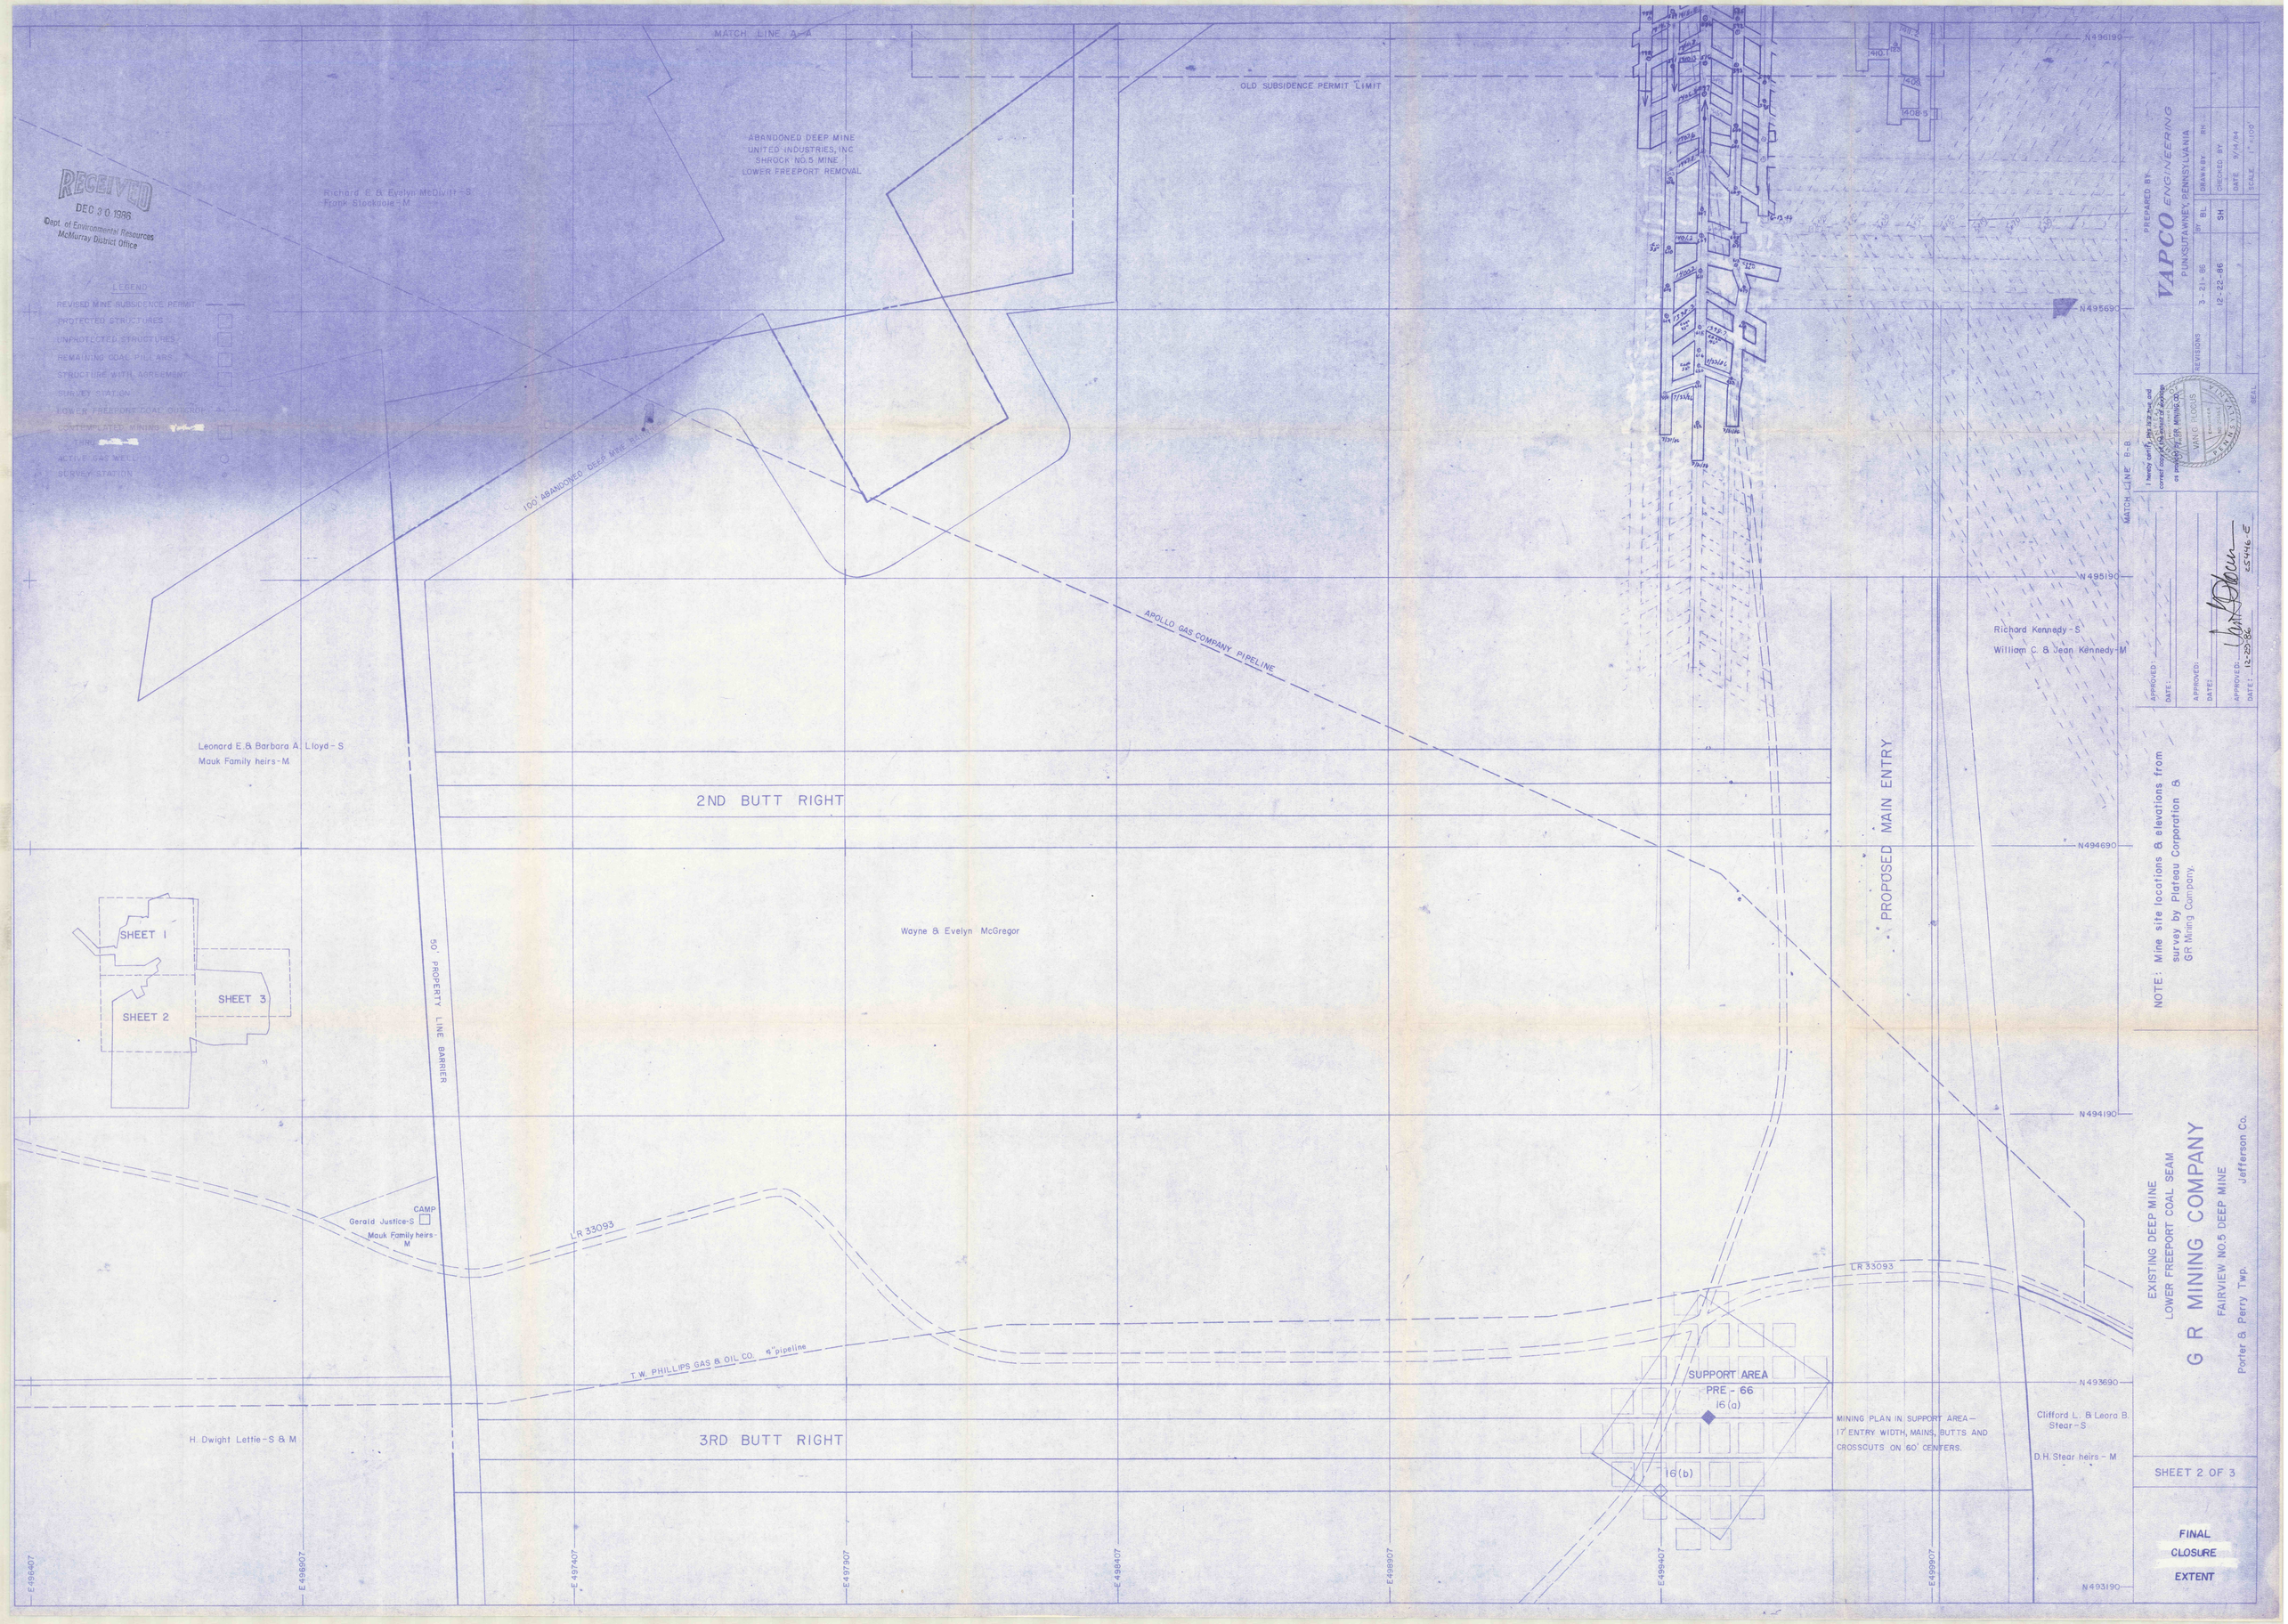

MATCH LINE A-A
OLD SUBSIDENCE PERMIT LIMIT
ABANDONED DEEP MINE
UNITED INDUSTRIES, INC
SHROCK NO.5 MINE
LOWER FREEPORT REMOVAL
Richard E. & Evelyn McDivitt-S
Frank Stockdale-M
RECEIVED
DEC 30 1986
Dept. of Environmental Resources
McMurray District Office
LEGEND
REVISED MINE SUBSIDENCE PERMIT
PROTECTED STRUCTURES
UNPROTECTED STRUCTURES
REMAINING COAL PILLARS
STRUCTURE WITH AGREEMENT
SURVEY STATION
LOWER FREEPORT COAL OUTCROP
CONTEMPLATED MINING
ACTIVE GAS WELL
SURVEY STATION
100' ABANDONED DEEP MINE BARRIER
APOLLO GAS COMPANY PIPELINE
Leonard E. & Barbara A. Lloyd-S
Mauk Family heirs-M
2ND BUTT RIGHT
Wayne & Evelyn McGregor
50' PROPERTY LINE BARRIER
SHEET 1
SHEET 2
SHEET 3
CAMP
Gerald Justice-S
Mauk Family heirs-M
LR 33093
T.W. PHILLIPS GAS & OIL CO. 4" pipeline
H. Dwight Lettie-S & M
3RD BUTT RIGHT
SUPPORT AREA
PRE-66
16(a)
16(b)
MINING PLAN IN SUPPORT AREA—
17' ENTRY WIDTH, MAINS, BUTTS AND
CROSSCUTS ON 60' CENTERS.
PROPOSED MAIN ENTRY
Richard Kennedy-S
William C. & Jean Kennedy-M
Clifford L. & Leora B. Stear-S
D.H. Stear heirs-M
N496190
N495690
N495190
N494690
N494190
N493690
N493190
E496407
E496907
E497407
E497907
E498407
E498907
E499407
E499907
MATCH LINE B-B
PREPARED BY
VAPCO ENGINEERING
PUNXSUTAWNEY, PENNSYLVANIA
REVISIONS
3-21-86
12-22-86
DRAWN BY RH
CHECKED BY
DATE 9/14/84
SCALE 1"=100'
I hereby certify this is true and correct copy of the entire or portion as provided by GR MINING CO.
VANCE FLOCUS
ENGINEER
PENNSYLVANIA
SEAL
APPROVED:
DATE:
APPROVED:
DATE:
APPROVED:
DATE: 12-29-86
25446-E
NOTE: Mine site locations & elevations from survey by Plateau Corporation & GR Mining Company.
EXISTING DEEP MINE
LOWER FREEPORT COAL SEAM
G R MINING COMPANY
FAIRVIEW NO.5 DEEP MINE
Porter & Perry Twp.
Jefferson Co.
SHEET 2 OF 3
FINAL
CLOSURE
EXTENT