


JACOB SNYDER

M. B. KUNSELMAN

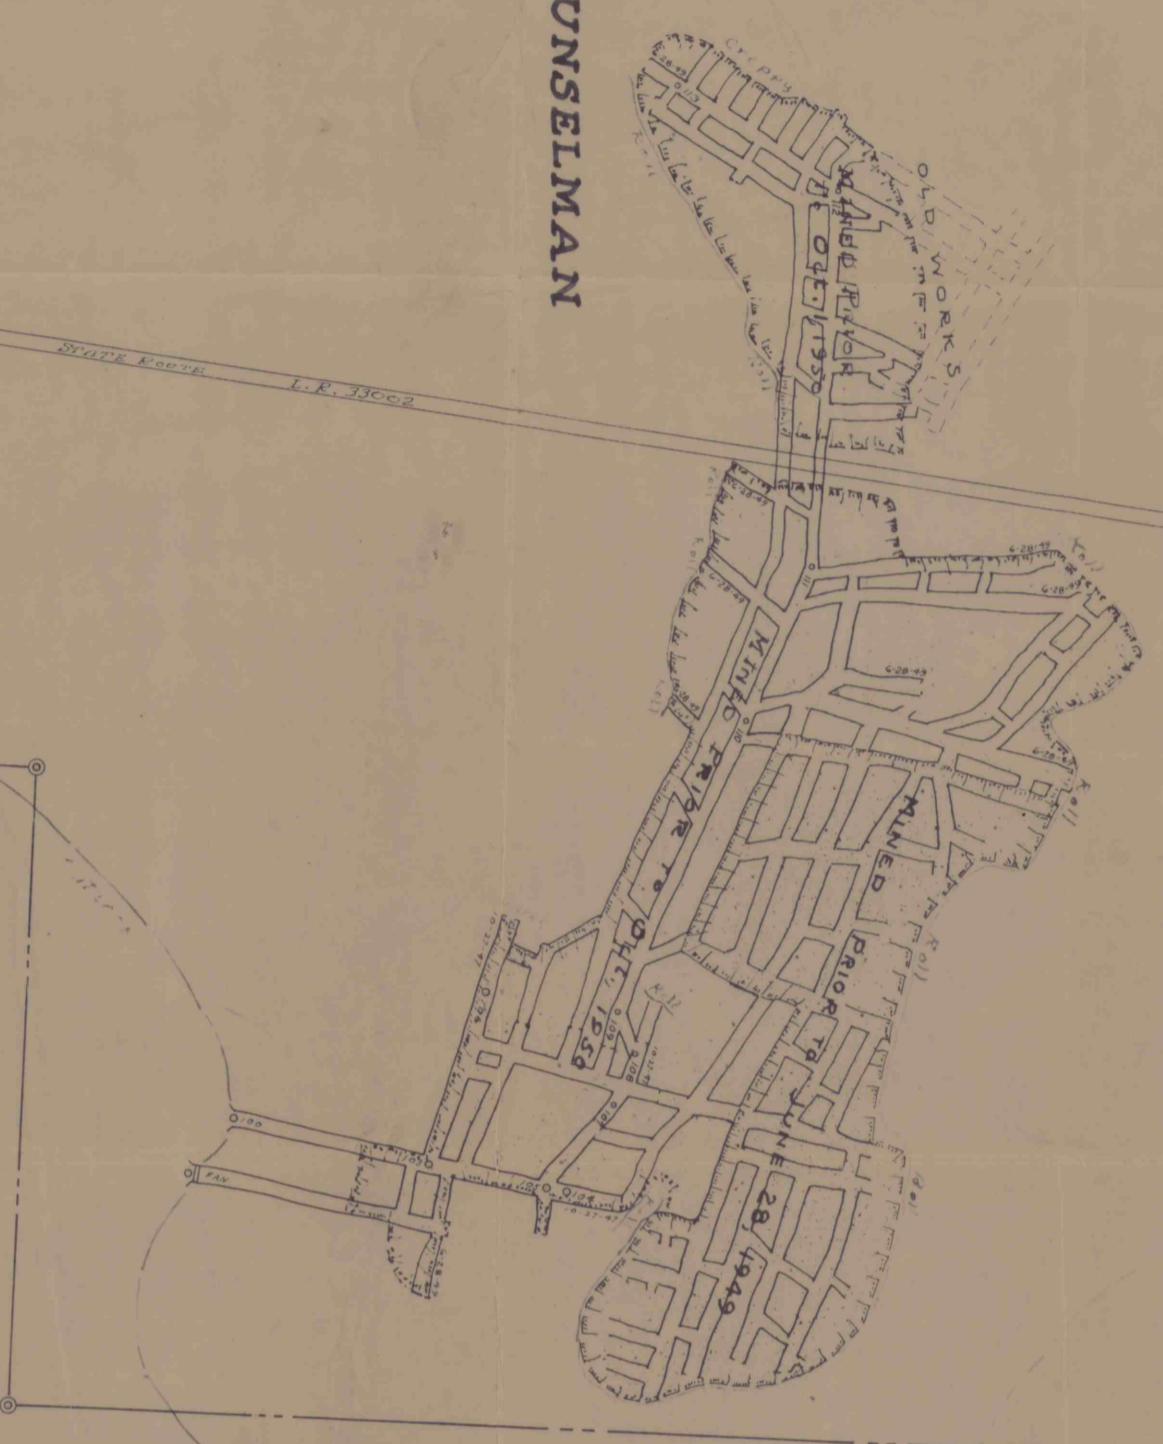

I hereby certify that this is a true and correct copy  
 of the original map of Fairview Mine No. 2  
 and that the original map is a true, correct  
 and survey of all the excavated

Walter J. Zimmermann  
 Surveyor  
 No. 4940



**FAIRVIEW COAL CO.,**  
**MINE NO. 2**

PORTER TOWNSHIP, JEFFERSON COUNTY, PA.

SCALE 1 - 100  
 WALTER J ZIMMERMAN SURVEYOR PUNXSUTAWNEY, PA.

General Survey  
 June 28, 1949

#3909  
 7-10-49  
 C.C.