


TRACT OF SEWICKLEY COAL
OWNED BY HOGSETT COKE CO.
OPERATED BY
FAITH COAL CO.
North Union Twp, Fayette Co., Pa.
Scale 1"=100'
Homer L. Burchinal, Engr., Uniontown, Pa.

SURVEY DATES:
4-22-20

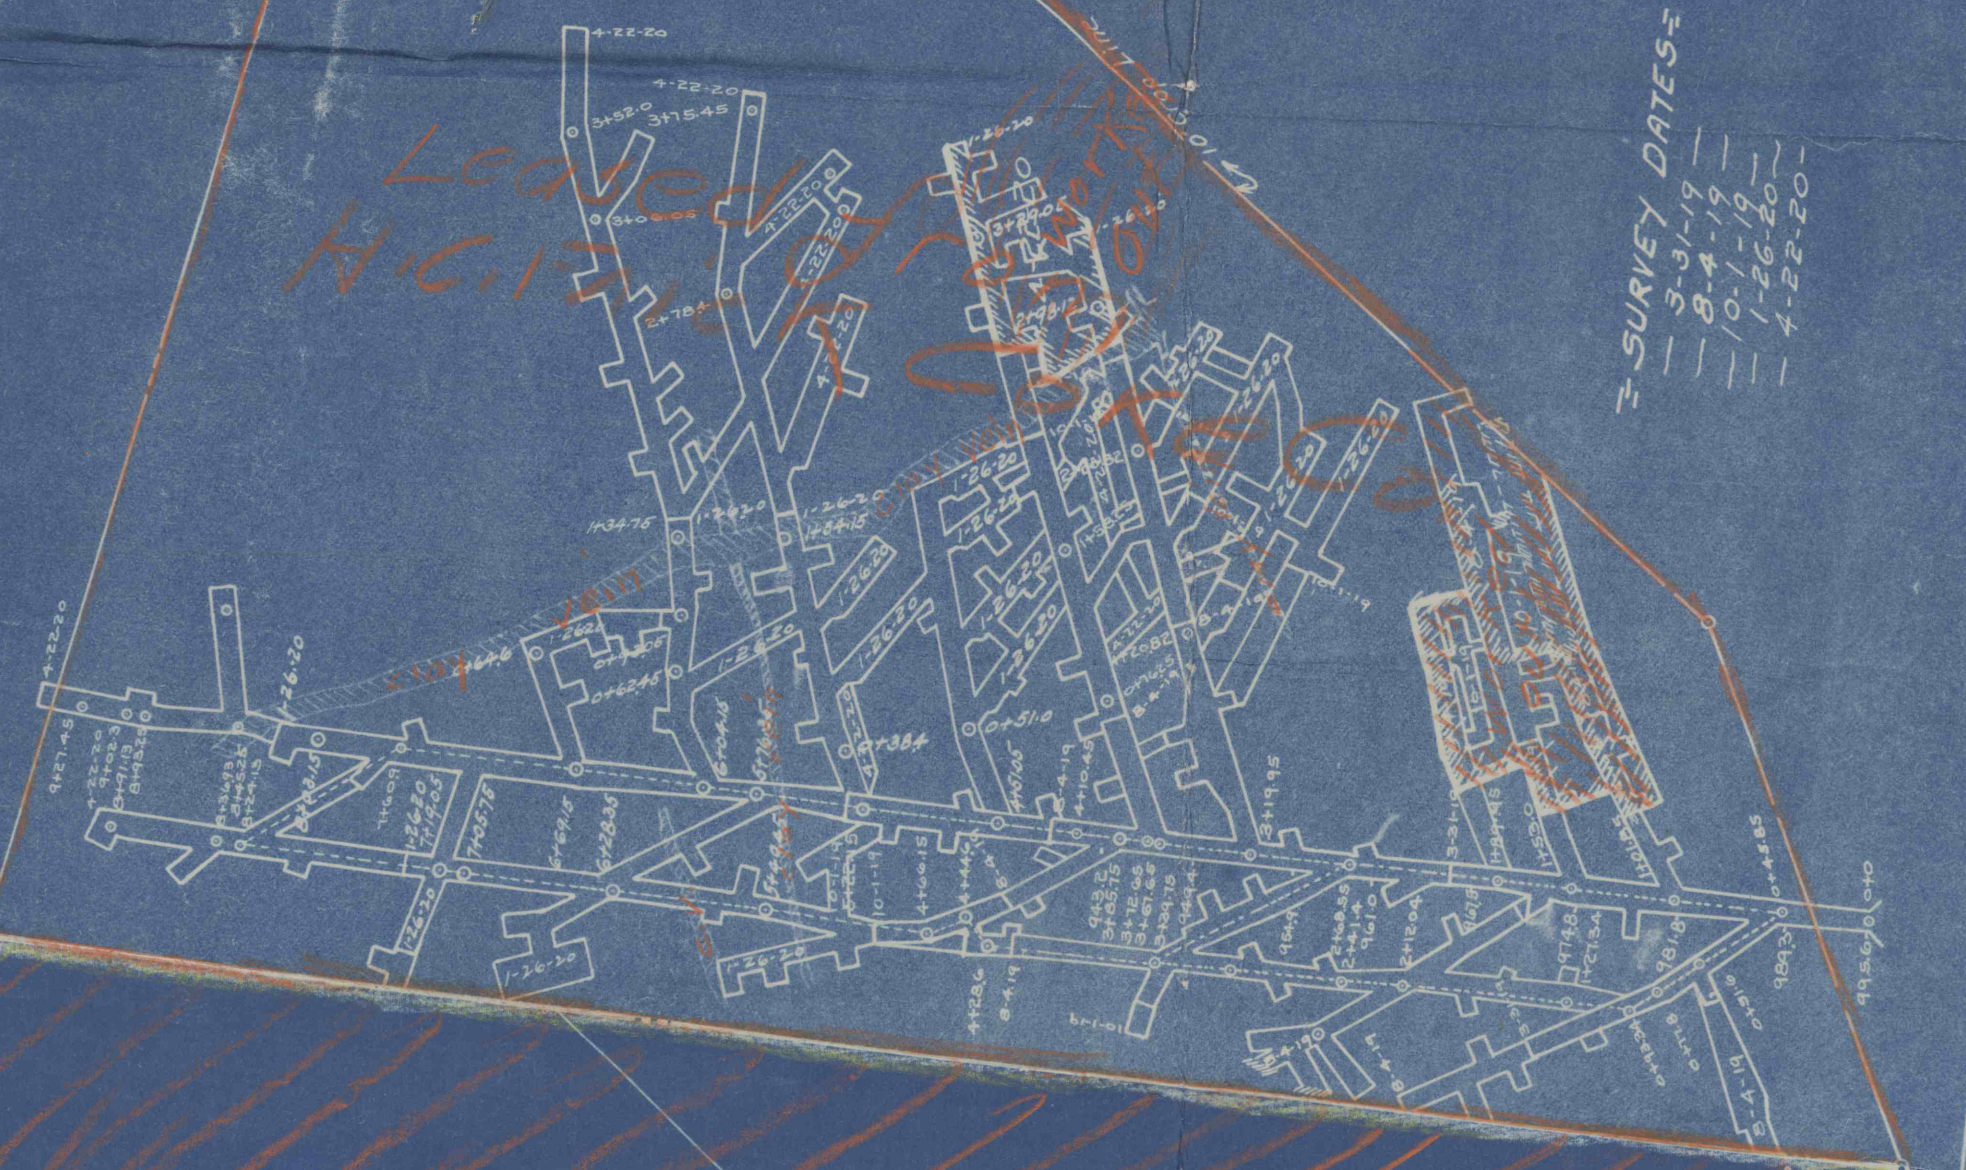

THIS AREA DEVELOPED BUT INACCESSIBLE

Lost Area

THIS AREA DEVELOPED BUT INACCESSIBLE

Lost Area
Pittsburg coal underlying this
tract owned by H.C. Frick Coke
Co. (Lemont Mine)

RESERVATION
3/4 ACRE

Leased from
Receivers of Hogsett C. & C. Co.

clay vein

SURVEY DATE
5-10-18

Sewickley Coal
Average height
5'-00"

MINE MAP
OF THE
FAITH COAL CO.
NORTH UNION TWP FAYETTE COUNTY, PA.
SCALE - 1"=100'
HOMER L. BURCHINAL, ENGR. UNIONTOWN, PA.
6-13-18