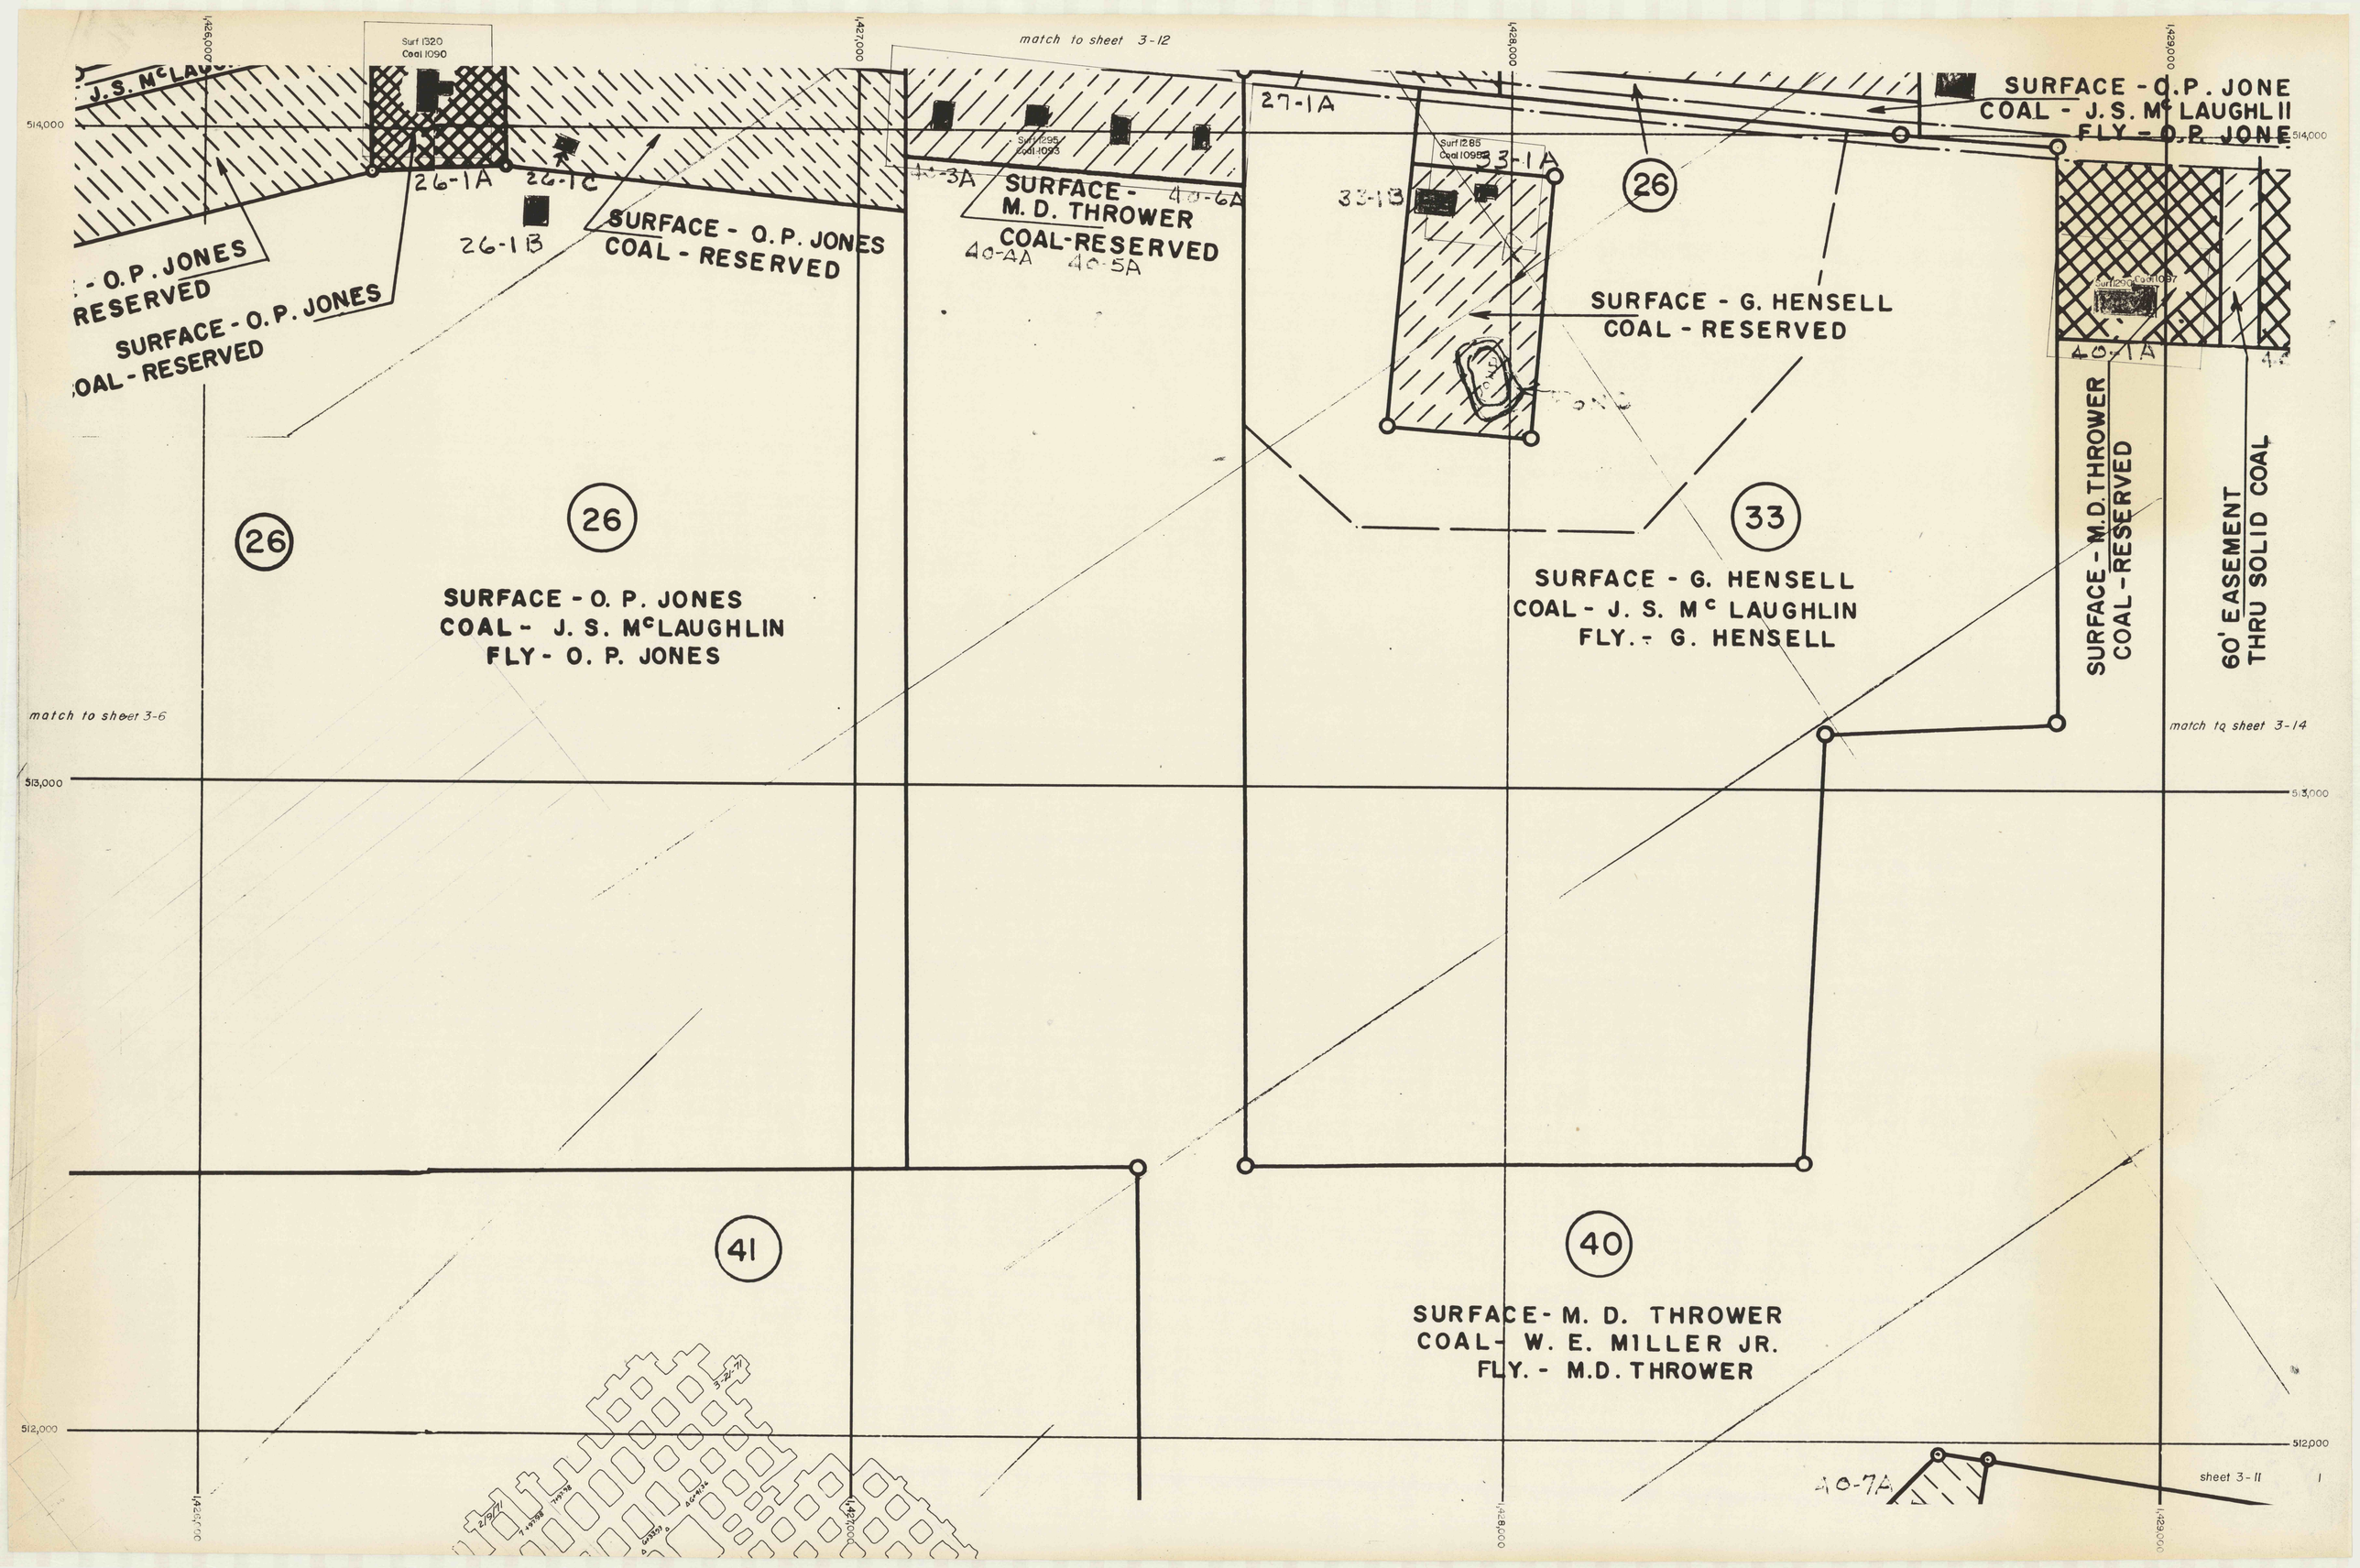

match to sheet 3-12
match to sheet 3-6
match to sheet 3-14
sheet 3-11
J.S. McLAUG
Surf 1320
Coal 1090
26-1A
26-1C
26-1B
SURFACE - O.P. JONES
COAL - RESERVED
- O.P. JONES
RESERVED
SURFACE - O.P. JONES
OAL - RESERVED
Surf 1295
Coal 1093
40-3A
40-6A
SURFACE -
M. D. THROWER
COAL-RESERVED
40-4A
40-5A
27-1A
Surf 1285
Coal 1095
33-1A
33-1B
26
SURFACE - G. HENSELL
COAL - RESERVED
SURFACE - O.P. JONE
COAL - J.S. McLAUGHLI
FLY - O.P. JONE
40-1A
SURFACE - M.D. THROWER
COAL - RESERVED
60' EASEMENT
THRU SOLID COAL
26
26
SURFACE - O. P. JONES
COAL - J. S. McLAUGHLIN
FLY - O. P. JONES
33
SURFACE - G. HENSELL
COAL - J. S. McLAUGHLIN
FLY. - G. HENSELL
41
40
SURFACE - M. D. THROWER
COAL - W. E. MILLER JR.
FLY. - M.D. THROWER
40-7A
514,000
513,000
512,000
1,426,000
1,427,000
1,428,000
1,429,000