

match to sheet 3-5

514,000

ROUTE T-566

D. WAGLI
DO NOT
OWN

E. DO

E.H. LANG
DO NOT OWN

SURFACE - C.A. BAUMAN
COAL - RESERVED

SURFACE - O.P. JON
COAL - RESERVED
SURFACE
COAL - RESEF

Surf 1315
Coal 1083

34-1

34-1P

34

30

FEE - W. E. MILLER JR.
FLY. - A. DAVIDEK

SURFACE - C.A. BAUMAN
COAL - W.E. MILLER JR.
FLY. - C.A. BAUMAN

10131

match to sheet 3-3

match to sheet 3-11

512,000

ROUTE - T 552


112

112

G.A. Walker

16 Ac

B.H.
110
C-1095

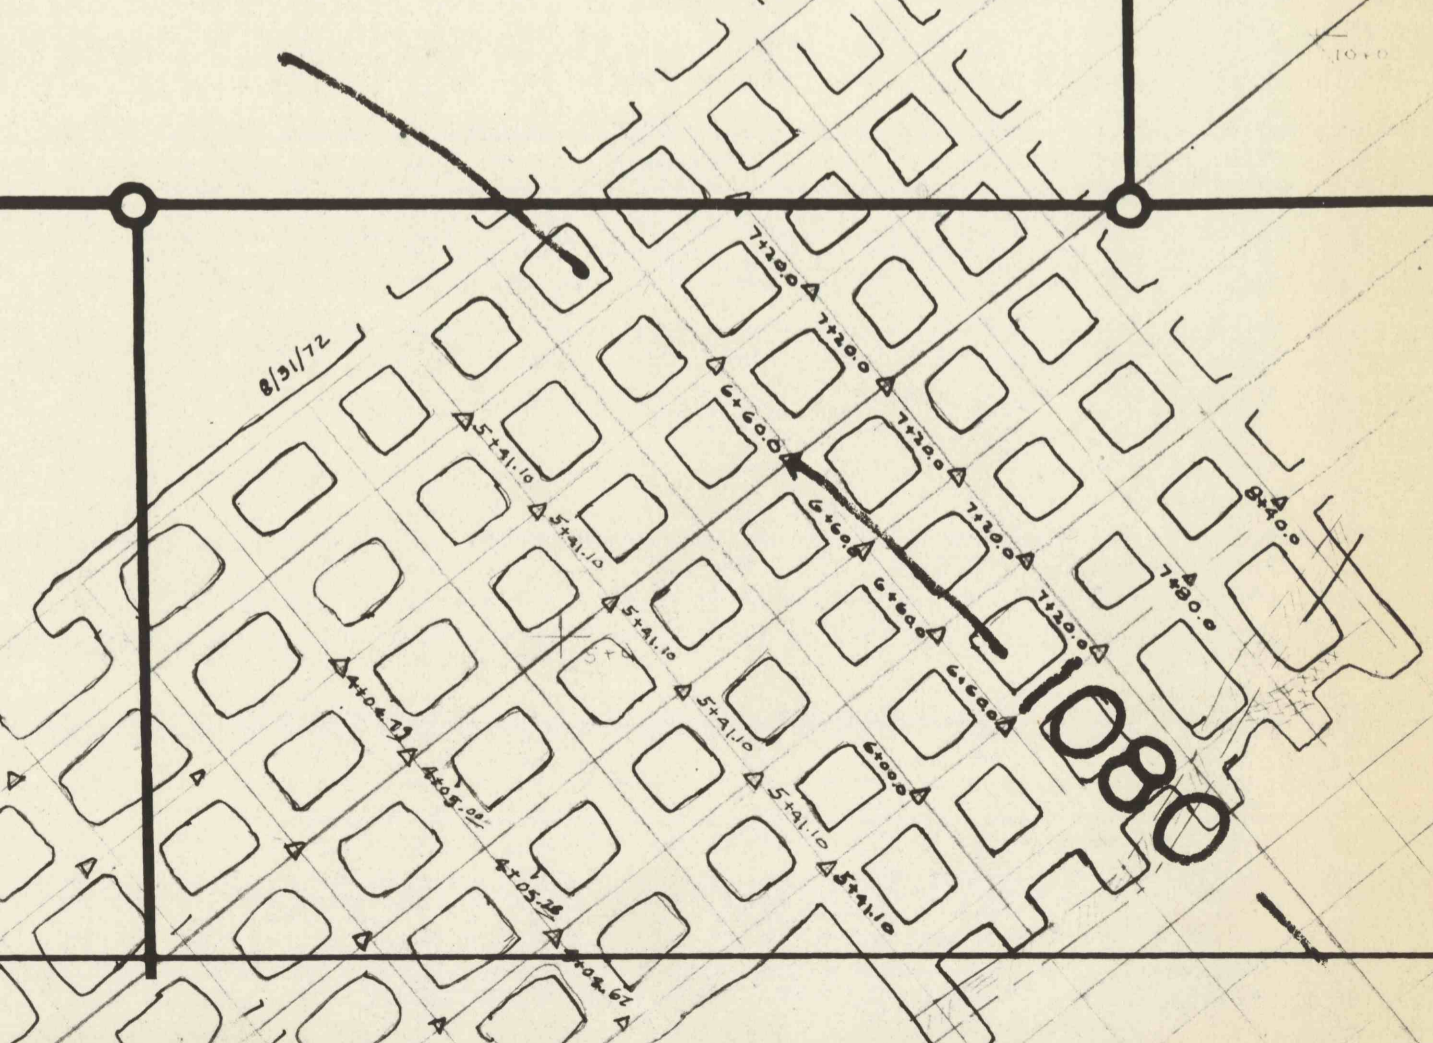

1080

match to sheet 3-7

512,000