

match to sheet 7-4

506,000

SURFACE - J. F. GOLDSCHMITZ
COAL - RESERVED




match to sheet 7-6

505,000



SURFACE - S.
COAL - W. E.
FLY. - S. A.

SURFACE - S. A. KLABNIK
COAL - RESERVED

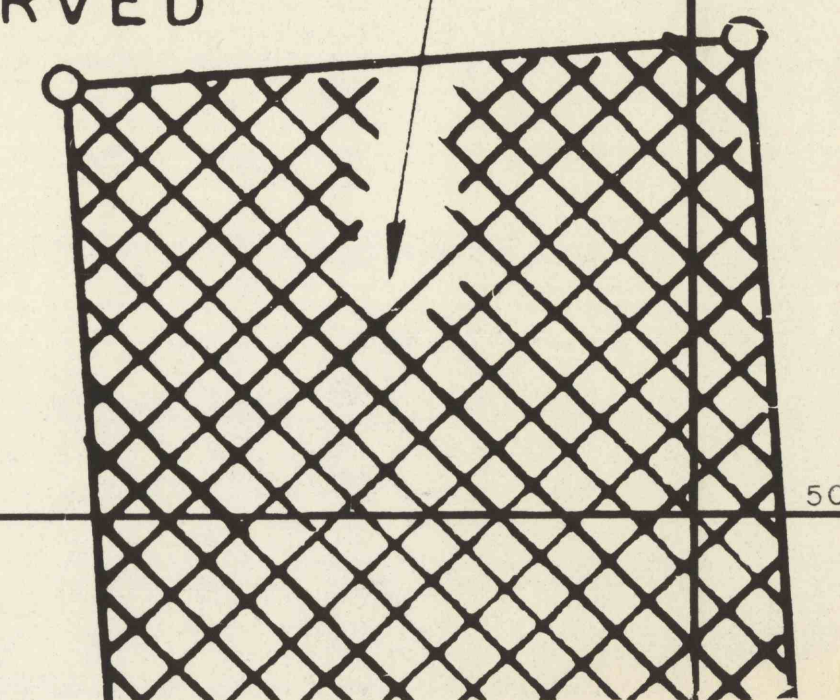


504,000

85

SURFACE - J. R. KLABNIK
COAL - W. E. MILLER JR
FLY. - J. R. KLABNIK

match to sheet 7-2

sheet 7-3

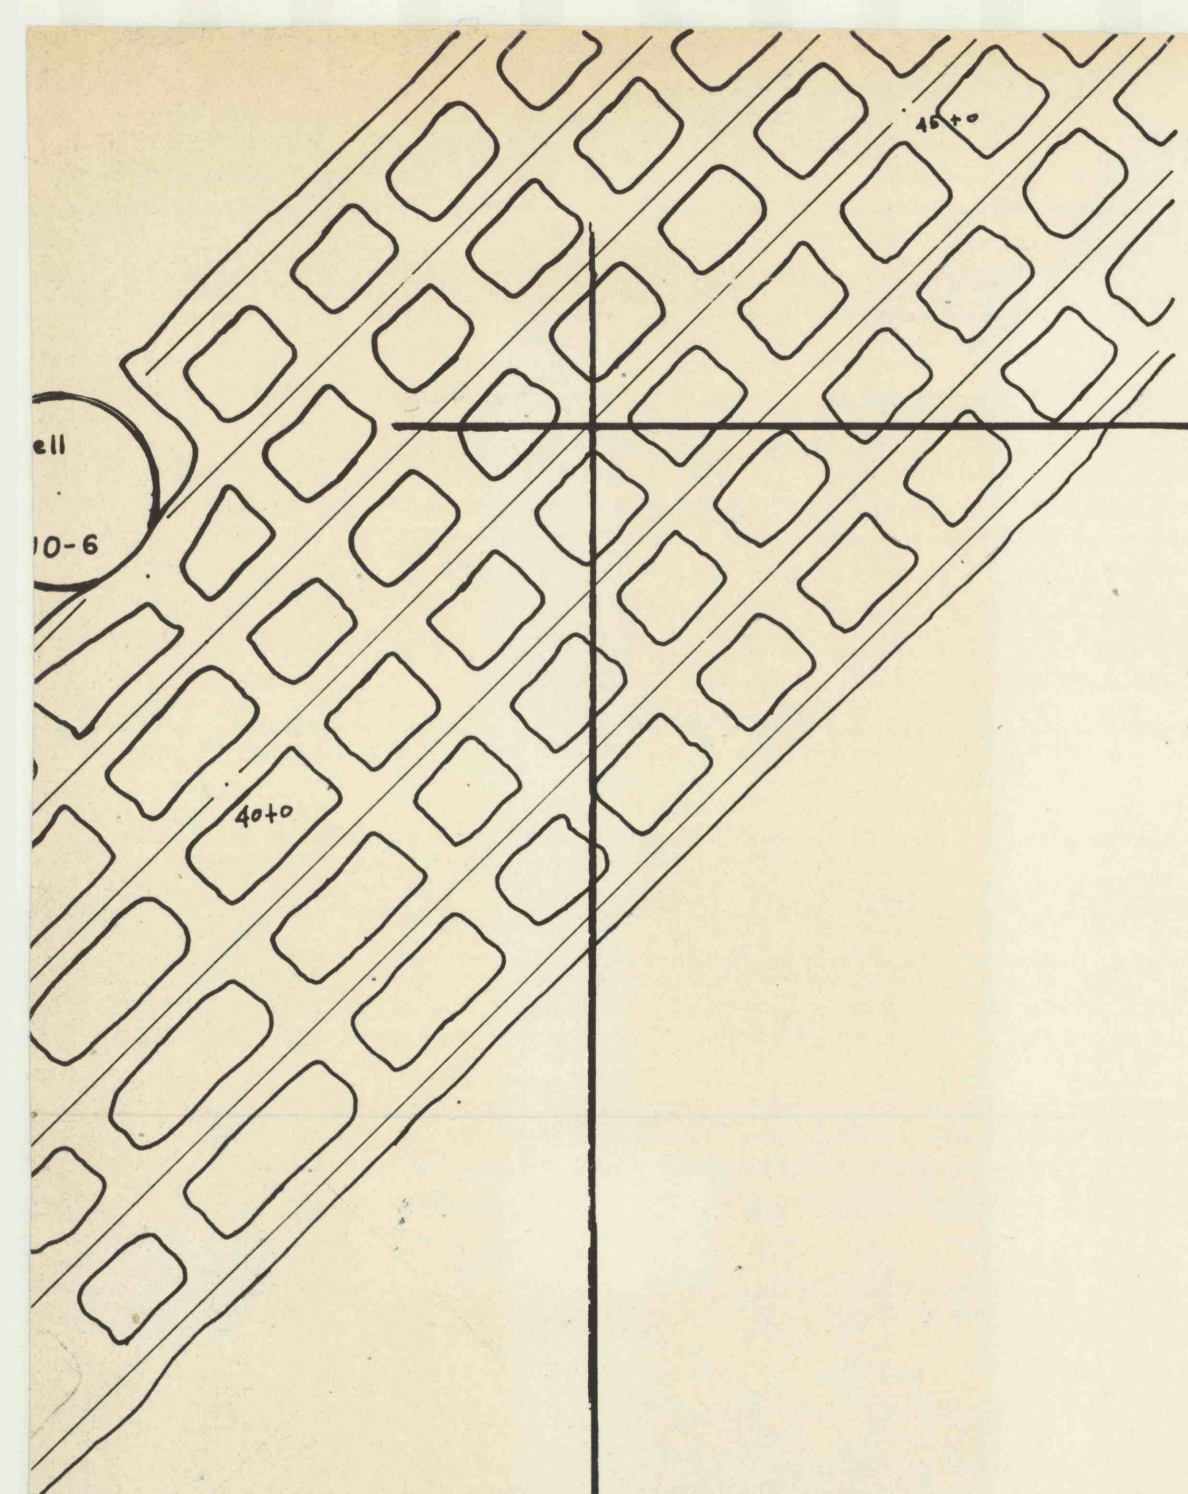

match to sheet 2-14

ITE
T-572

1,432,000

1,433,000

1,434,000