


**FAYE MINE**  
**EBERHART COAL CO.**  
 DUNKARD TWP. GREENE, CO. PA.  
 SCALE 1" = 100 FT. DATE 3-20-62  
 TO DATE 6-27-63  
 RAYMOND M. EBERHART JR. OPERATOR  
 ADDRESS SMITHFIELD, PA. R.D. 2 BOX 320

William A. Thistlethwaite  
 Registered Surveyor #7770E

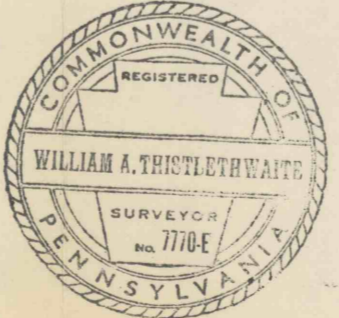

#977  
 7-16-99  
 C.C.