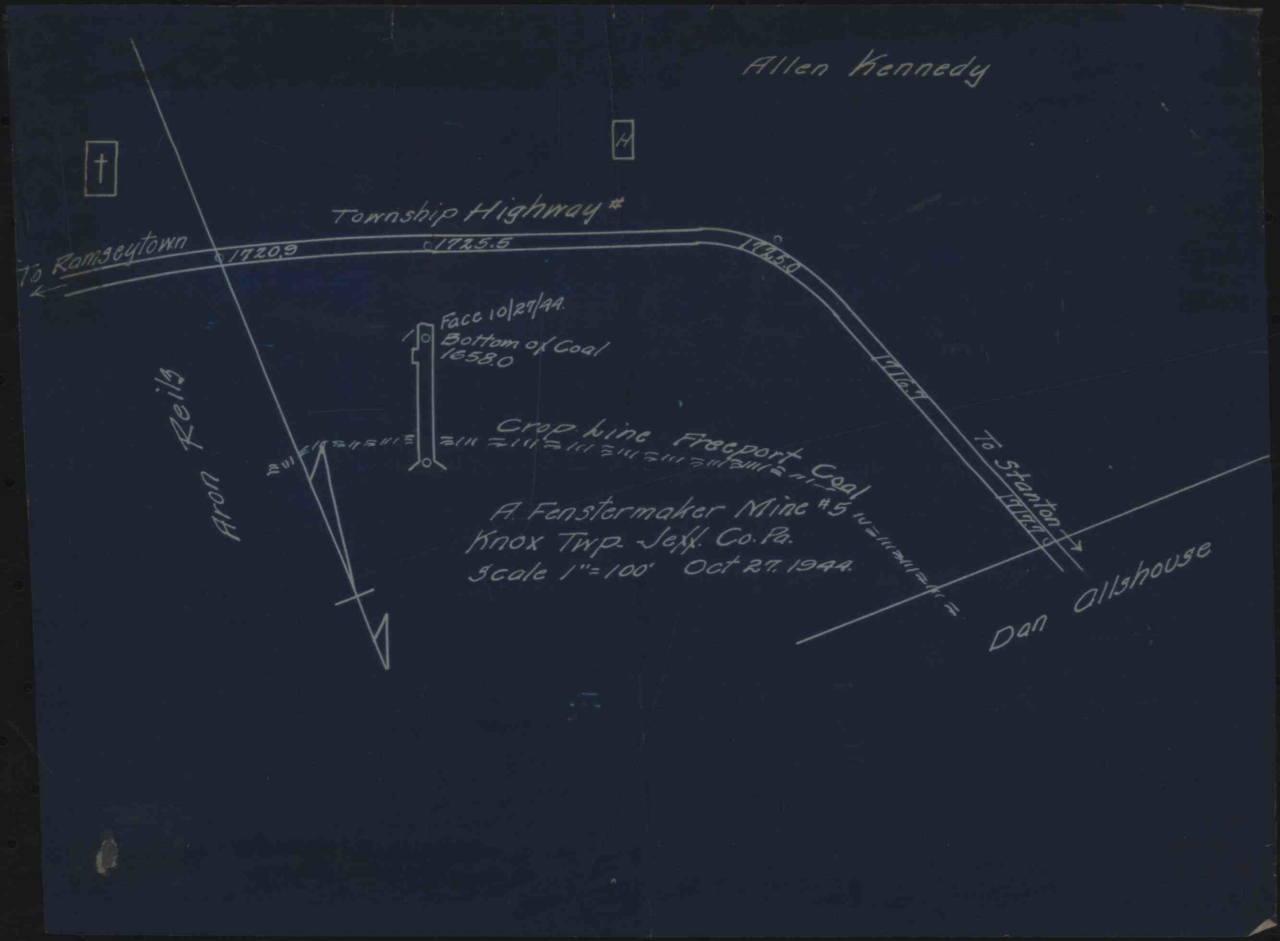
Allen Kennedy
Township Highway #
To Ramseytown
1720.9
1725.5
To Stanton
Face 10/27/44
Bottom of Coal
1658.0
Crop Mine Freeport Coal
A. Fenstermaker Mine #5
Knox Twp. Jeff. Co. Pa.
Scale 1"=100' Oct 27, 1944
Dan Allshouse