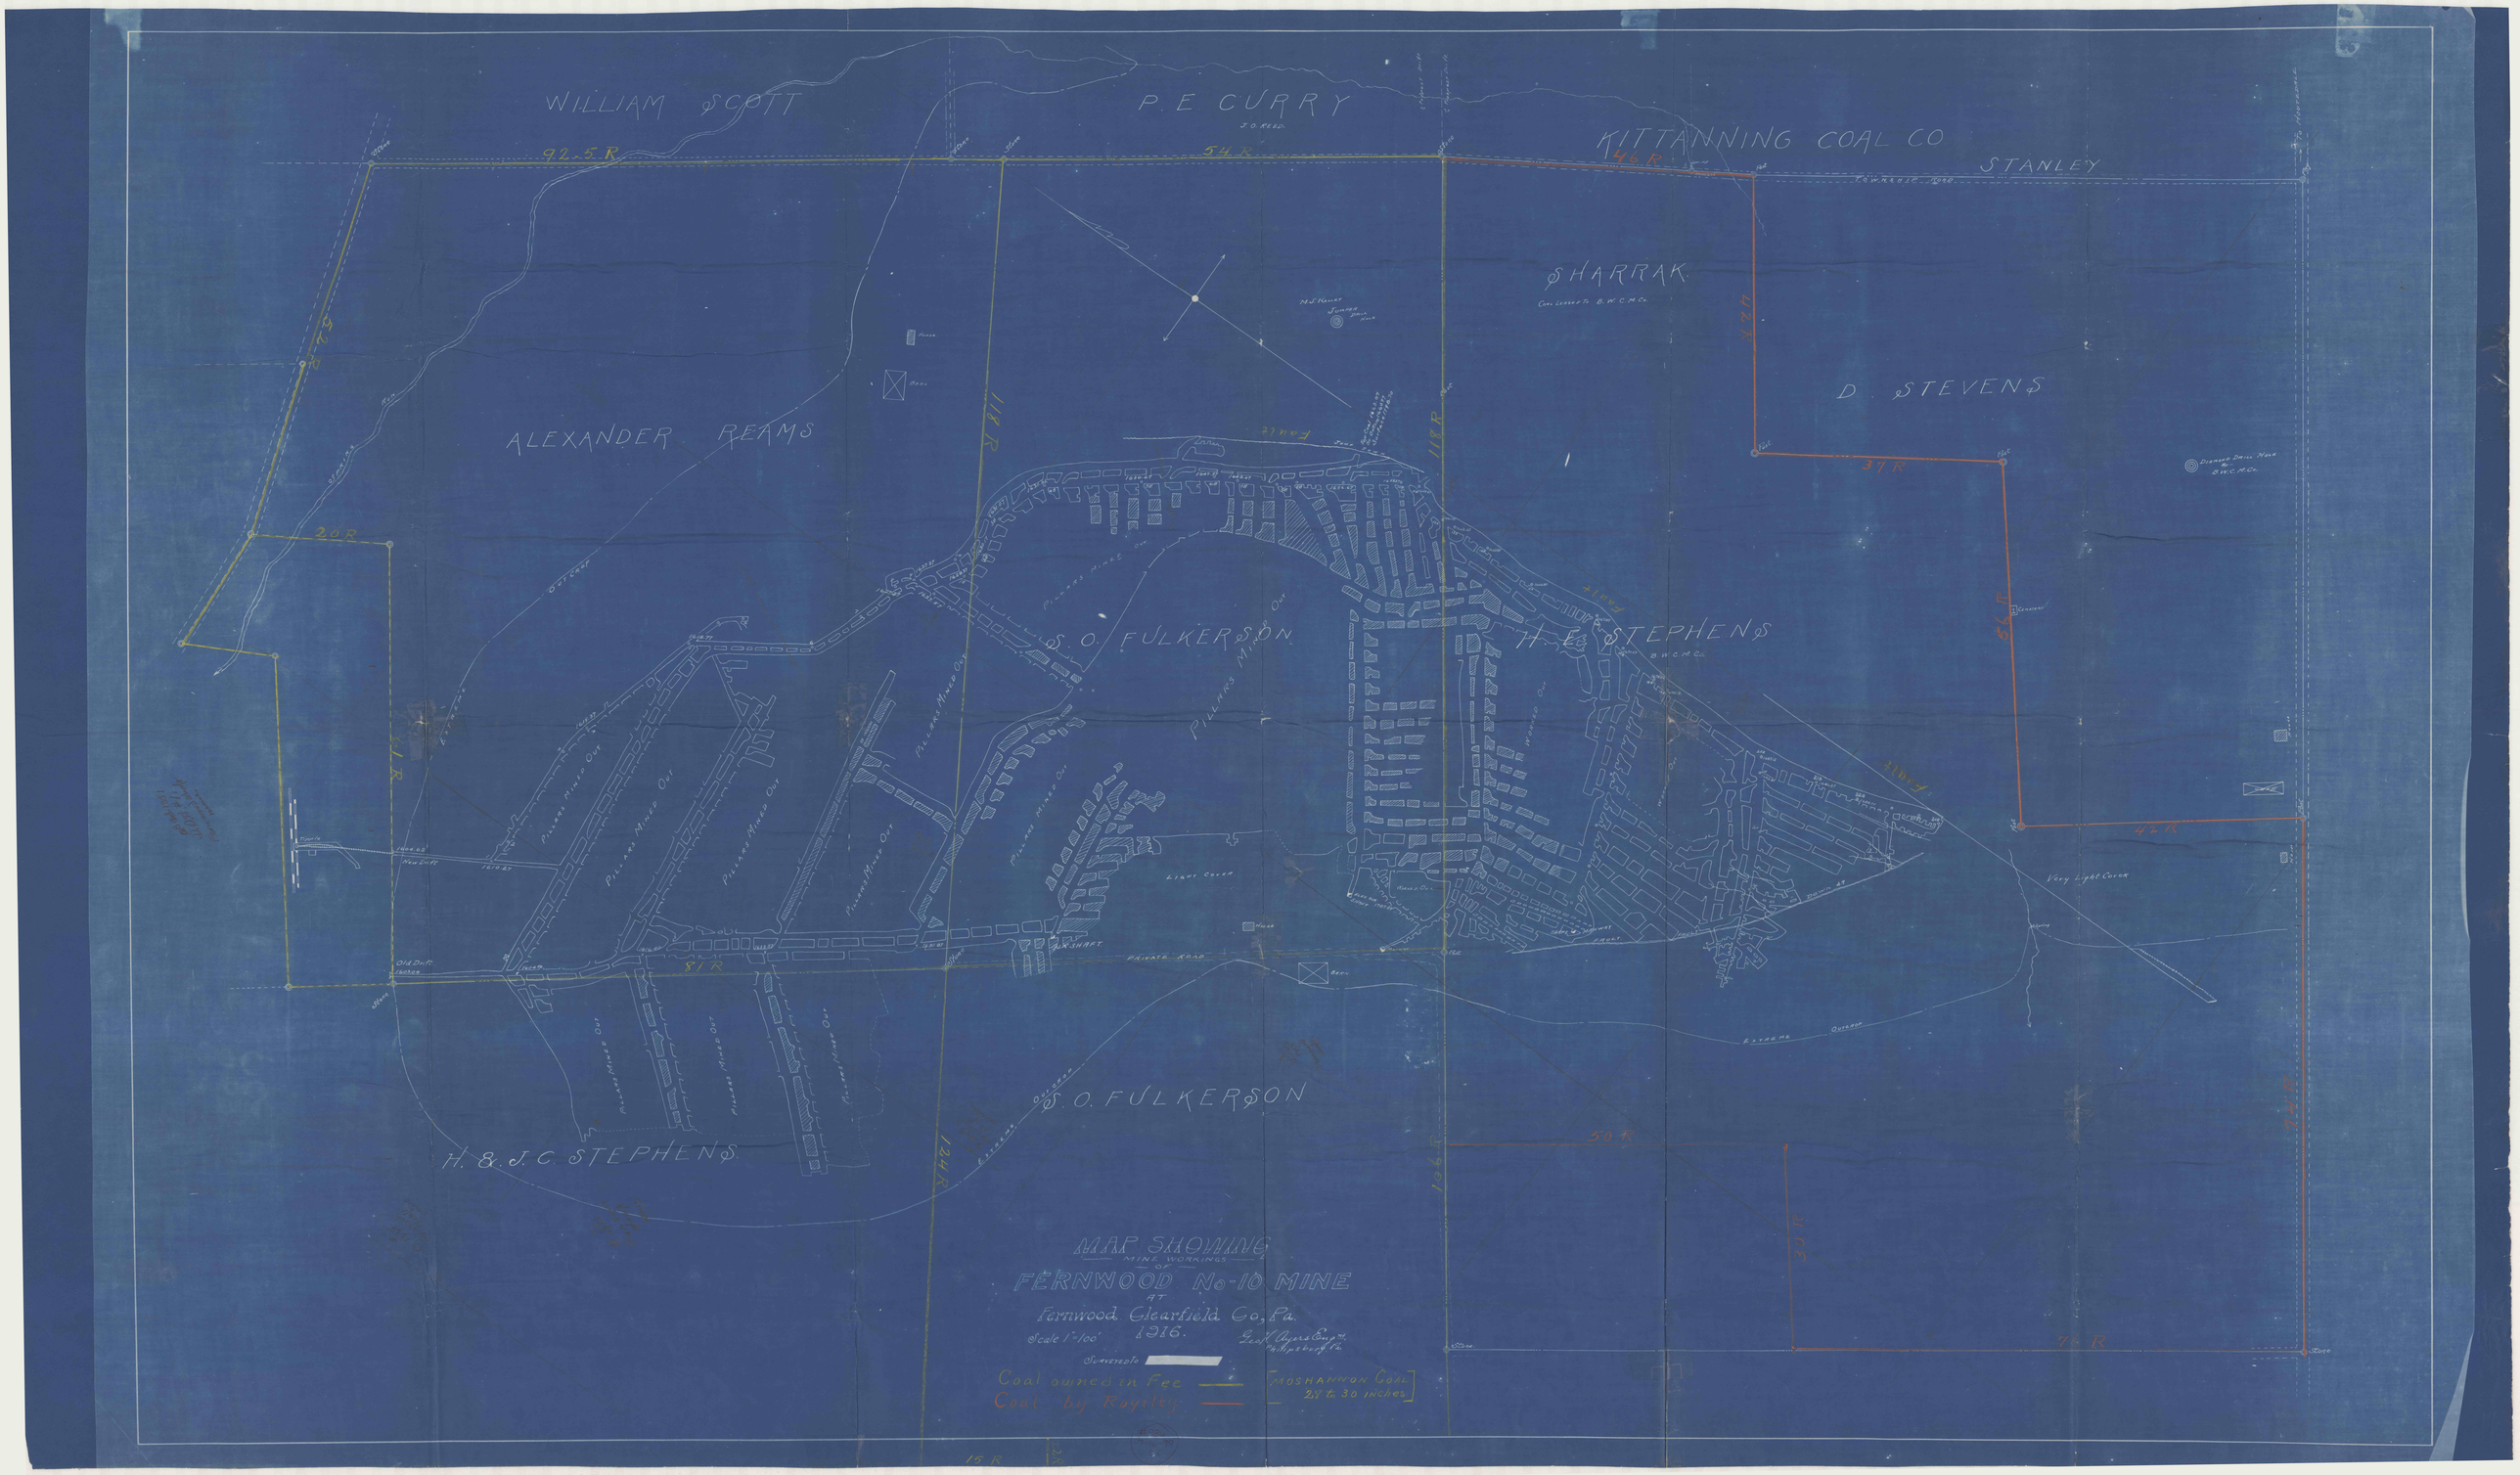
WILLIAM SCOTT
P. E. CURRY
KITTANNING COAL CO
STANLEY
SHARRAK
D. STEVENS
ALEXANDER REAMS
S. O. FULKERSON
H. E. STEPHENS
S. O. FULKERSON
H. & J. C. STEPHENS
92.5 R
54 R
46 R
42 R
37 R
56 R
42 R
20 R
118 R
118 R
81 R
124 R
50 R
30 R
76 R
Fault
Pillars Mined Out
Light Cover
Very Light Cover
Extreme Outcrop
Private Road
MAP SHOWING
MINE WORKINGS
OF
FERNWOOD No-10 MINE
AT
Fernwood Clearfield Co, Pa.
1916.
Scale 1"=100'
Surveyed to
Coal owned in Fee
Coal by Royalty
[MOSHANNON COAL 28 to 30 inches]