


MONONGAHELA RIVER.

VESTA COAL CO.

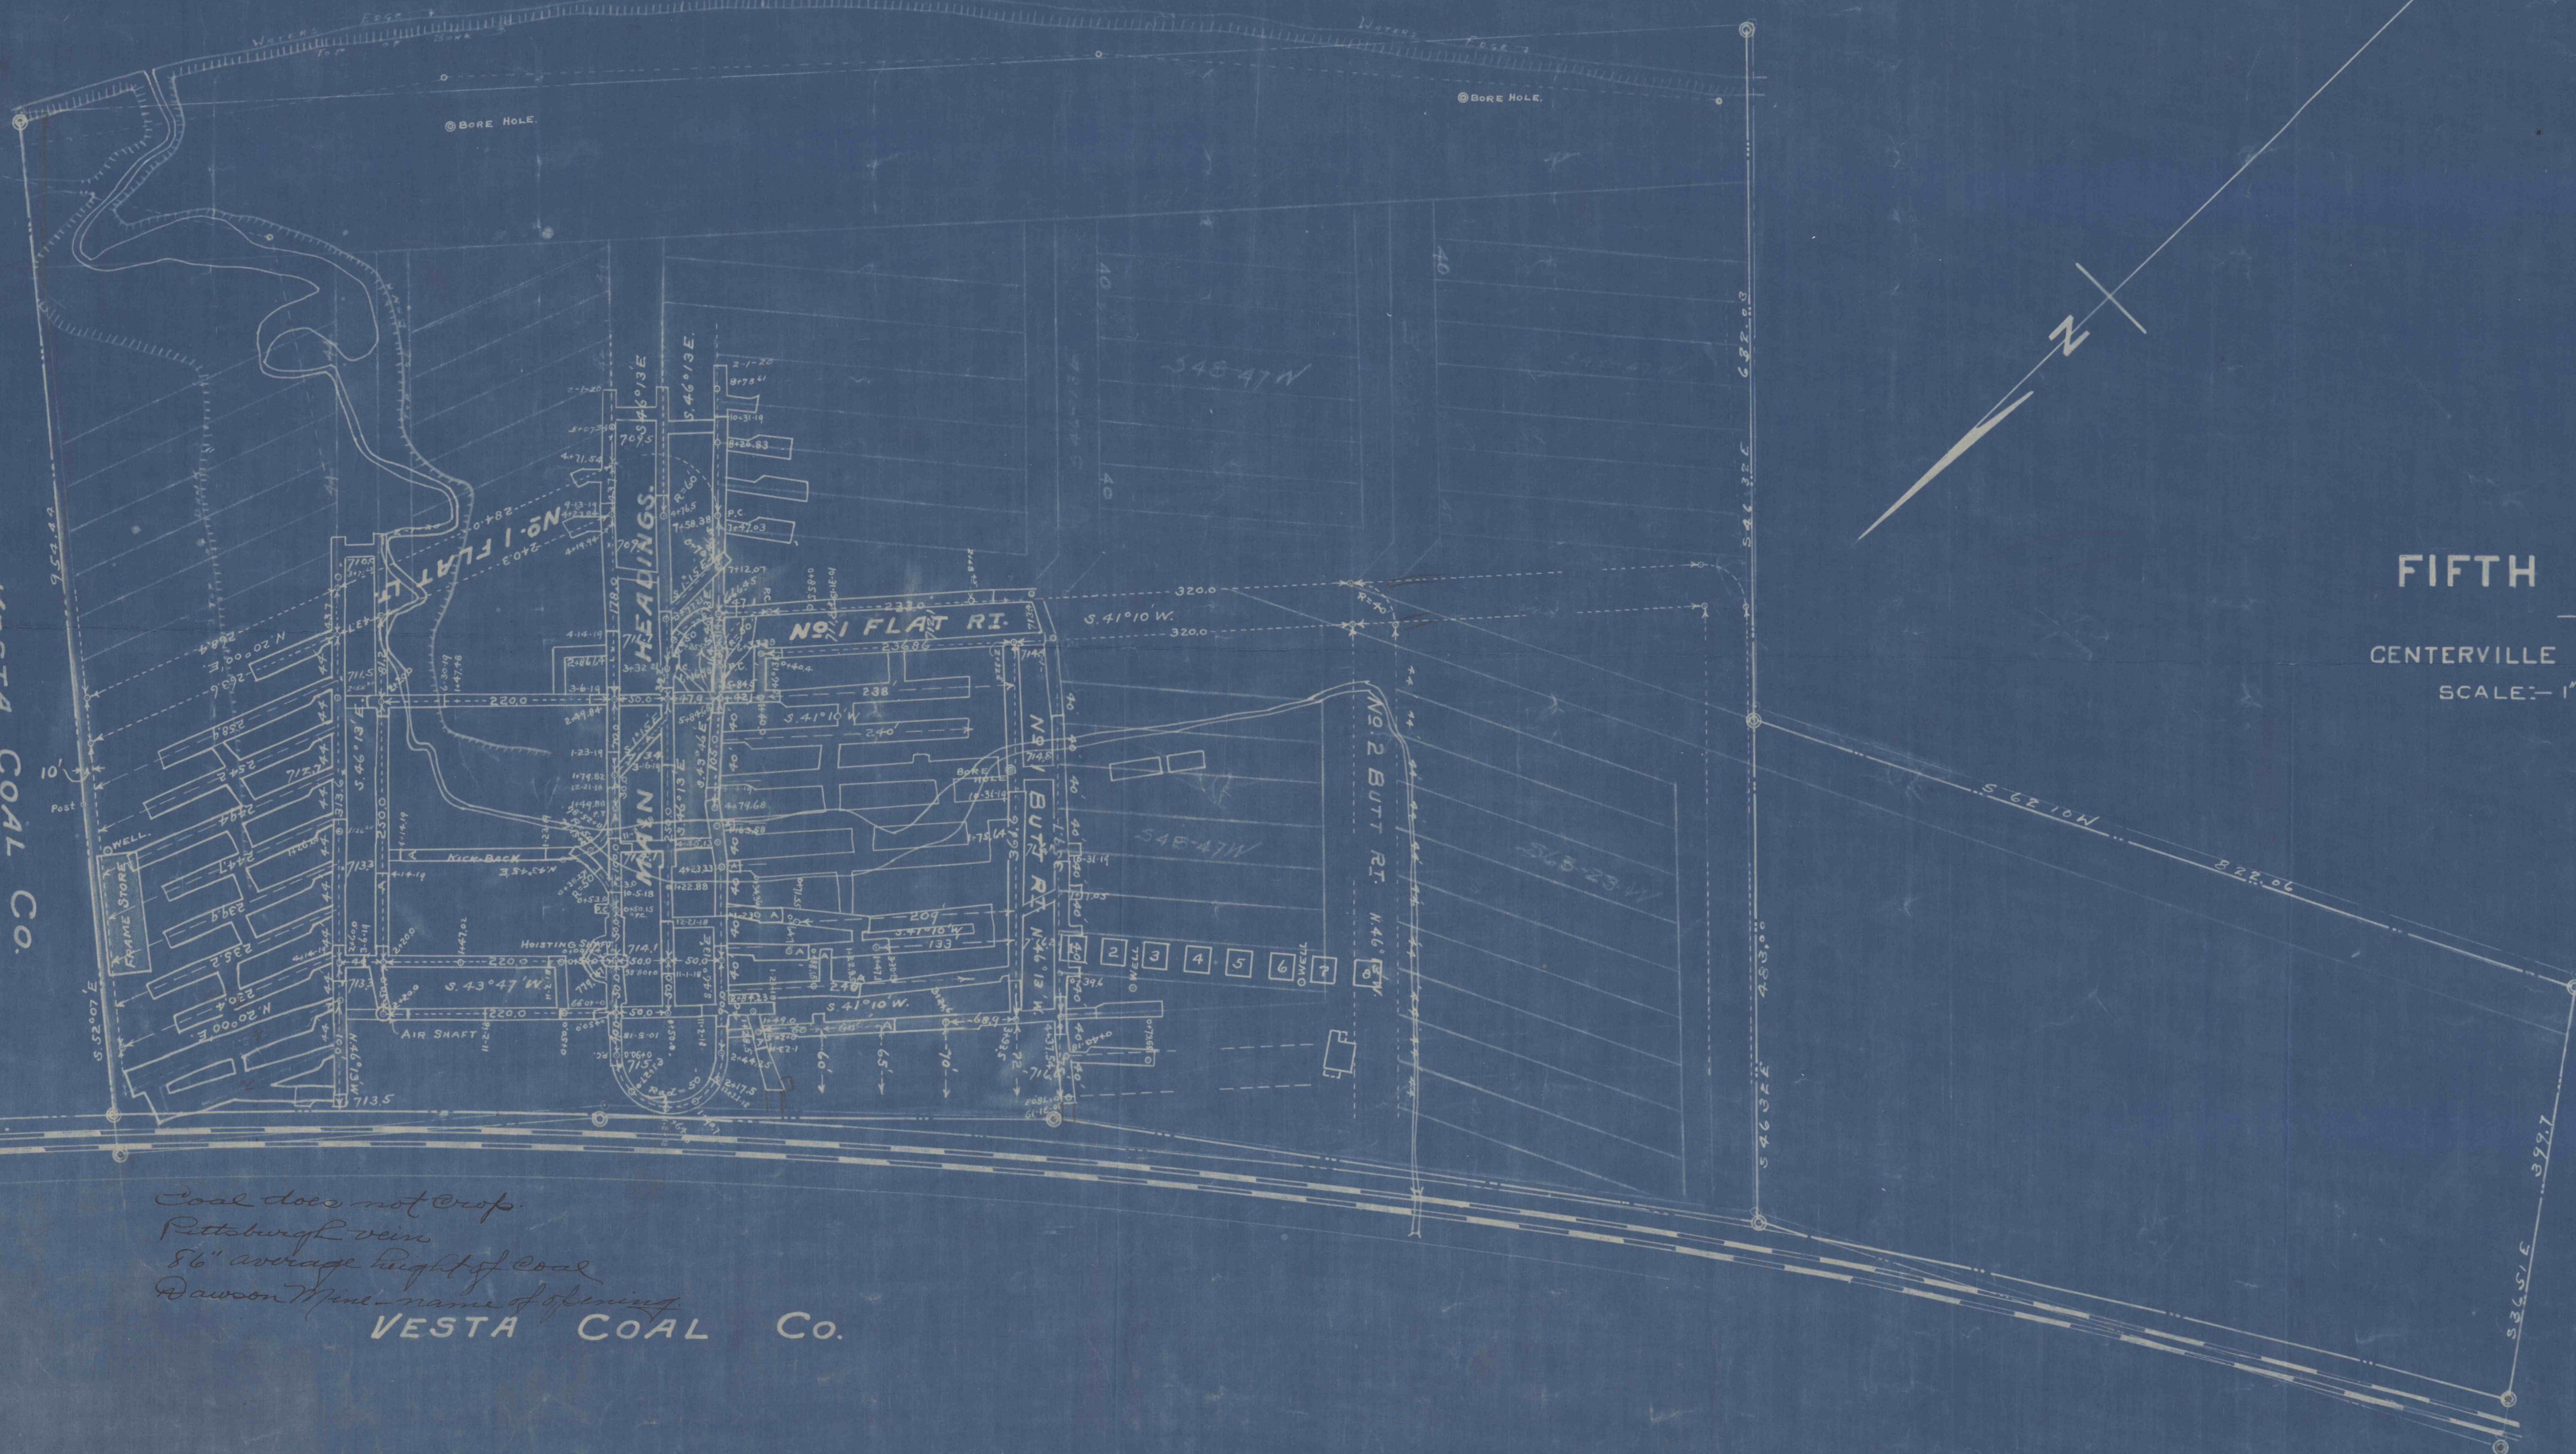

FIFTH POOL COAL CO.

SITUATE IN

CENTERVILLE TOWNSHIP, WASHINGTON CO., PA.

SCALE: 1"=100' + SEPT. 19, 1917.

F.C.O.

Coal does not crop  
 Pittsburgh vein  
 86" average height of coal  
 Dawson Mine - name of opening  
**VESTA COAL Co.**

#989  
 7-16-99  
 C.C.