



- Area Worked To July 1, 1972
 - Area To Work To Jan 1973
 [Orange Box] Face of Workings Feb. 24, 1973

E Corrie July-1972


323287

File C-4

2/24/74

Map of M & I Intyre Property Bound Top Trip Rockhill Co. Pa
 1"=100' E.C.M.

Sam Barnett Mine
 FIGARD #3 MINE

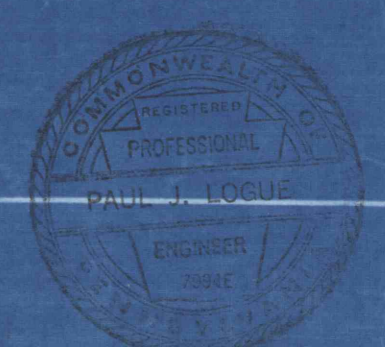

#99
 7-19-49
 CC